


INVENTORY OF PAVEMENT SURFACE CONDITION Date: 10-25-95 Km. 1367 + 000 Sheet No:2/2 **P** 350 4.50

(Sales)


4.00

(22)

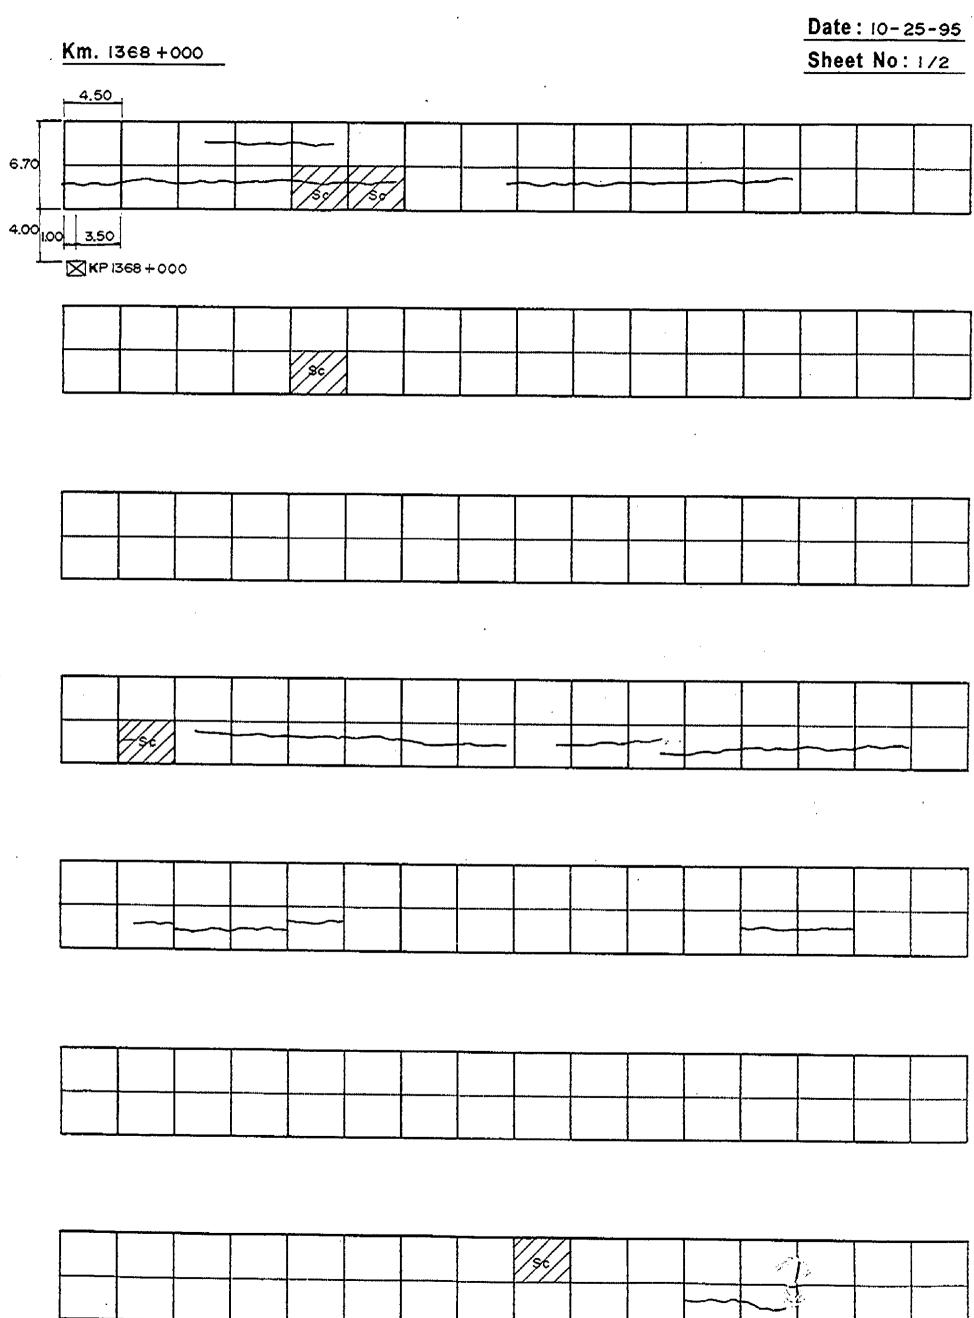


The state of the s

Km. 1368+000	_										Date	: 10-2 t No:	25-95 2/2
									· · · · · · · · · · · · · · · · · · ·				
				•	<u> </u>	1	<b></b>					I	.ii
		/3¢/	189										
									***************************************				
												•	
				7	D9			·					
				<b></b>	00 \	***************************************							250
										7	-		
							}						77777
													/39/
	1.80										·		
					·								
SE													
	1					<del>,</del>							
4.50													
3.3	5												
1.60 2.90 3.5 KP1369 +													المستسين معيف

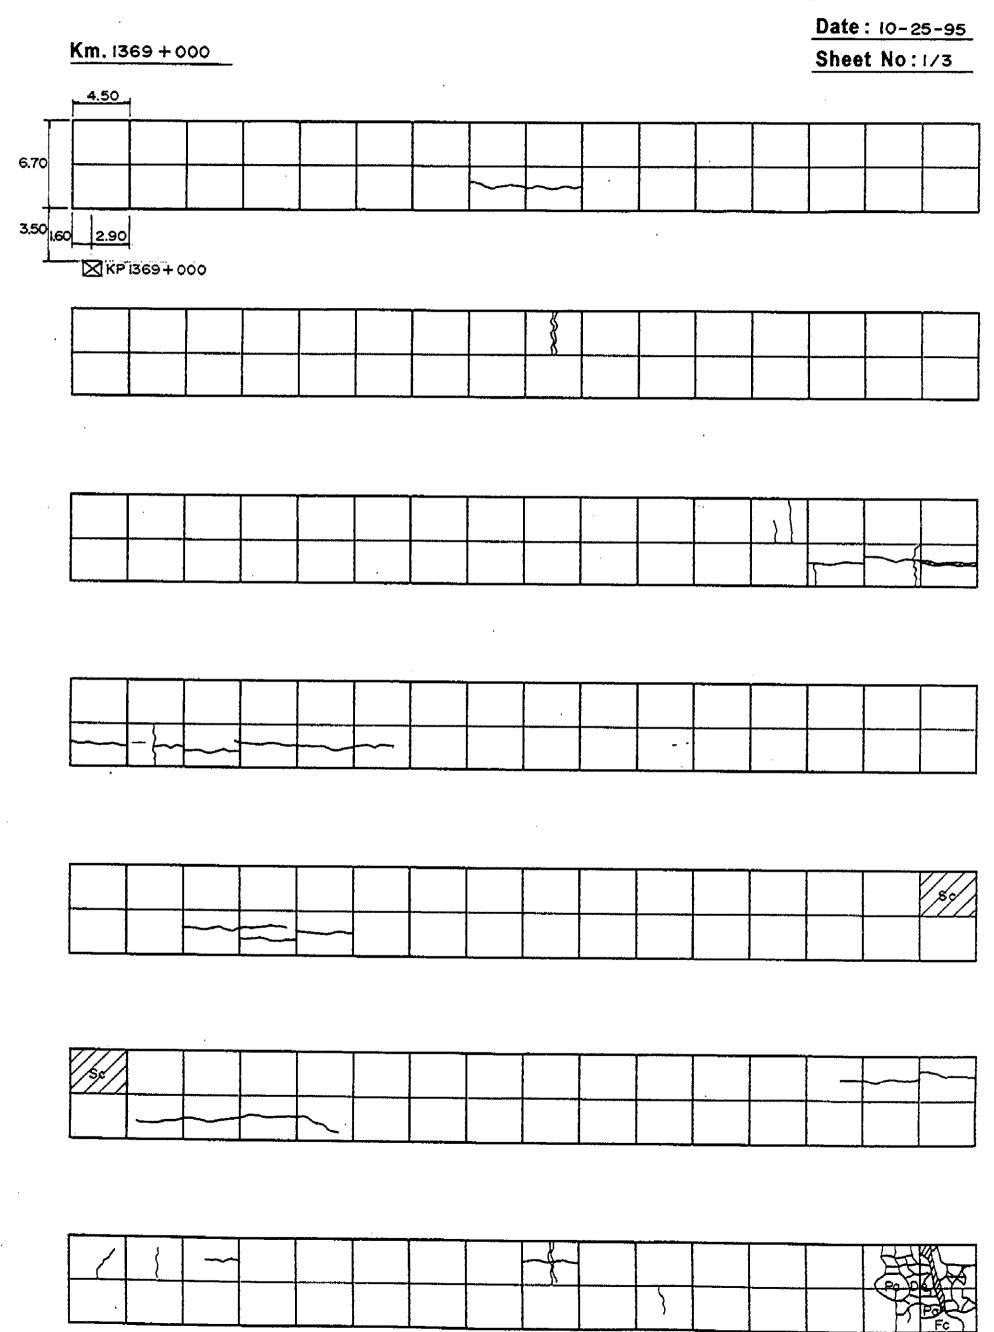

Date: 10-25-95 Km. 1369 + 000 Sheet No: 2/3 7085

<b>V</b>									,					: 10-2	
<u>Km. 13</u>	69 + 0	000						•					Shee	t No:	3/3
					4.50	†									
						6.70									
			•	0.65	3.85	3.45	<u> </u>	1	1	<u> </u>		<u></u>			<u> </u>
					× KPI	370+00	0								
		<u> </u>								1					<u></u>
				,	ļ <u></u>										
L	<u> </u>	<u> </u>	<u> </u>	<u> </u>		1			<u> </u>						
											•				
	1	T	1	1		}		T			10	<u> </u>	1		<u> </u>
		<u> </u>													
					<u>.                                    </u>			· :	·						
		******			·	<u> </u>				<u>.</u>	1_	l	<u> </u>		<u> </u>
					<b>.</b>										
						·							•		
		<u> </u>		l	· · · · · · · · · · · · · · · · · · ·										
	τ	Υ	<u></u>		T	,	<del>,</del>	·	<b></b>						
													~		
					•										
														-,	

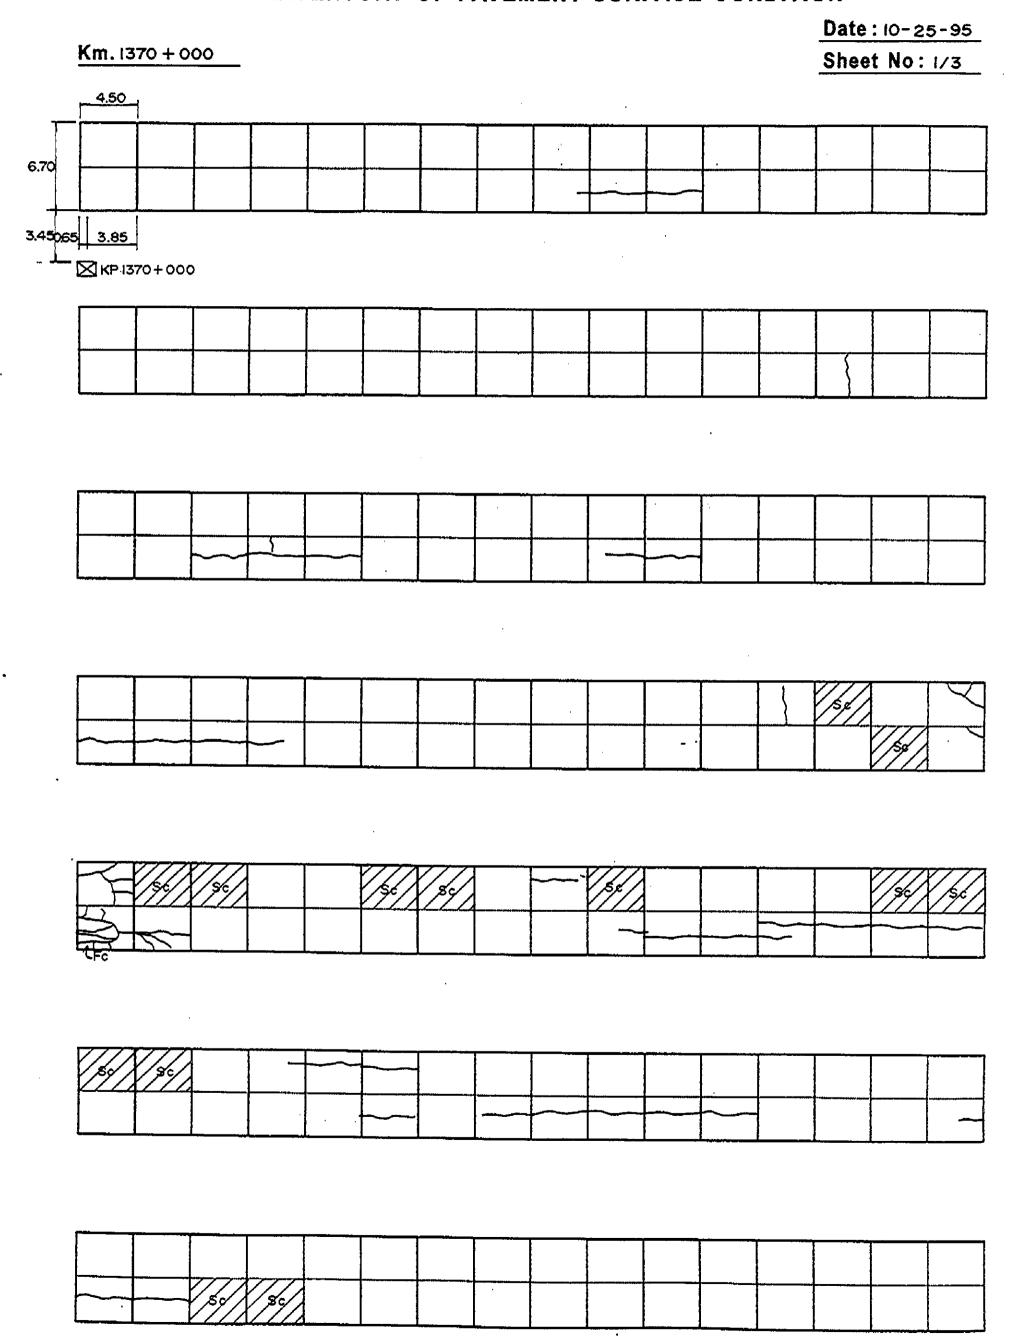

440

4

Date: 10-25-95

(m. 1370	+00	00											t No:	2/3
/ <u>\$</u>	<b>s</b> c/									·		F		
											,			
				150							• • • • • • • • • • • • • • • • • • • •			
				//%/										
														ı
	•					[2]								
									B.~			<b>X</b>	Ph	<b>-</b>
								`						
Fc	Fc	Fc		<							<del></del>			
						· · · · · · · · · · · · · · · · · · ·	,							
		·			•			•						
									//3//				<u> </u>	<u> </u>
	_													
			•							, i				
	Ţ													
			Den			(0	De							
				_ <b></b>				<del> </del>						
	-						<del></del>	 						<del></del>
		200	2											

Km. t	370+	000												: 10-2	
			_4.50_	_1									Snee	t No:	3/3
		1			_			]							<u> </u>
				6.	74	······································									
		<u></u>	3.10 40	2.	 70		<u> </u>	<u> </u>	<u> </u>	<u> </u>			<u> </u>	<u> </u>	<u> </u>
				KP137		000									
	1												-		*
	· · · · · · · · · · · · · · · · · · ·	<b>\</b>	<b>7</b>												
		·		<b>.</b>											
							-								
											•				
									,						
												 <u> </u>			
			_											·	
·			,												
				· <del></del>									·	·	<u>.</u>
	•	<b>.</b>													
		}	}												

-


(

Date: 10-25-95 Km. 1371+000 Sheet No: 1/3 6.74 2.70 3.10 1.40 KP 1371 + 000 130 De De VI De TIVE Del 11 90 Fc Po Fc' De Y

Date: 10-25-95 Km. 1371 + 000 Sheet No: 2/3 Pa W/Sc Pa W/ Sc Sc w/De-Series of Cracks De

<b>Km</b>	371+0	00													: 10-7	
1211111	31170							,						Shee	t No:	3/3
7777	<del>,,,,,</del>	4.50	Ţ			·	···	•	·	<del></del>	··	•		•		<b></b>
				0.00												
\$	0.6	3.90	3.60	>		<u> </u>	•		<del></del>	<u></u>		•	<u>.                                    </u>	<u></u>	<del></del>	
			372+	-000	•											
									·							
						^	•		·	· ·	,		·	4		
	•															
												÷	<u> </u>			
													•		<del></del>	
	J	l	<u> </u>		•	<u> </u>		<u> </u>		1	<u> </u>				<u> </u>	
		}		·:						,						
	<u> </u>	<u> </u>								<u> </u>						
							]						<u></u>			
			_													
<u> </u>	<u> </u>				·	<u> </u>					<u> </u>				<u> </u>	<u> </u>
											<u> </u>					
			***************************************													
L	1		<u> </u>			<u>                                     </u>							<u> </u>			
													<b></b>			

Date: 10-26-95 Km. 1372+000 Sheet No: 1/2 6.68 3.60 KP 1372+000 2.80

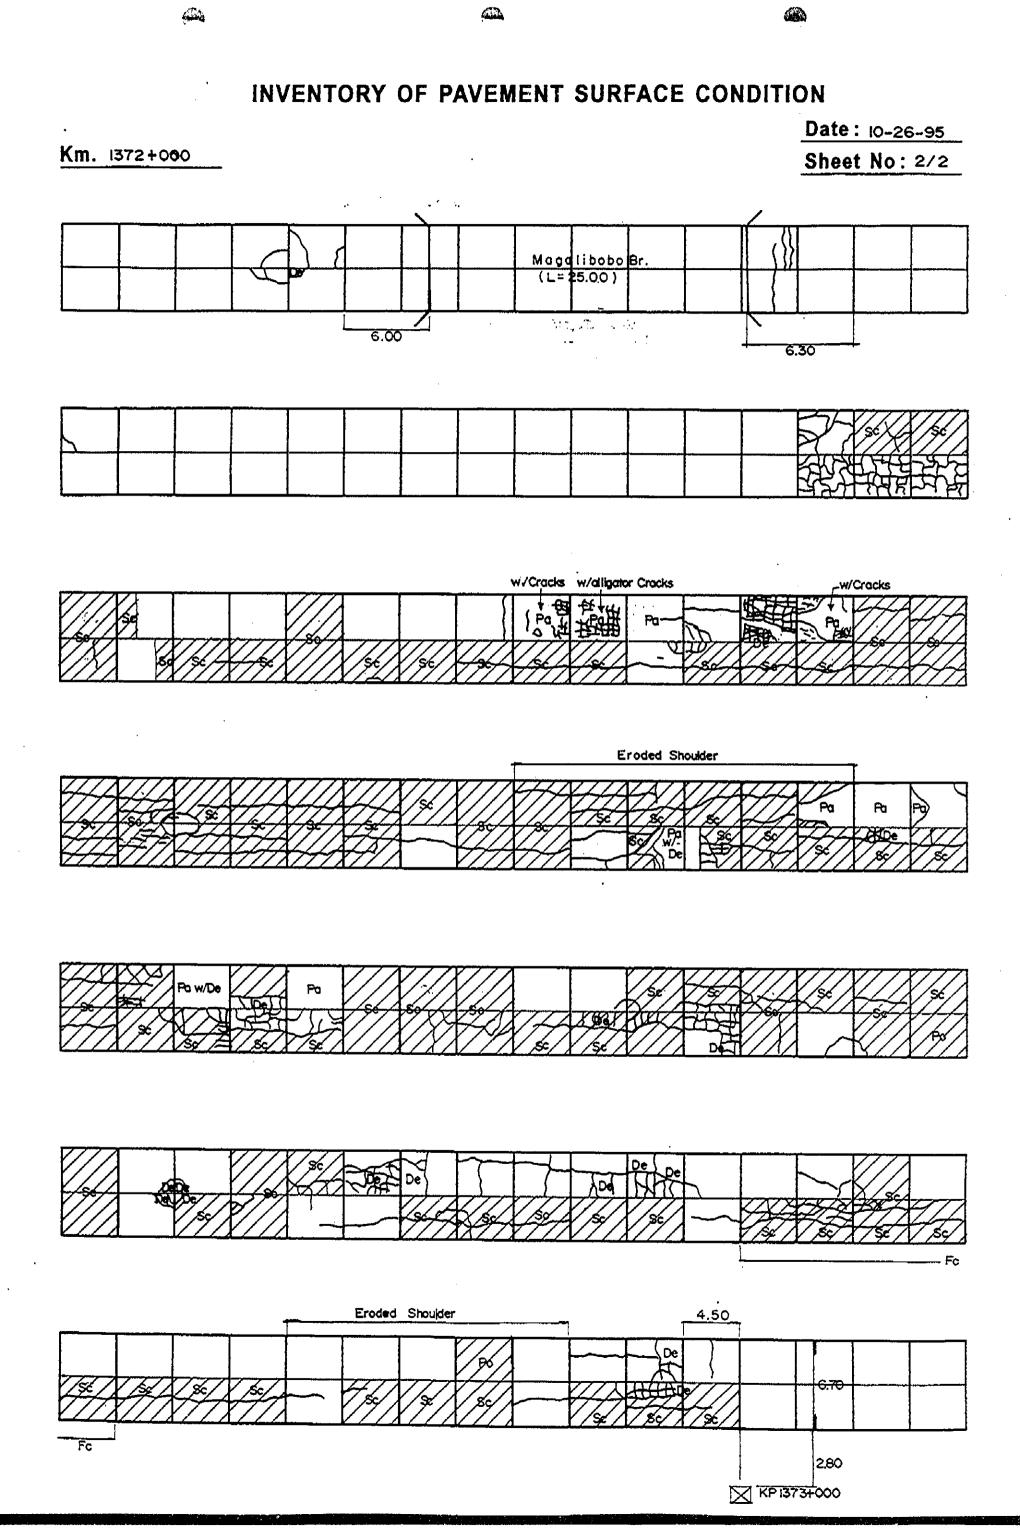


Date: 10-26-95 Km. 1373+000 & 1374+000 Sheet No: 1/4 6.70 Fc 2.80 KP1373+000 De 1 64 4 1 96 14

Km. 1373+000-8-1374+000


Date: 10-26-95


Sheet No: 2/4

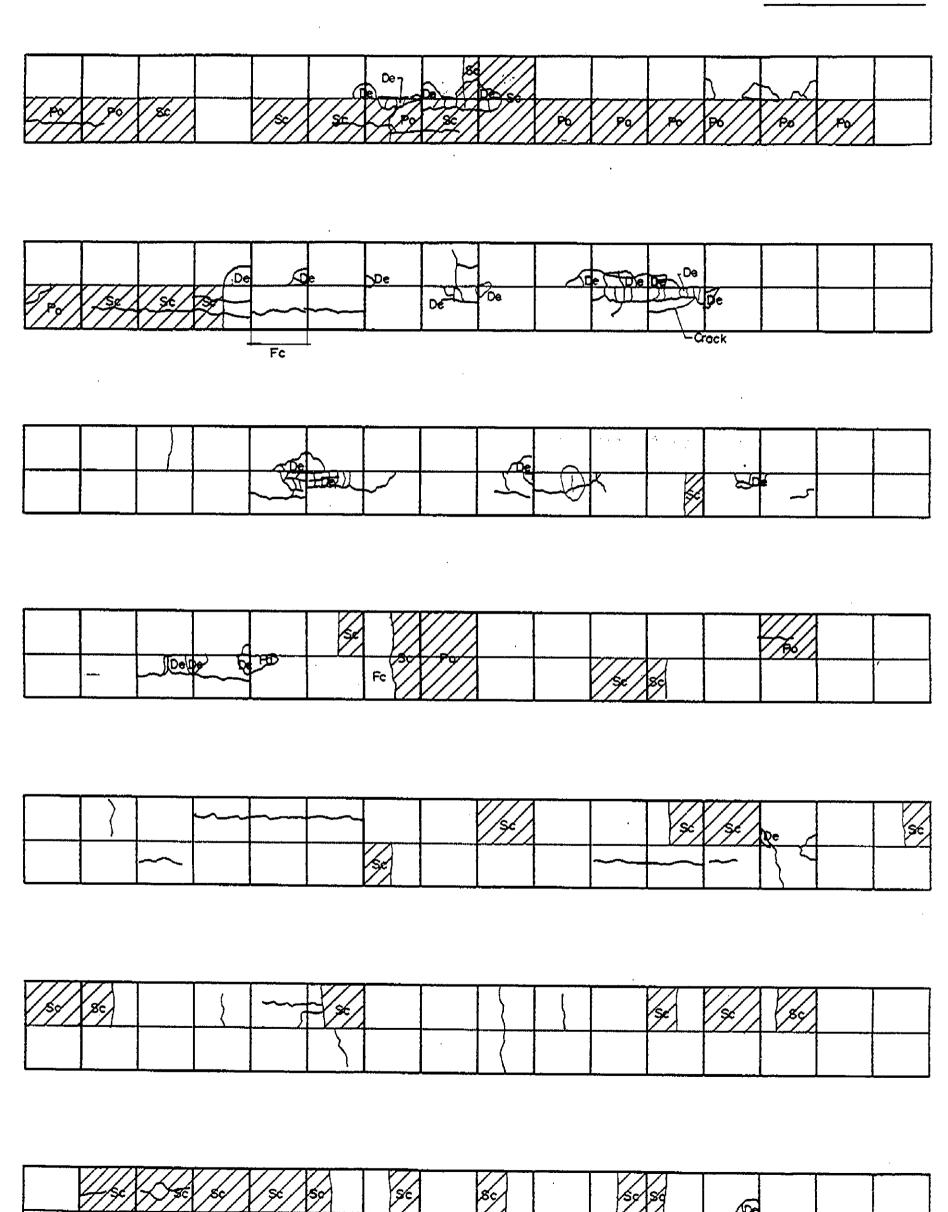

Date: 10-26-95

Sheet No: 3/4

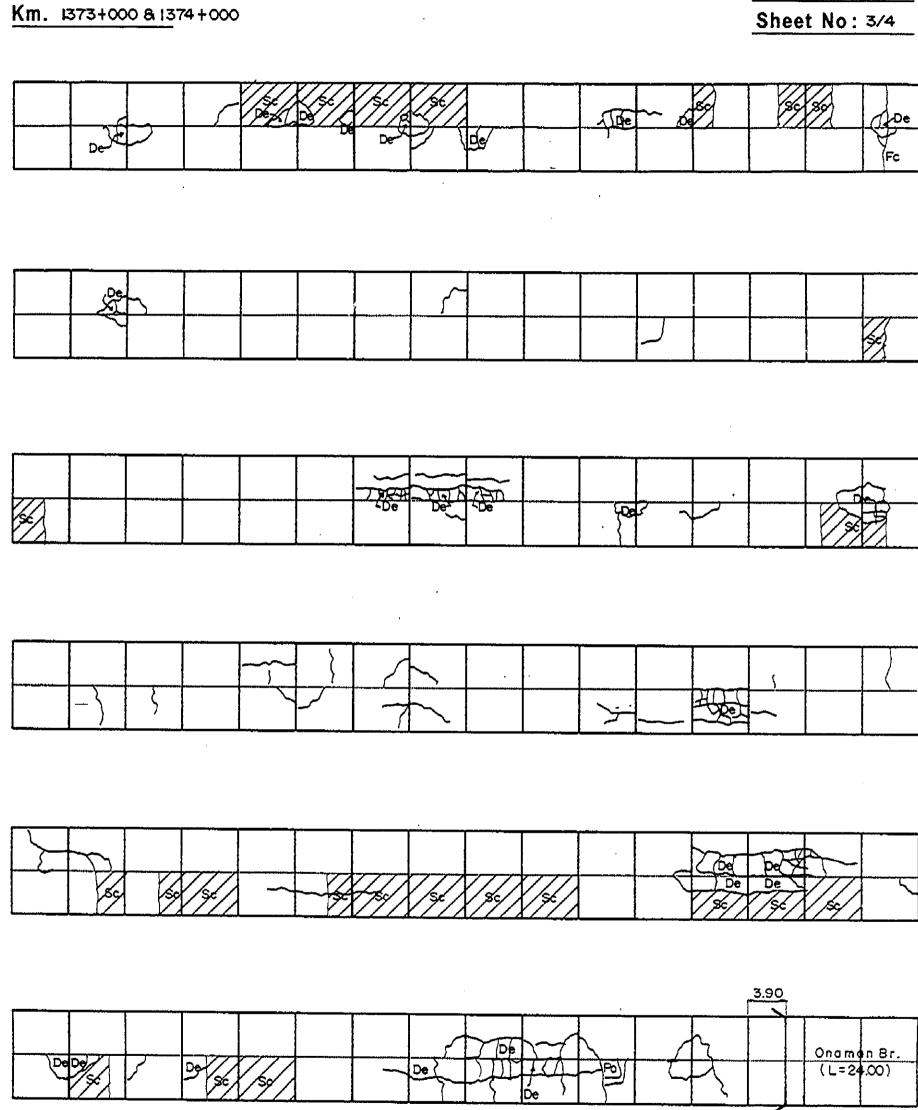


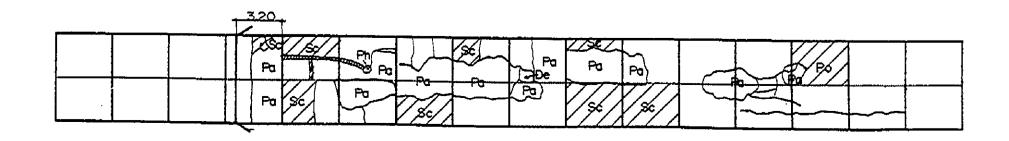



Km. 1373+000 & 1374+000


Date: 10-26-95


Sheet No: 4/4

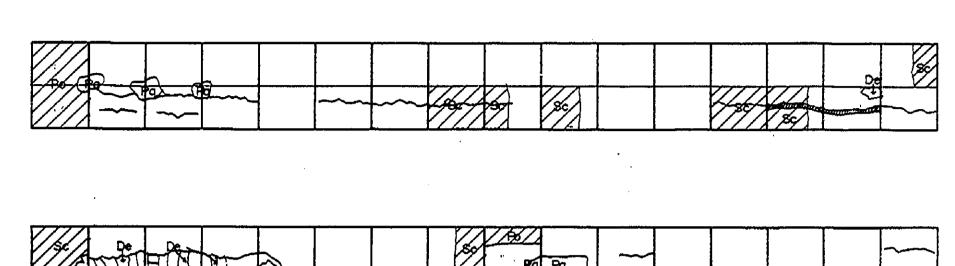


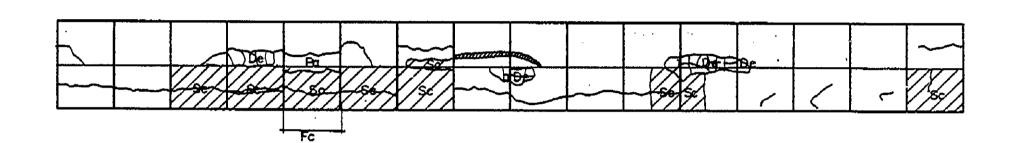


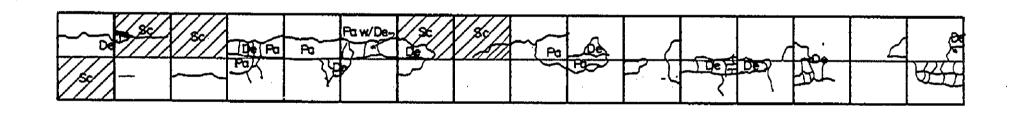

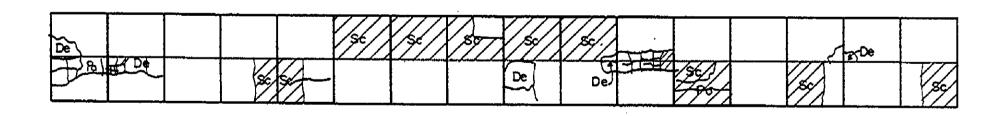


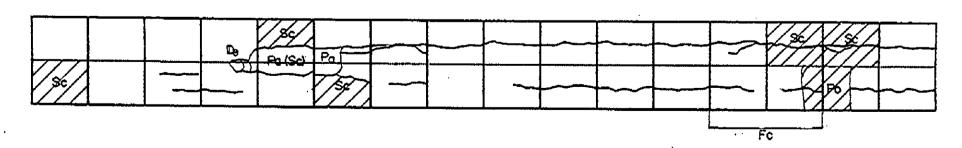


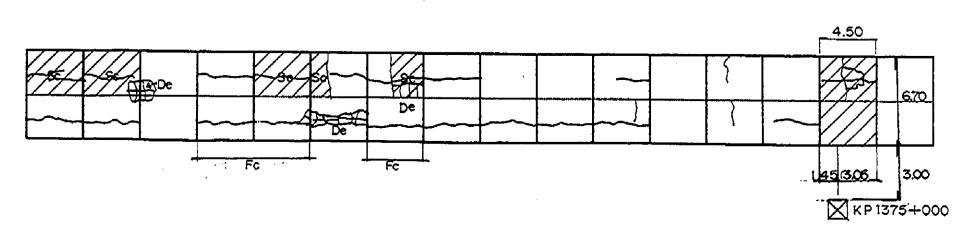


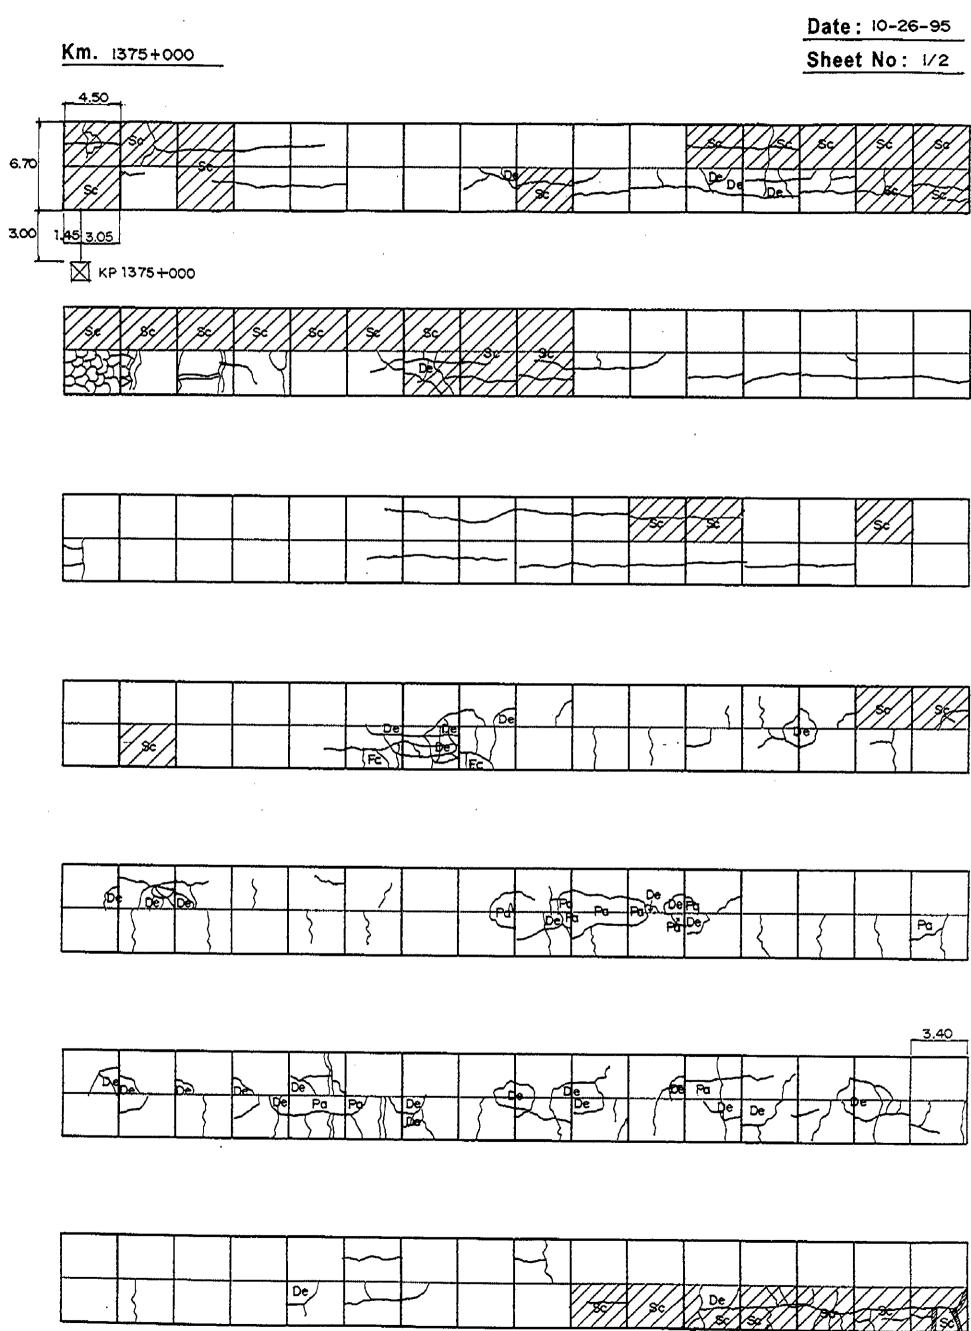

Date: 10-26-95

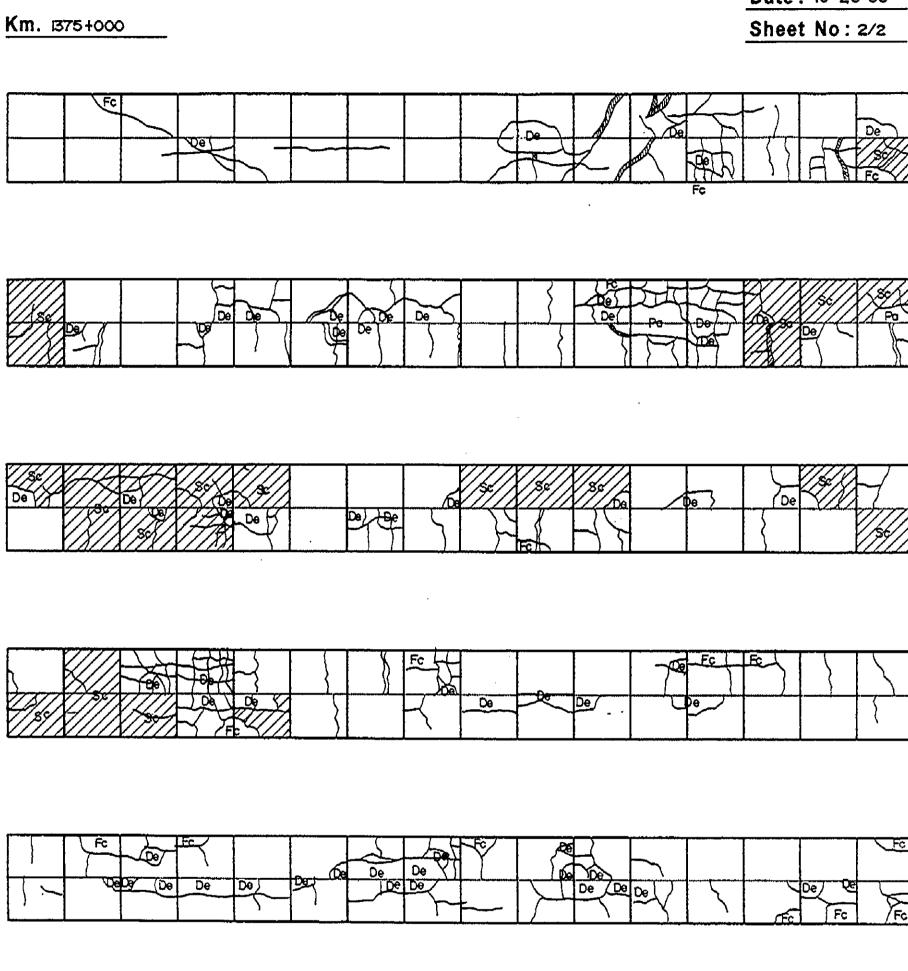

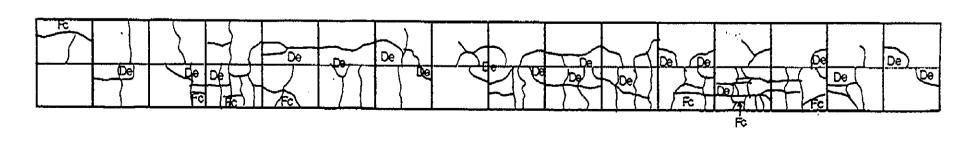

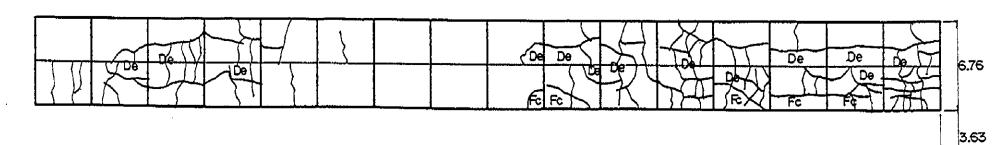

KP 1376+000 🔯

大学 ないのかのできることはないないないのできるというないという

# PAN-PHILIPPINE HIGHWAY IMPROVEMENT PROJECT (MINDANAO SECTION)

# PAVEMENT DISTRESS SURVEY PACKAGE 13 End of Lankilaan Br. - Km. 1396+000

DECEMBER, 1996

To SURIGAO

4.50

De Vm Skm. 1350

To DAVAO

LEGENDS:

2-2

- I. Cracks Open Cracks Sealed Cracks
- 2. Potholes Ph


- 3. Patching Pa
- 4. Cracks with Faulting Fc
- 5. Scaling Sc
- 6. Depression De
- 7. Pop out Po

8. Overlay -OL (Sketch area of pavement with overlay)

- 9. Under Construction UC
- 10. Gravel Gr (Except Under Construction)
- 11. Other Information
  - · Kilometer Post
    - Bridge


Date: 10-26-95 Km. 1376 +000 Sheet No: 1/3 4.50 6.76 3.63 × KPI376+000 ⇒Bleeding 2.87 3,23 De

400

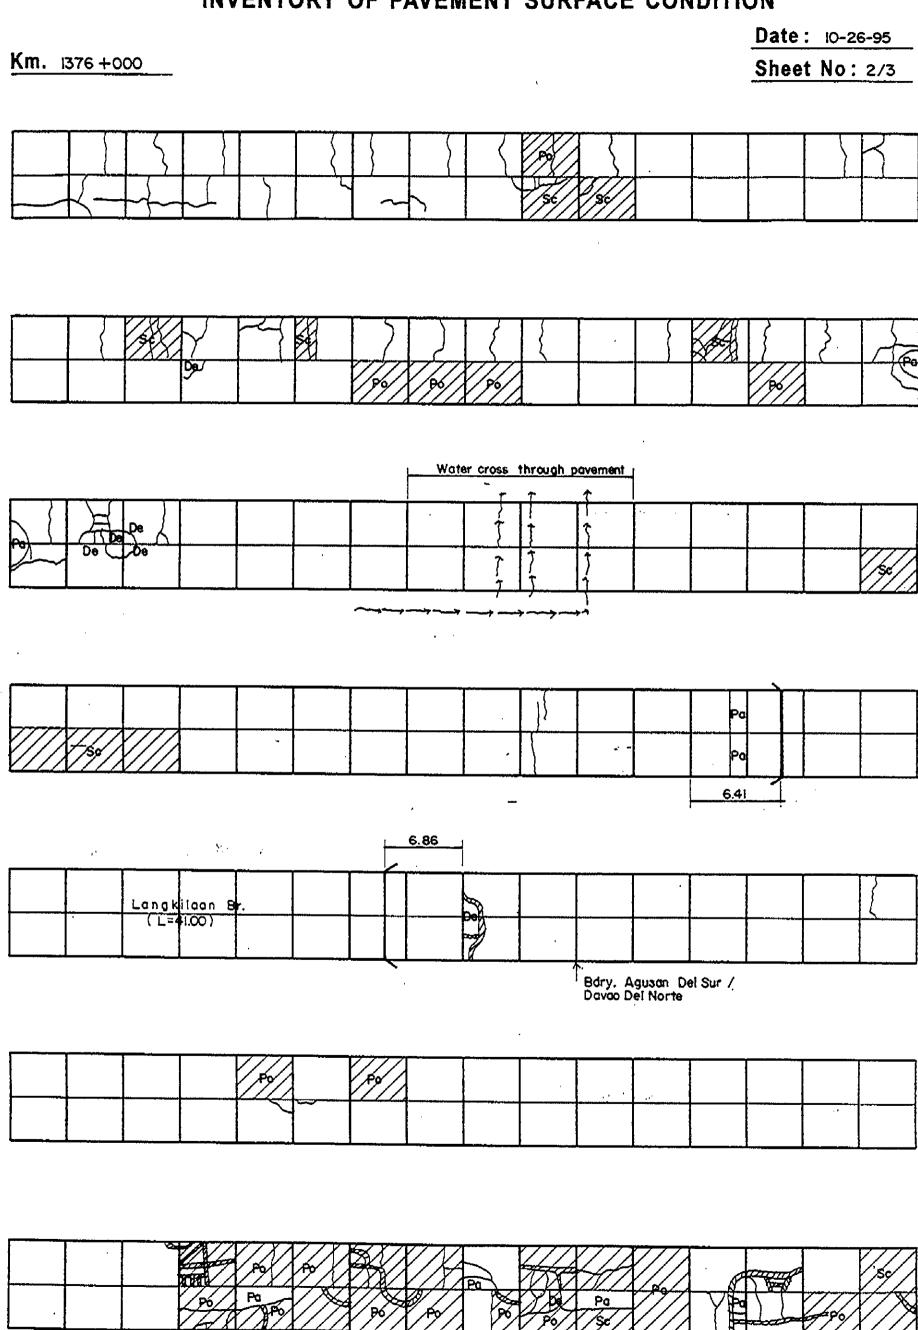

Date: 10-26-95 Km. 1376 +000 Sheet No: 3/3 4.50 2.80 1.70 1.45 **⊠ ΚΡΙ377 +∞∞** 


The state of the s

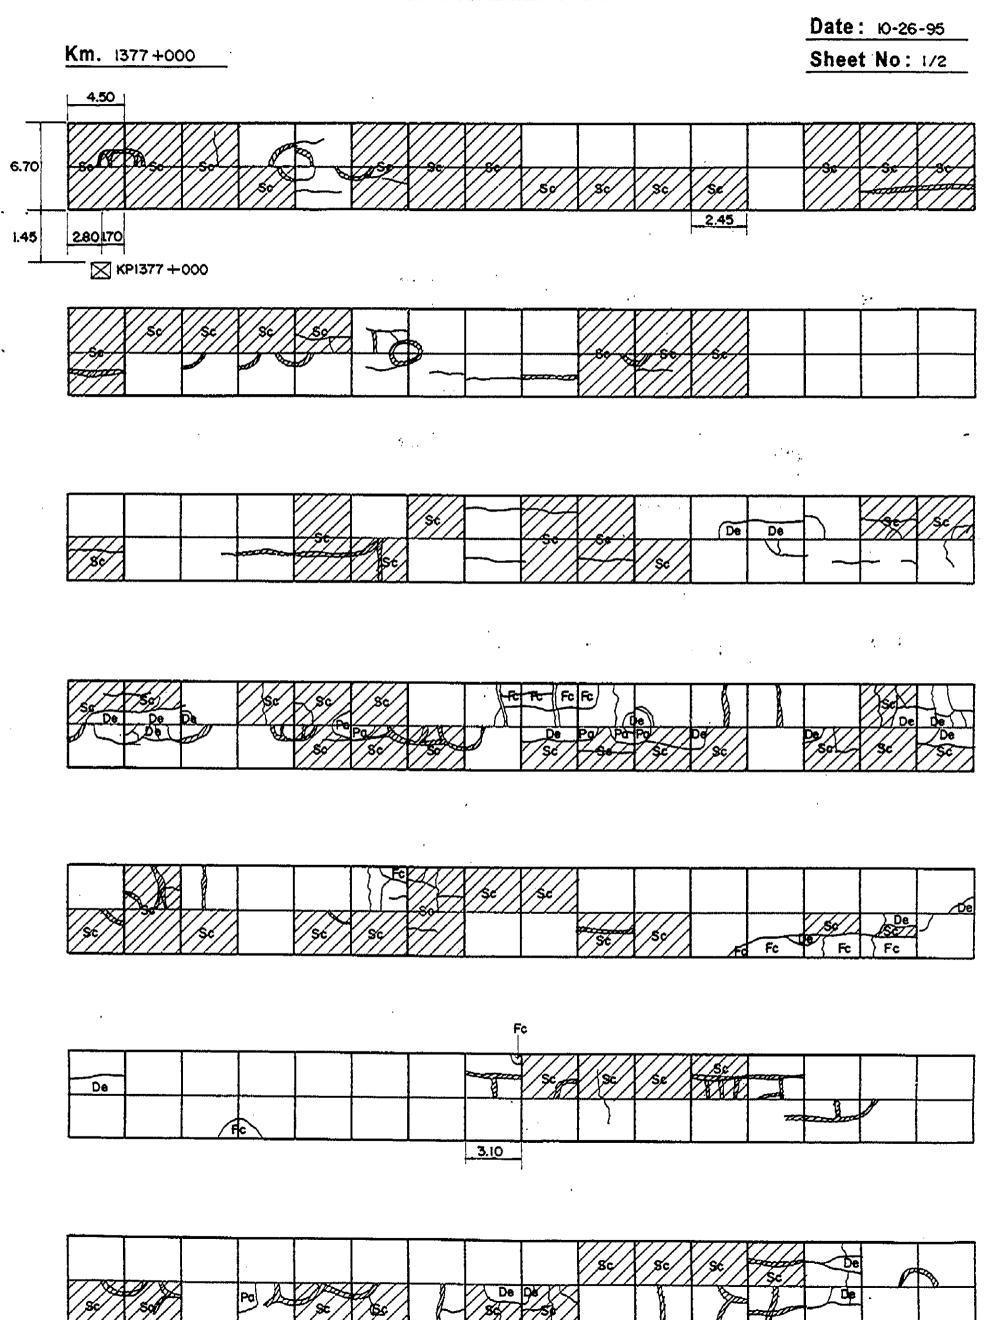



Date: 10-26-95

**Km.** 1377+000

Sheet No: 2/2

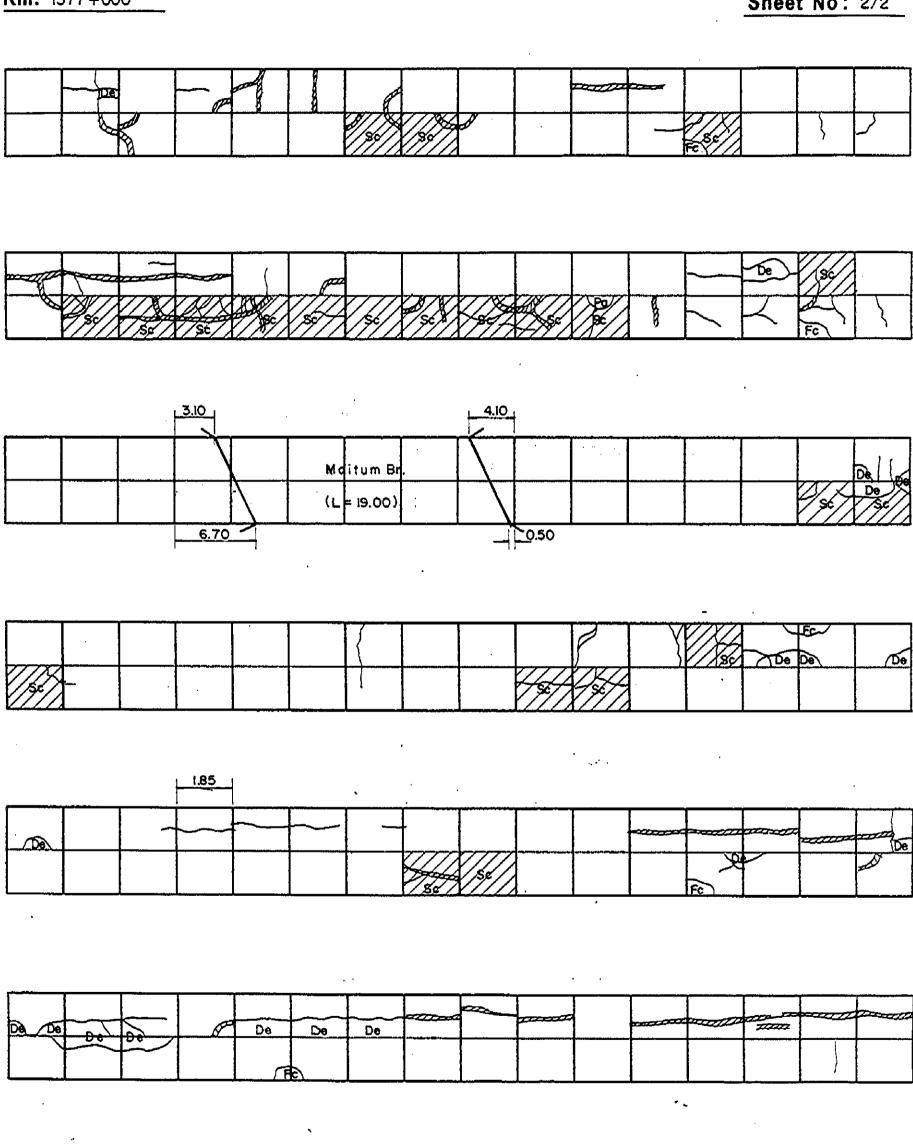

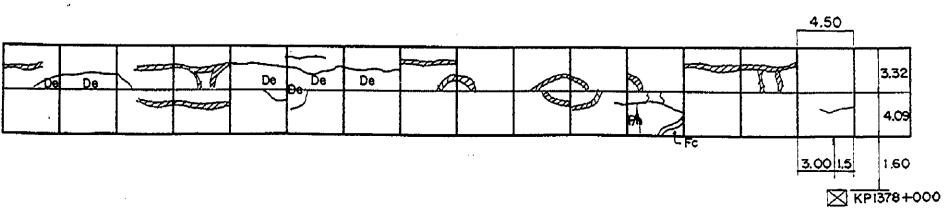

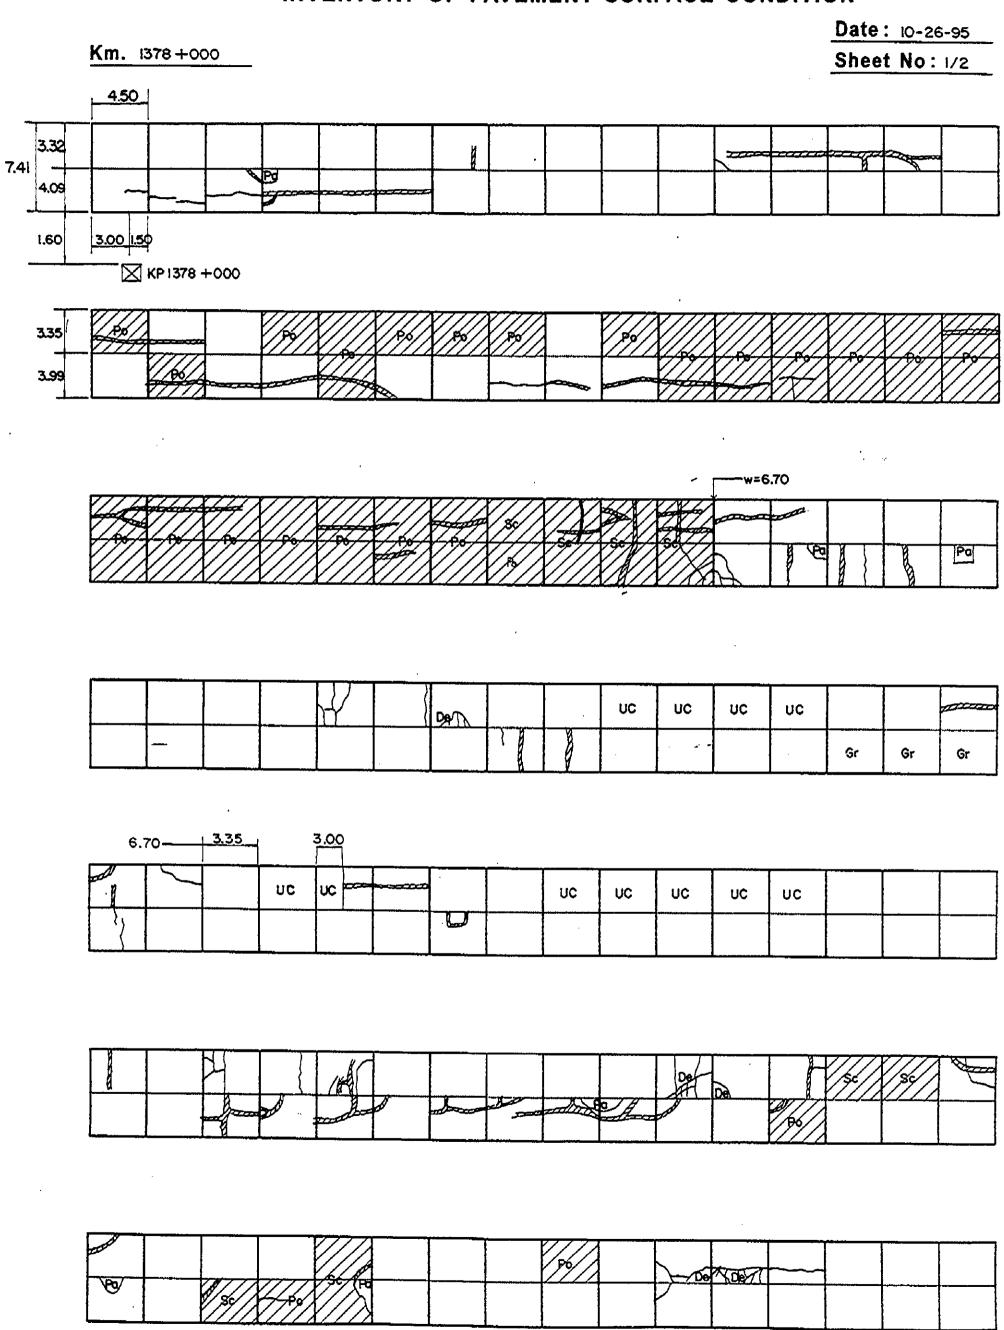


INVENTORY OF PAVEMENT SURFACE CONDITION Date: 10-26-95 Km. 1378+000 Sheet No: 2/2 UC UC UC ŲC UC UC UC 2.70 Under construction slope & embankment side Ģr Under const'n. slope 8 emb. side -Ģr G Gr De Gr Gr Gr 4.50 00 UÇ UC

2.90 1.60


1.60

**▼ KP1379** +000



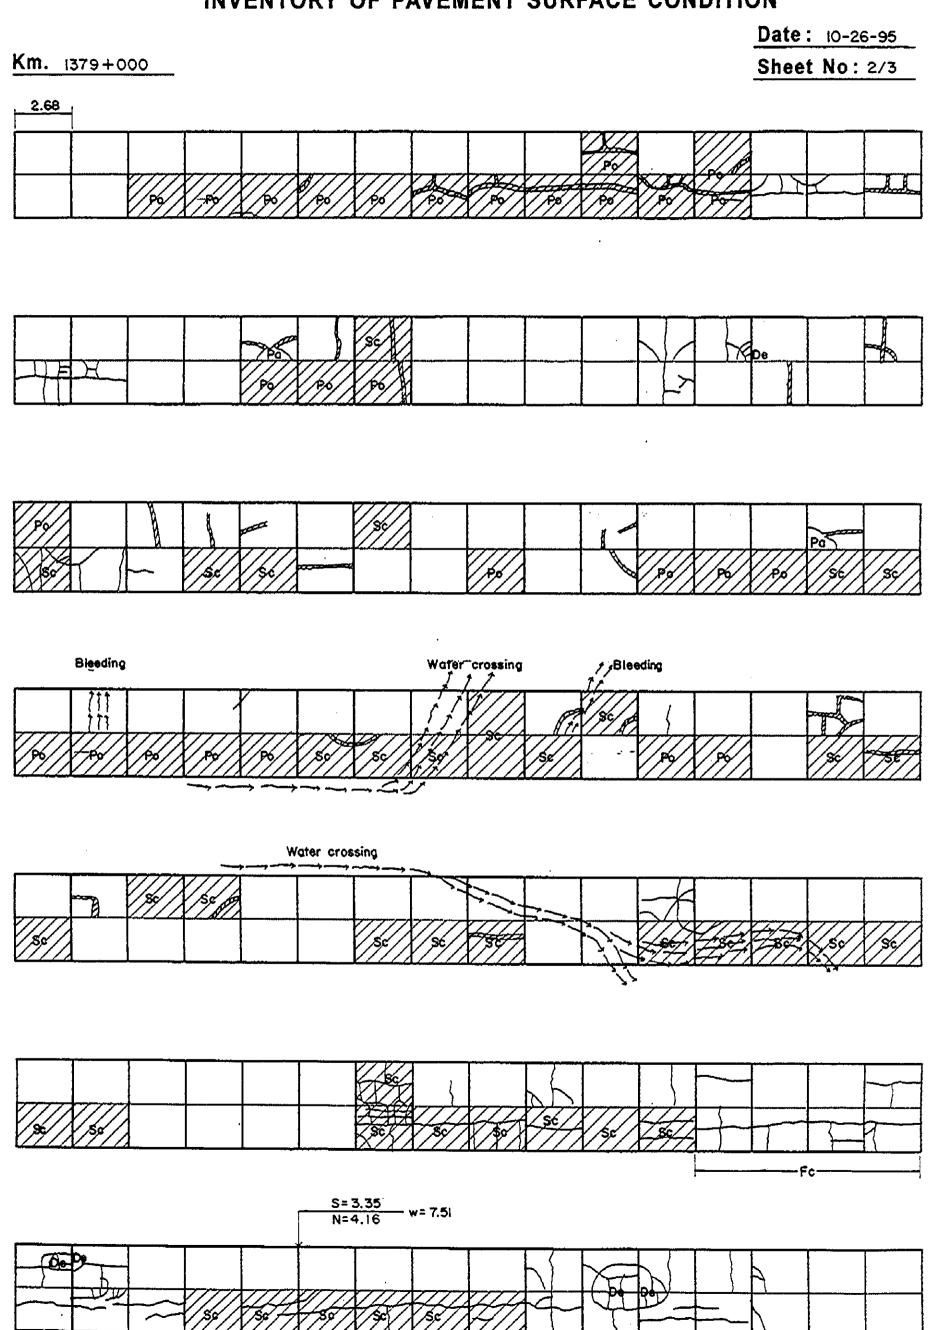

Date: 10-26-95 Km. 1379 +000 Sheet No: 3/3 Water crossing 4.50 **⊠ KP 1380** +000

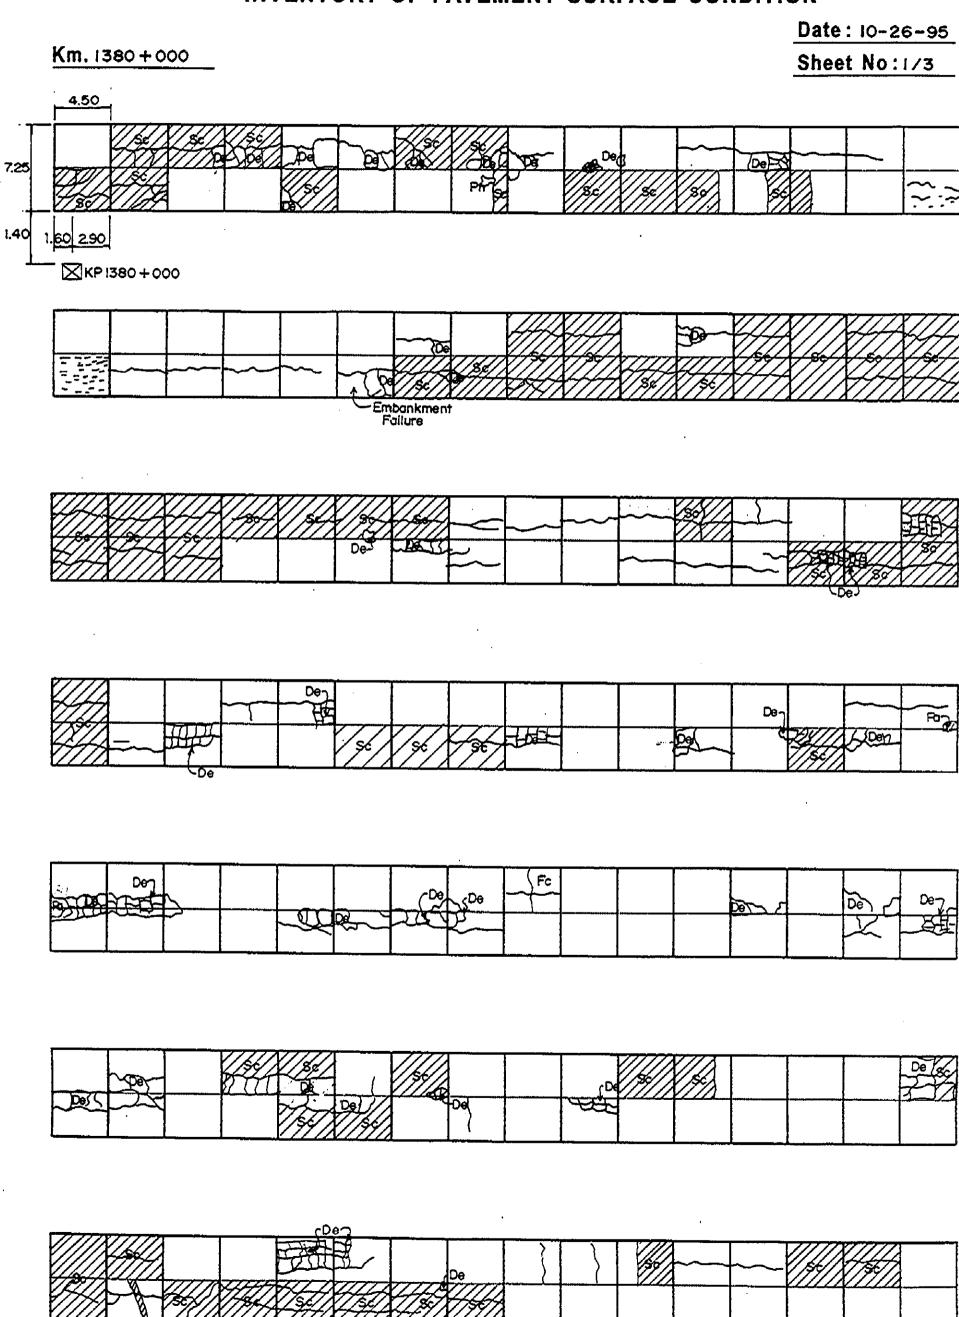


Km. 1380+000

(mari


Date: 10-26-95

Sheet No: 2/3


THE PROPERTY OF THE PROPERTY O

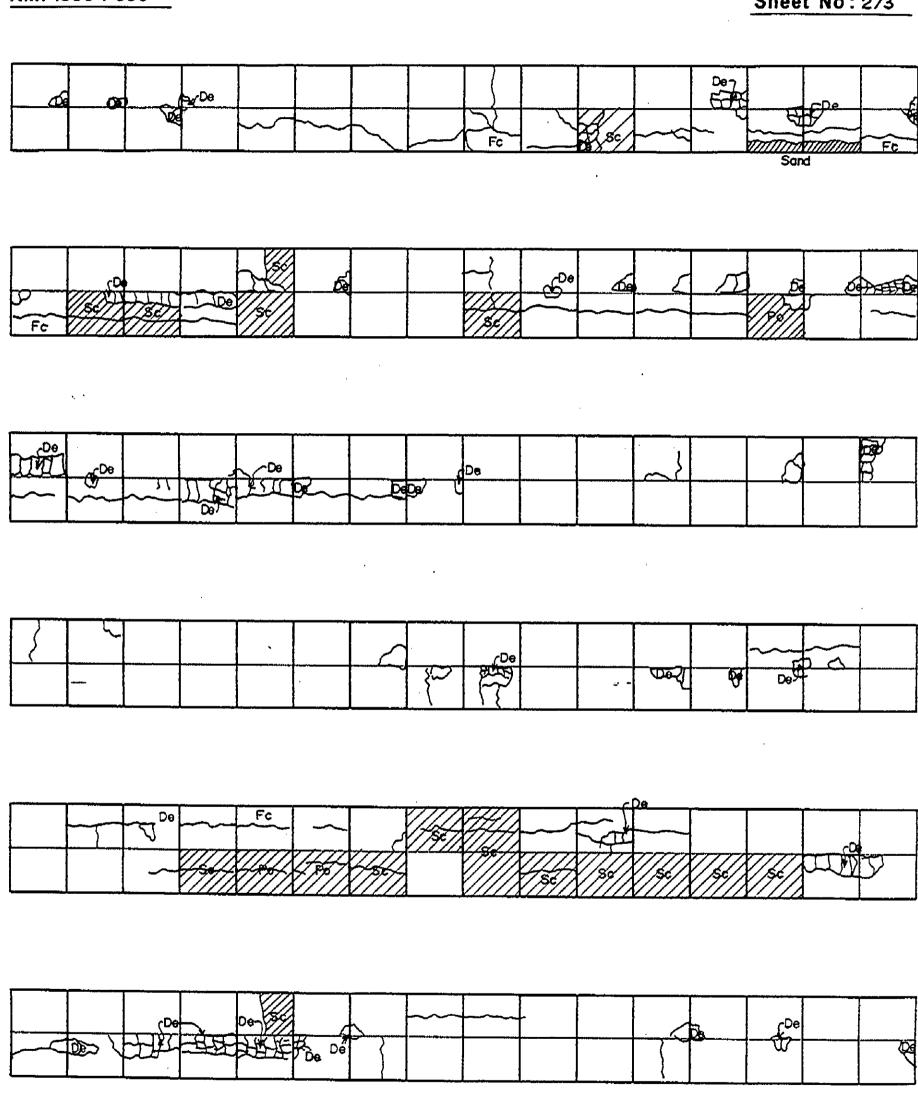


Date: 10-26-95 Km. 1380+000 Sheet No:3/3 Water Crossing 00-) 11-11-10 3.70 1.60 510 1'60 **⊠ KPI38**1+000

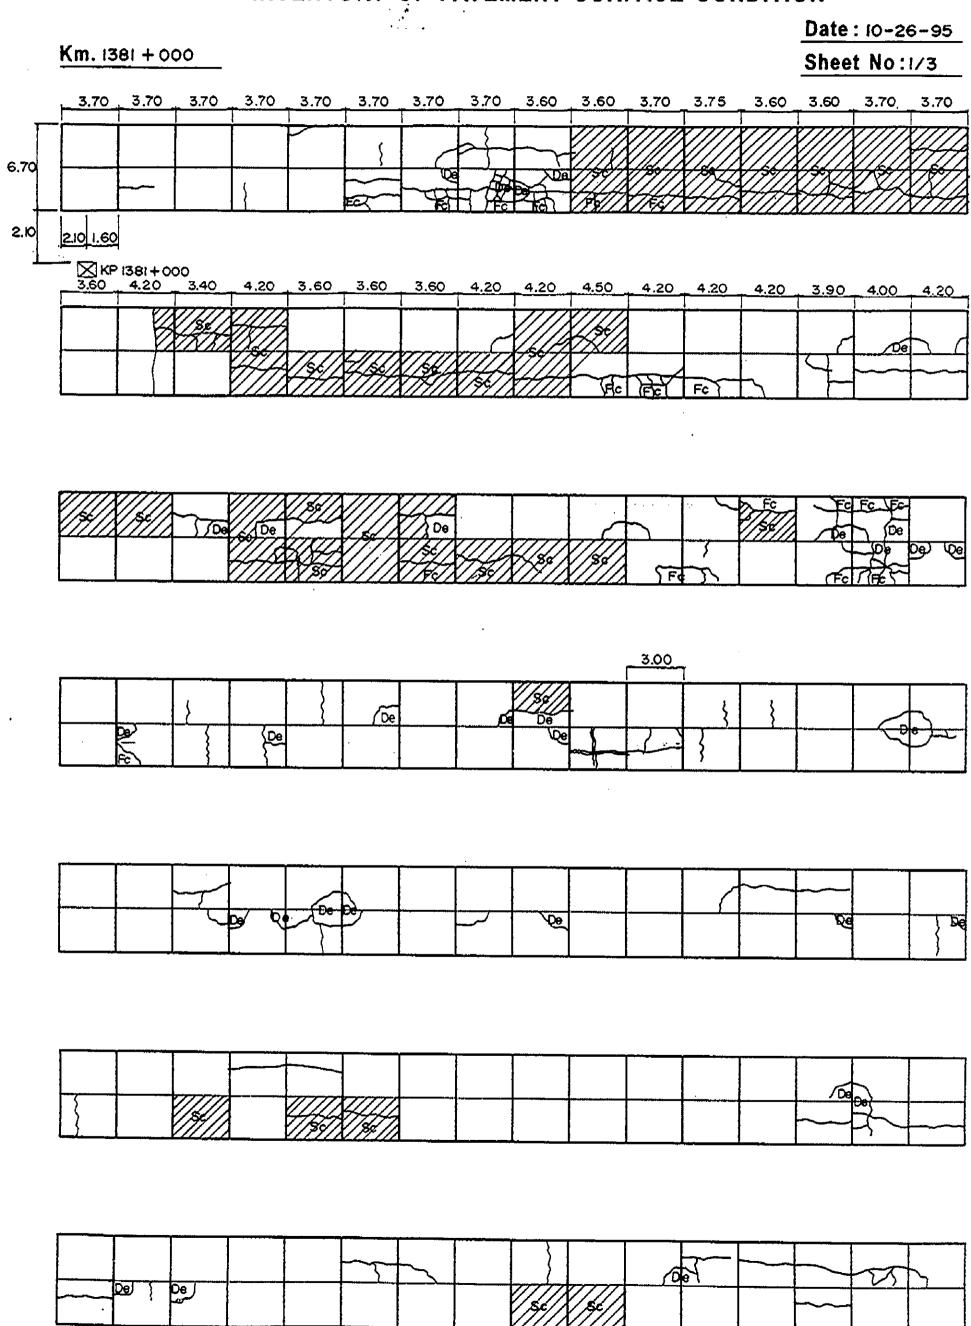

Date: 10-25-95 Km. 1381 + 000 Sheet No:2/3 Æ प्ट De <u>Del</u> Fc YDe (De De ∫0e De De

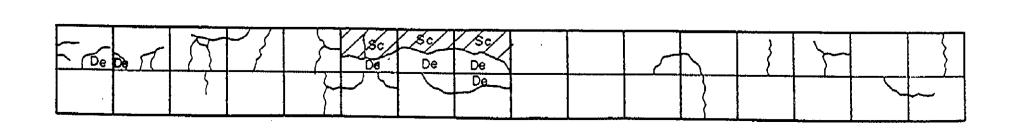

Date: 10-26-95 Km. 1381 + 000 Sheet No: 3/3 De De 1.45 3.05 1.65 **⊠**KP1382+0∞

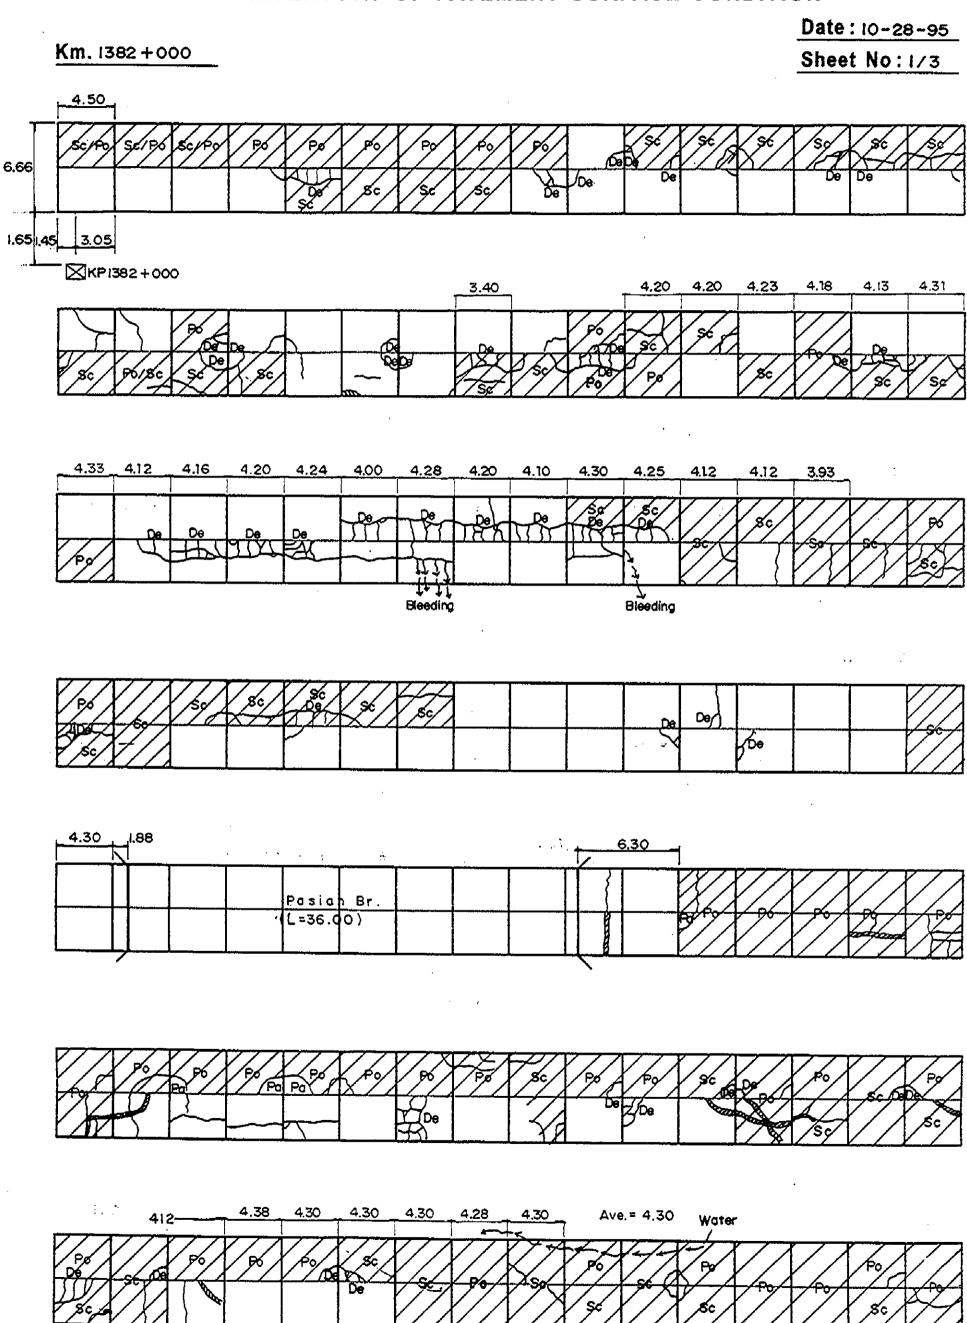

Date:10-28-95
Sheet No: 2/3

The state of the s

Km. 1382+000


Ave. = 4.30

Ave. = 4.30

Set | Set

4.40 4.40 | 4.40 | 4.40

Km. 1382+000													Date: 10 28 95 Sheet No: 3/3		
4.37															
			M		Y			7 7 10 7	6.70		,	·			
<b>%</b> /	/\$¢/		8c/	/%/	250	/Sg/	/\$¢/	80	De						
0.50 3.87 1.45 ⊠KP 1383 + 000															
			<u> </u>						,						
											. ,	,			
			·												
								,							
	_									-					
	·······································	+**			***********										
														:	

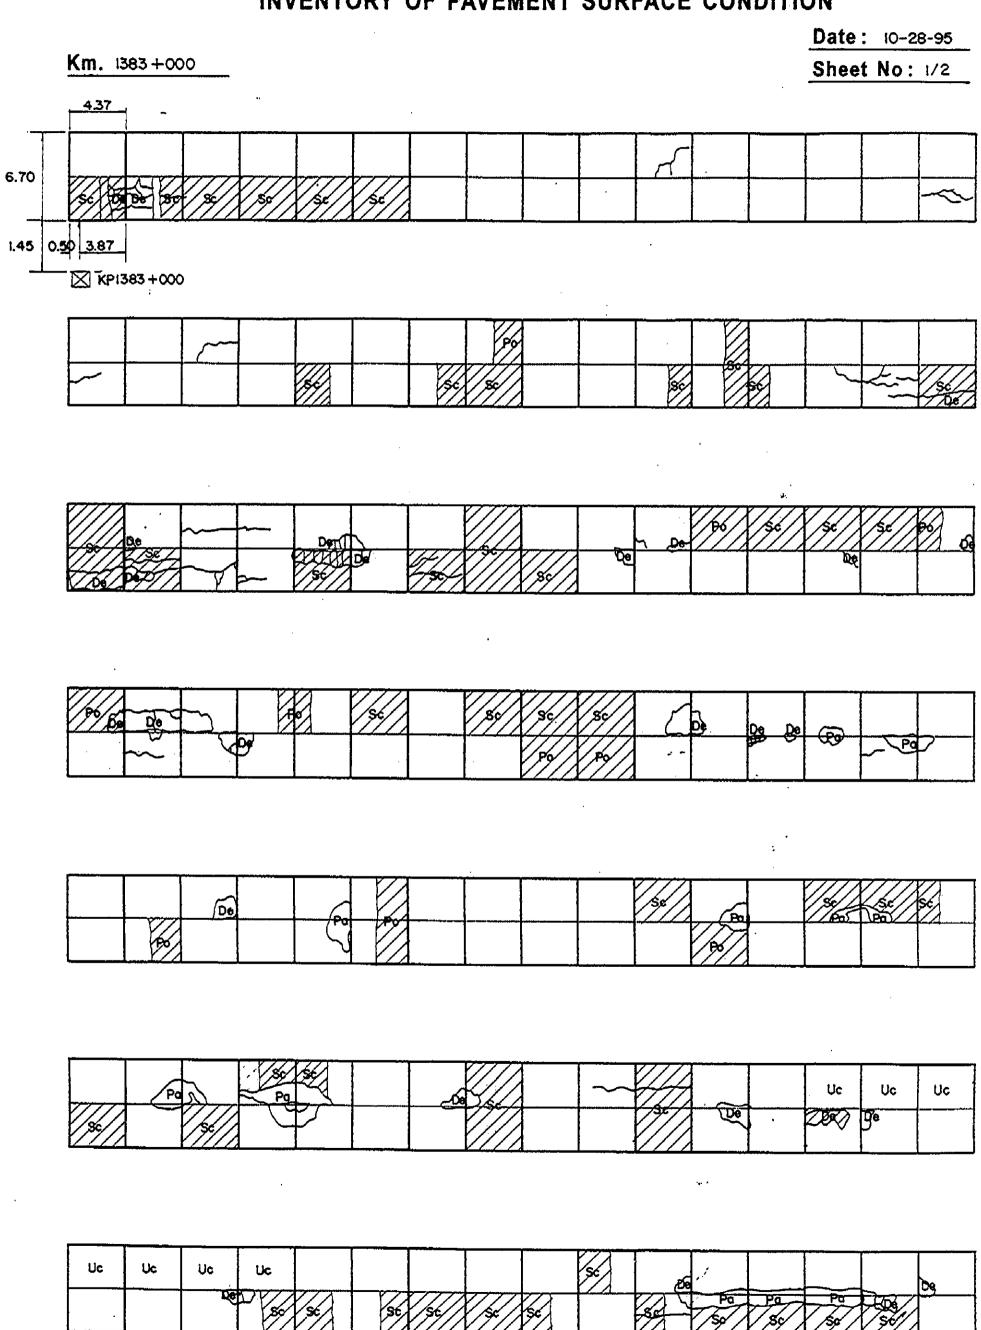


INVENTORY OF PAVEMENT SURFACE CONDITION Date: 10-28-95 Km. 1383+000 Sheet No: 2/2 Fc 3.50 Fc 1.40 KP 1384+000


高年の方式をあるとなるとは、大きのでは、大きのできる

6.2


الكني

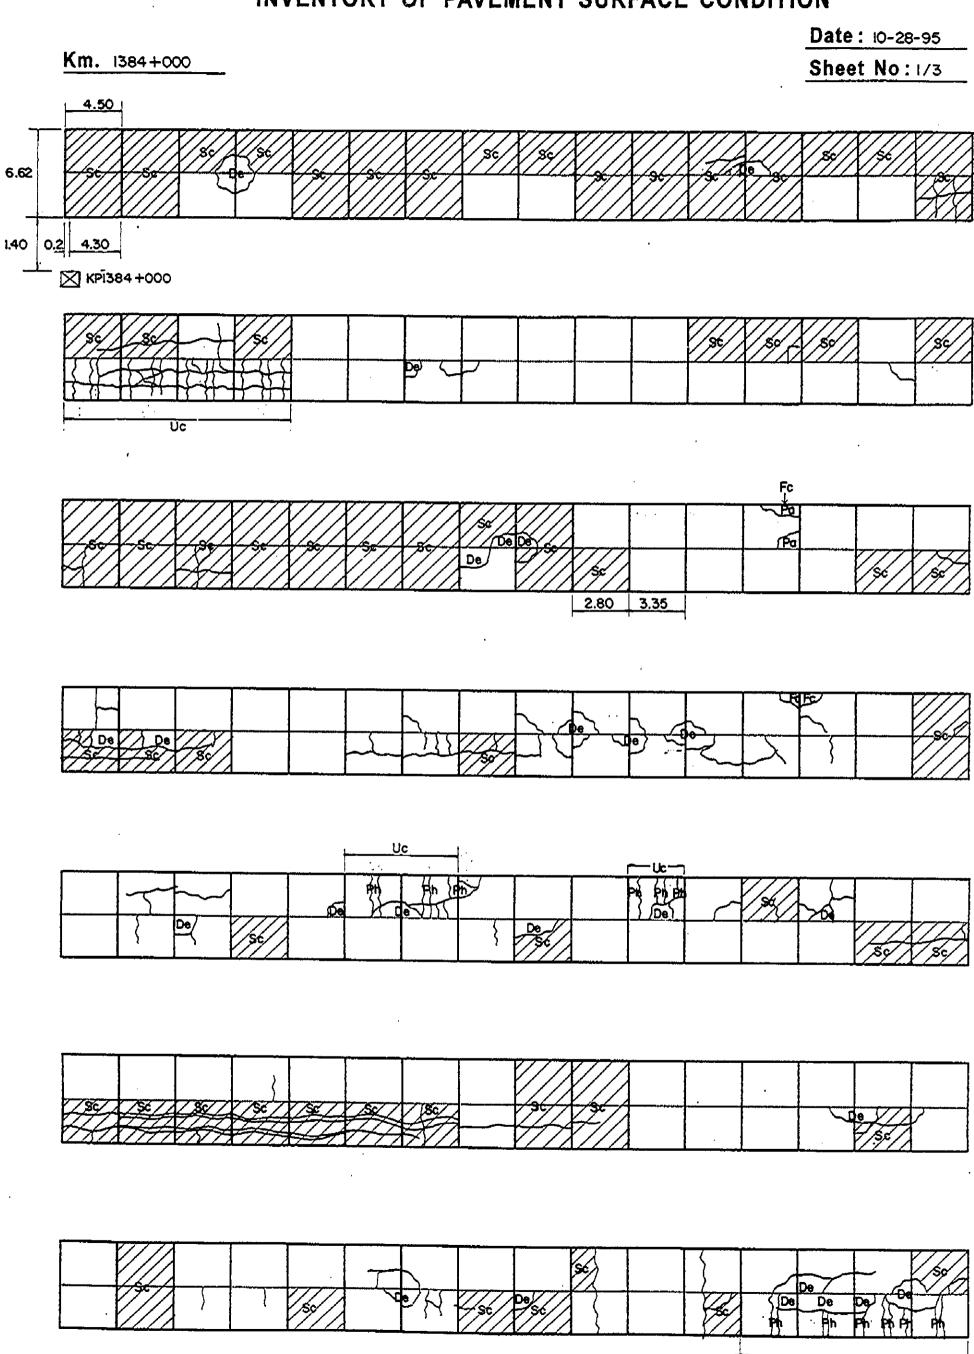

Ü¢

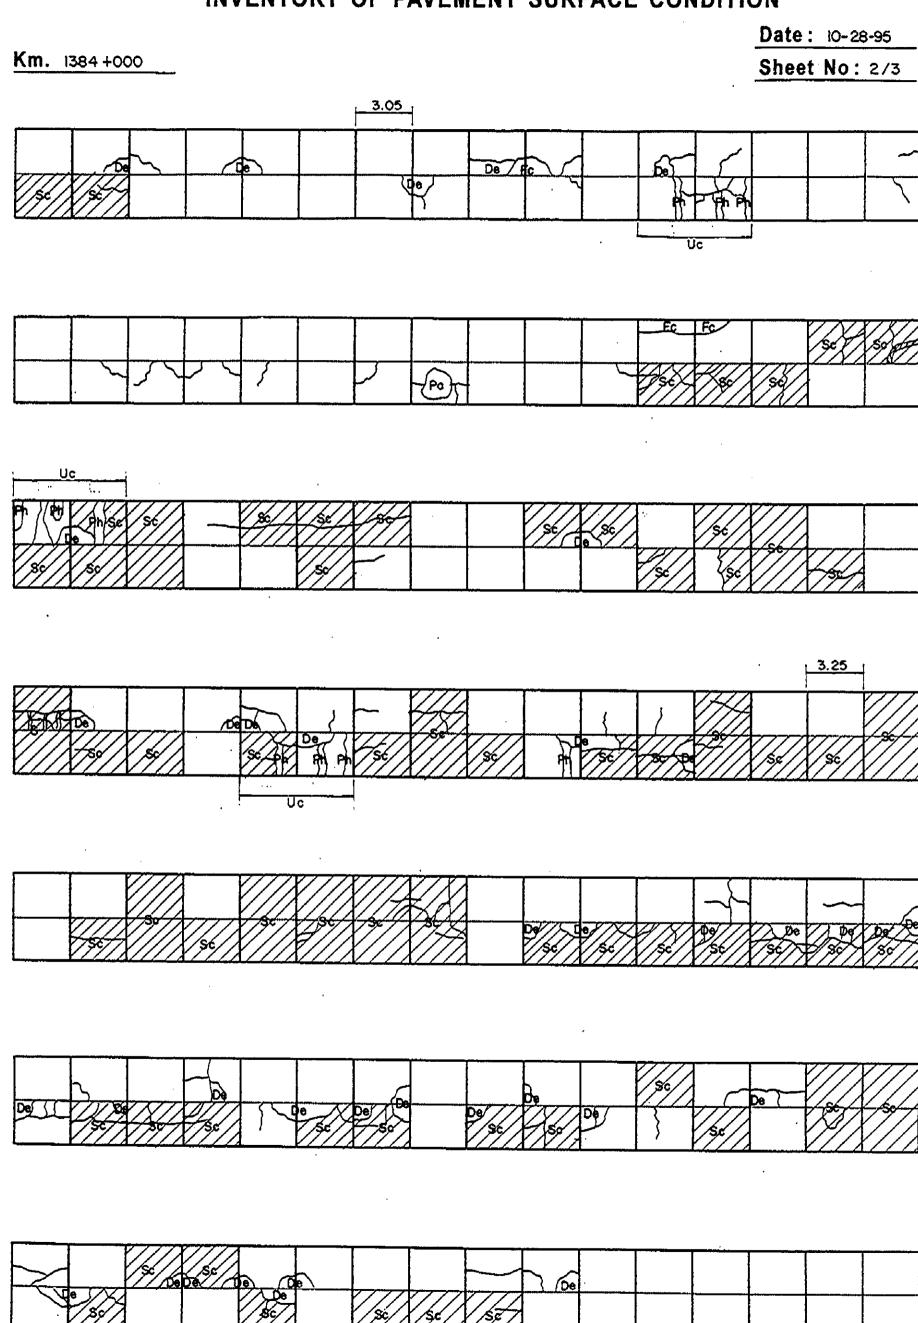

														Date: 10-28-95		
Km. 1384+000													Sheet No: 3/3			
		<u> </u>	<u> </u>	}		<u> </u>	<del></del>		<u> </u>	1	1	<u> </u>	<del></del>	<u> </u>	T	
	<u> </u>	De	\\\\\\\\\\\\\\\\\\\\\\\\\\\\\\\\\\\\\					<u> </u>					De		0	
		222										35	\ <b>s</b> \(\)		/\$¢//	
							•									
				4.50	1									_		
			+													
	1	1 5			6.70	1										
	<u> </u>	<u> </u>	]			<u> </u>	<u></u>	<u>.                                    </u>				<u> </u>				
4.20 03 1.10																
					<del>                                     </del>	T	1	<u> </u>	]	l · ·	1.0	1	<del></del>		T	
		ļ							ļ							
									ł							
					-											
							•									
	·r												•			
									}	<b>-</b>						
	<u> </u>	<u> </u>	<u> </u>	<u> </u>	<u>.                                    </u>	l			1		<u>.                                    </u>	<u> </u>	<u> </u>		1	
									1		<u> </u>				}	
				***************************************					·							
	<u> </u>															
					-		•								<del> </del>	
	T	<del></del>	·					<del></del>	·		<del>,</del>					
					<u> </u>											
											•	-	,			
<u></u>	<u></u>	<u></u>	<u>I.                                    </u>		<u> </u>	<u> </u>	<u>L</u>	<u> </u>	<u> </u>							
	<del></del>	[											ļ	<u> </u>		
		]														

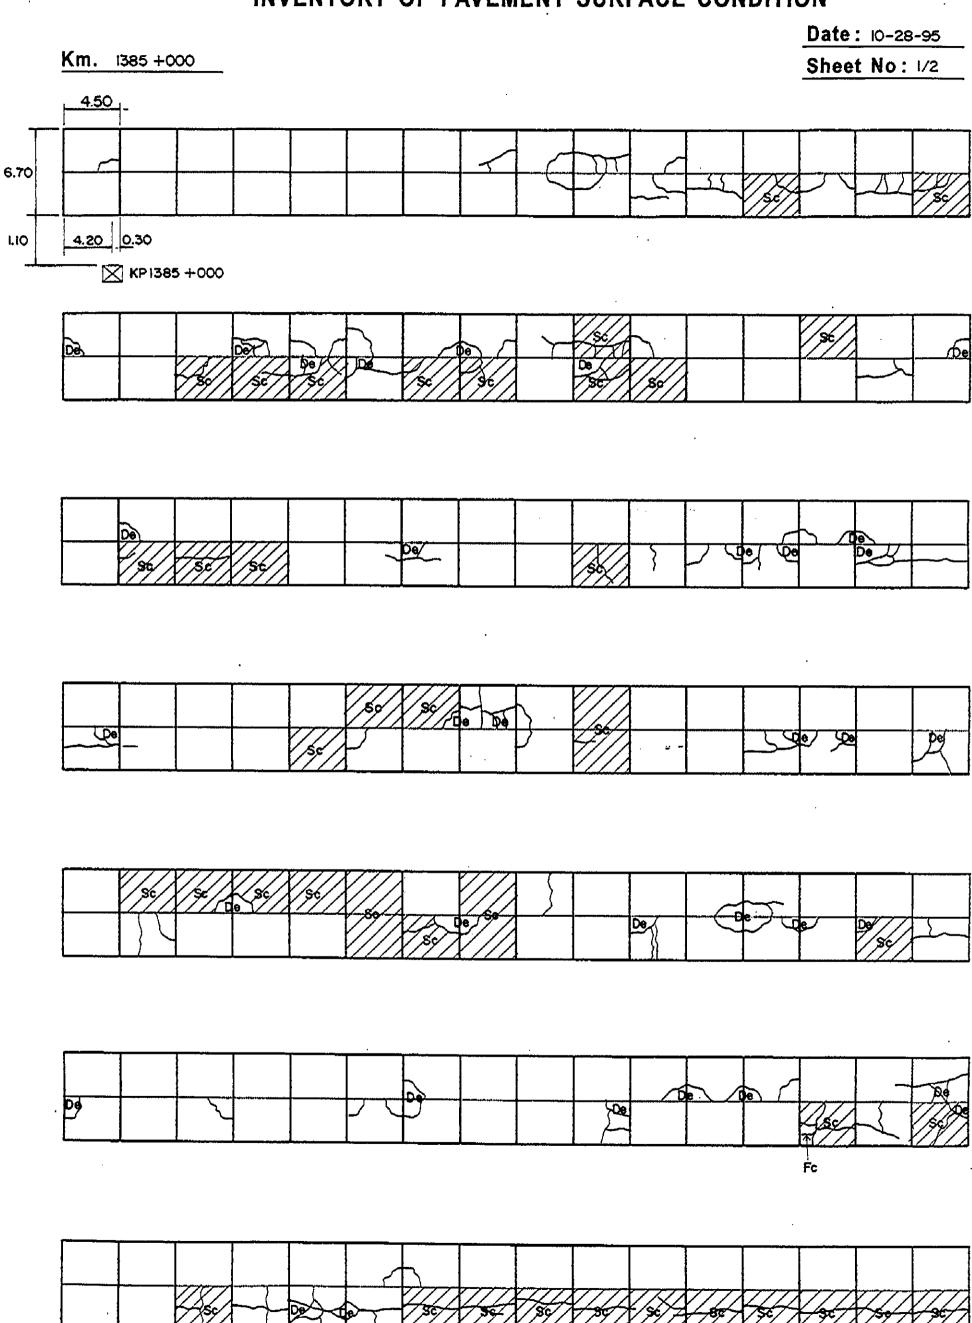

INVENTORY OF PAVEMENT SURFACE CONDITION Date: 10-28-95 Km. 1385 +000 Sheet No: 2/2 4.50 Toe De 6.70

2.90 1.6

1.10

**⊠ KPI386+000**