# PAN-PHILIPPINE HIGHWAY IMPROVEMENT PROJECT (MINDANAO SECTION)

#### PAVEMENT DISTRESS SURVEY

PACKAGE 19 Km.1497+000 - Km.1516+000

DECEMBER, 1996

To SURIGAO

4.50

Ph

UC

Ph

Wm Skm. 1350

To DAVAO

LEGENDS :

car.

2. Potholes - Ph

3. Patching — Pa

4. Crocks with Faulting - Fc

5. Scaling — Sc

6. Depression - De

7. Pop out - Po

8. Overlay -OL (Sketch area of pavement with overlay)

STATE OF THE PROPERTY OF THE P


9. Under Construction - UC

iO. Gravei — Gr (Except Under Construction)

li. Other information

· Kilometer Post

• Bridge

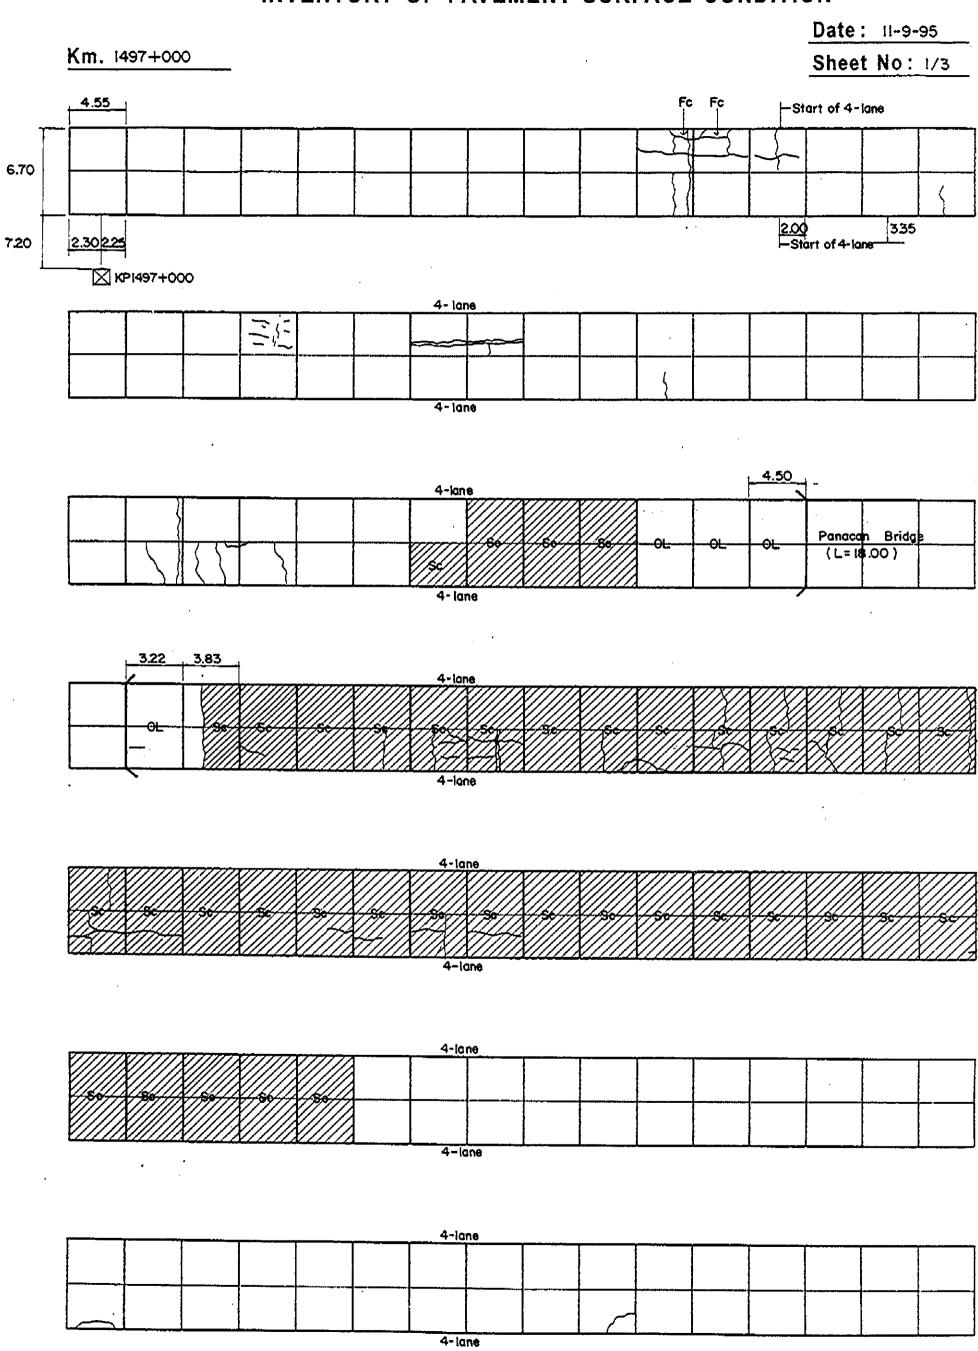

Date: 11-9-95 Km. 1497+000 Sheet No: 2/3 1.85 4-lane -Start of 4-lane -Stort of junction island -Start of diversion -Start of 4-lane End of junction island . 4-lane 4-lane


4-lane

**書紙が**がないのである。これではないないないないないないできょう。

Date: 11-9-95 Km. 1497+000 Sheet No: 3/3 4.45 4-lane KP1498+000

Date: 11-9-95 Km. 1498+000 Sheet No: 1/2 4,45 6.70 3.35 3.45 1.00 Edge of 4-lane 3.45 End of 4-lane-户 Open crack Fc

Date: 11-9-95 Km. 1498+000 Sheet No: 2/2  $\sim$ 4.28 6.66 190 238 2.40

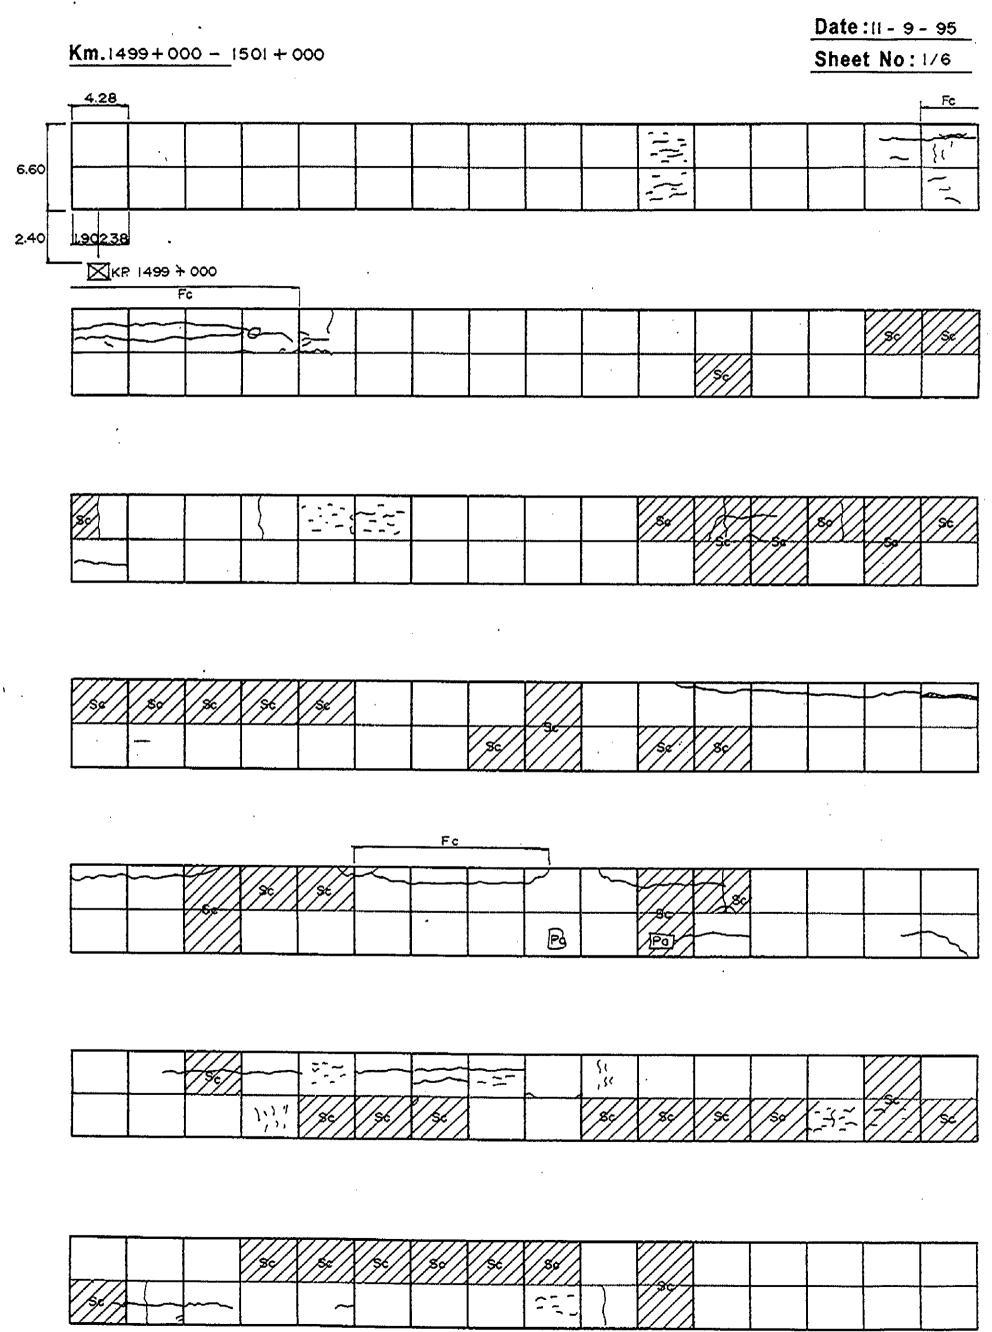

640

Date: 11 - 9 - 95 Km.1499+000 - 1501+000 Sheet No: 2/6 Fc

Date: 11 - 9 - 95

<u>Km.1499 +000 - 1501 +000</u>

Sheet No: 3/6

<u> </u>	99 + 00	0 - 15	01 + 000	5									Shee	t No:	<u>3/6</u>
							,					{			
							7777					<u></u>			
											<u> </u>				
				•											
	*			<b>.</b>	<del></del>			·	<b>_</b>		<del>77777</del>	1 <del>2                                    </del>	177777	<del></del>	כי בי בי בי
/s//			()								/ <u>\$</u> \$//		/ <u> </u>  \$	ľ	189
	1					7777							. Vandambanda		
		<u> </u>		ļ			<u> </u>		<u> </u>	<u> </u>	<u> </u>	<u> </u>			<u> </u>
7777	X////	X////	7777	V///	777	V///	X///	<i>Y////</i>	V///	<i>2777</i>	X///	V///	V///	V///	X77
19 /S		/ <u>}</u>	<u> </u>	/	*/ F9/				199/	[]]]	\\\\\\\\\\\\\\\\\\\\\\\\\\\\\\\\\\\\\\	15/	\\\\\\\\\\\\\\\\\\\\\\\\\\\\\\\\\\\\\\	<u>//%//</u>	<u>/</u> 2
		,													
		\/s </td <td></td> <td>/%/</td> <td></td> <td>1</td> <td></td> <td></td> <td></td> <td></td> <td>T .</td> <td></td> <td></td> <td></td> <td></td>		/%/		1					T .				
	1///	1///				1							<u>-</u>	<del> </del>	<u> </u>
					<u></u>							<u> </u>			
												•			
	1	T	1			Υ	· .	<del>777</del>	12 2	<u> </u>	1777	<del>,</del>	γ	<del></del>	<del></del>
/ <u>%/</u> /	1							/\$e//	500		\se_	1			
						•		1							
	!		<u>.                                    </u>			<u> </u>		<u> </u>	1	<u> </u>					1
										,					
		•													
							<u> </u>	T		<u> </u>		T	T	1	T
	<u> </u>	<del> </del>		ļ		-	-	ļ	<u> </u>	7777		ļ	<b></b>	ļ	
										/\$¢/	\ <b>\$</b> 5\\	1			77
						<del></del>		. <u></u>							
	····		<b>4</b>		···										
												1			
	1				<del> </del> -					1991	199	1		+	-
<u> </u>	1			1					1		X///	1			

Date: 11 - 9 - 95 Km.1499 + 000 - 1501 + 000 Sheet No: 4/6





16 ma 1 a				_		,						,		:11 - 9	
<u>Km. 14</u>	99 +00	<del>)0 – 15</del>	00 + 10	Ю					•				Shee	t No:	5/6
		1							]		<u> </u>				_
	12/2	1													
	_	•					*		· · · · · · · · · · · · · · · · · · ·		<b></b>	<u> </u>	<b></b>		·
			<u> </u>												
•															
<i>77777</i>				1	<b>T</b>	1	<u> </u>	· • · · · · · · · · · · · · · · · · · ·		<del>\</del>	V////	7777	V777	<i>(7777</i>	r
25/1											/ <u>%</u>	/ <u>}</u>	[ <u>*</u>	/ <u>\$</u> 9//	
										<u> </u>					77.
			Ţ			<b>7</b> ///	V///	V///	7//	7	1		!		
		36/96V	Sc / 60	Se vent	Sel (Fox	50/090X	50/56	Sc Men							
				<i>Y///</i>	<u> </u>				<i>Y///</i>	<u> </u>			1		
						i									
	·						//s//				<b></b>				
								////		\ZZ_	<u> </u>	·			
				i	<u> </u>	<u> </u>					<u> </u>		<u> </u>		
	/%//						/\$//		\\\\\\\\\\\\\\\\\\\\\\\\\\\\\\\\\\\\\\	/sq/	89/	Sc/	/ş¢//		
						100				<b>/</b>	70				
		~	<u> </u>												
		~	7777		7777				[\$f]]	/ <u>3</u> k//		/\$¢/	/5¢/		
. ]															•


Km. 1499 +000 - 1501 +000

Date: 11 - 9 - 95 Sheet No: 6/6

			\	

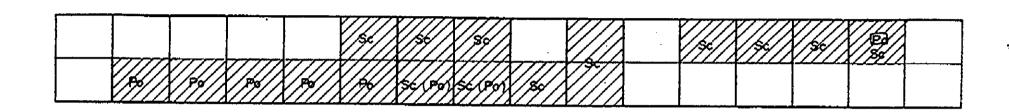


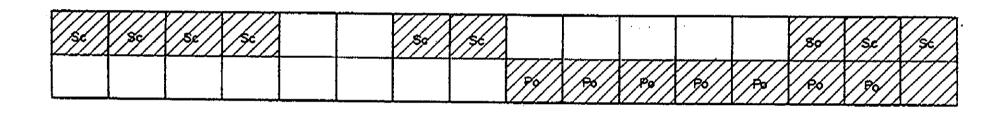


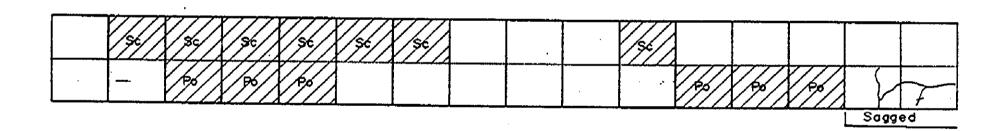

		γ	<del></del>	<del>,</del>								
ļ l	ŀ	Į	ĺ			1						
		İ			1	l	·					
/			<del>                                     </del>		 <b></b>	 		 		·		
			]		'							
						ļ				/ / //	/29/	/%//
Sagged	]					 	-4		·			


Pa Pσ

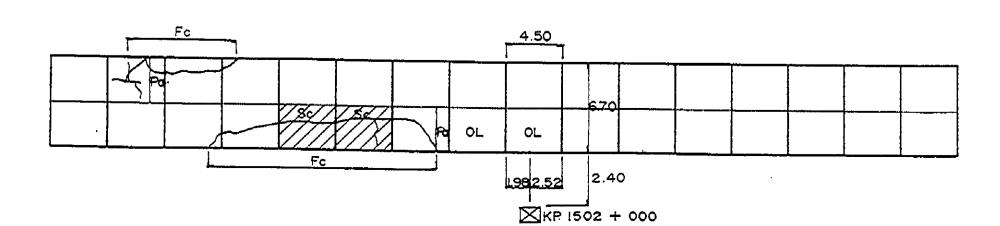


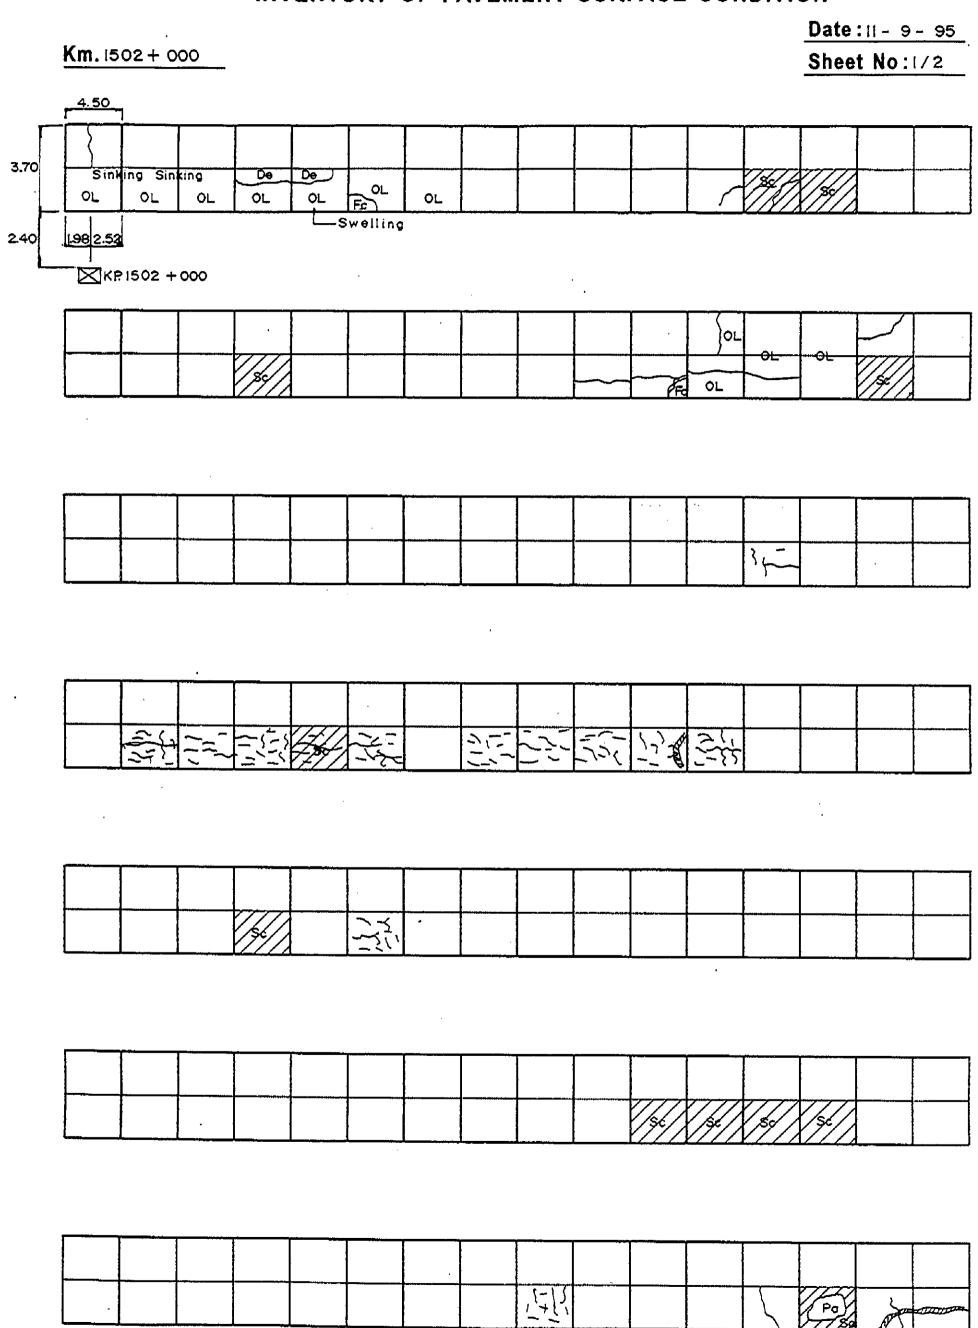


Date:11- 9-95 Km. 1502 + 000 Sheet No: 2/2 4.50 3.35 2.60 3.00 1.50

KR 1503 +000

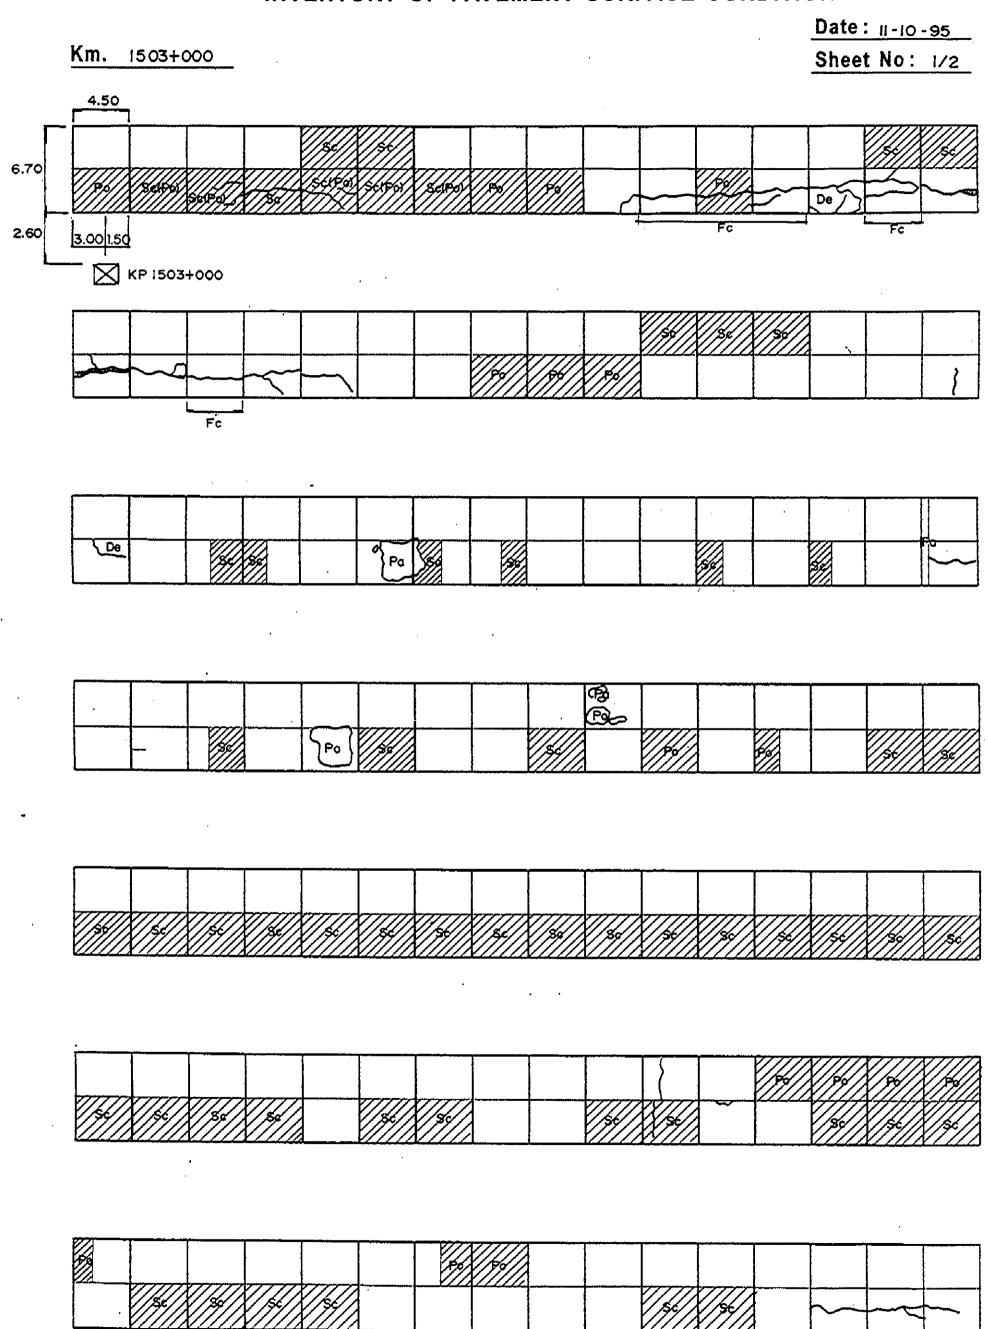

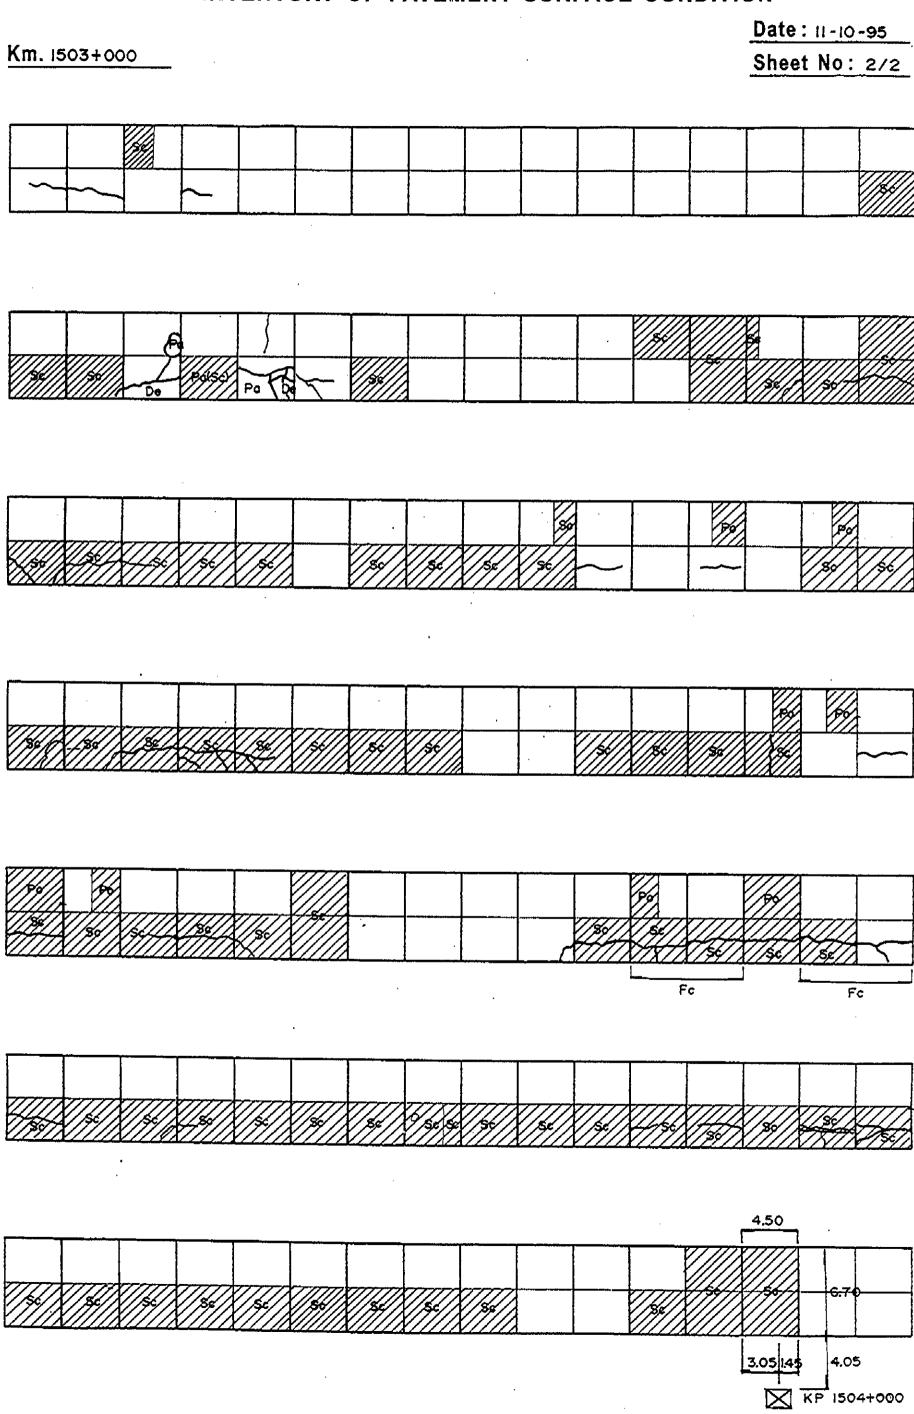

Date: 11-10-95 **Km**. 1504+000 Sheet No: 1/2 4.50 -Start of 4-lane 6.70 3.35 3.05 1.45 4.05 4th lane **⊠ KP I504 +000** 

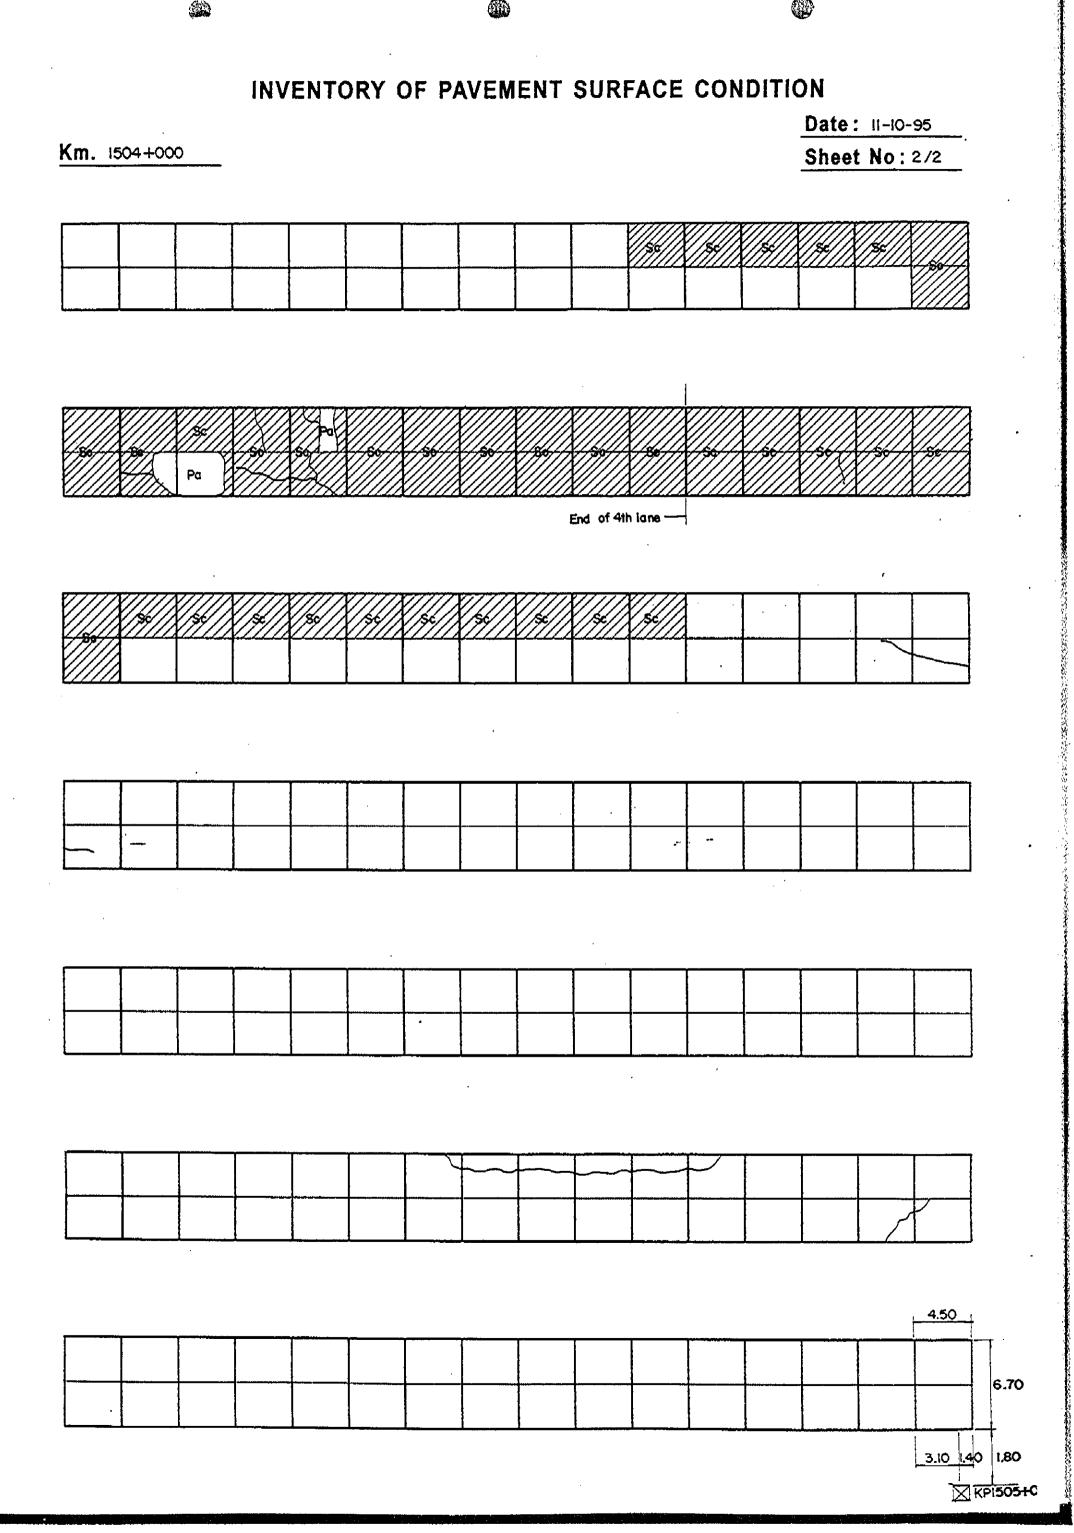


THE RESIDENCE OF THE PROPERTY 
Date: 11 - 10 - 95 Km. 1505 + 000 Sheet No:1/2 6.70 1.80

INVENTORY OF PAVEMENT SURFACE CONDITION Date: II - 10 - 95 Km.1505+000 Sheet No: 2/2 4.44 Pa 6.64

3.60 0.84 2.16

KP 1506 + 000

Control of

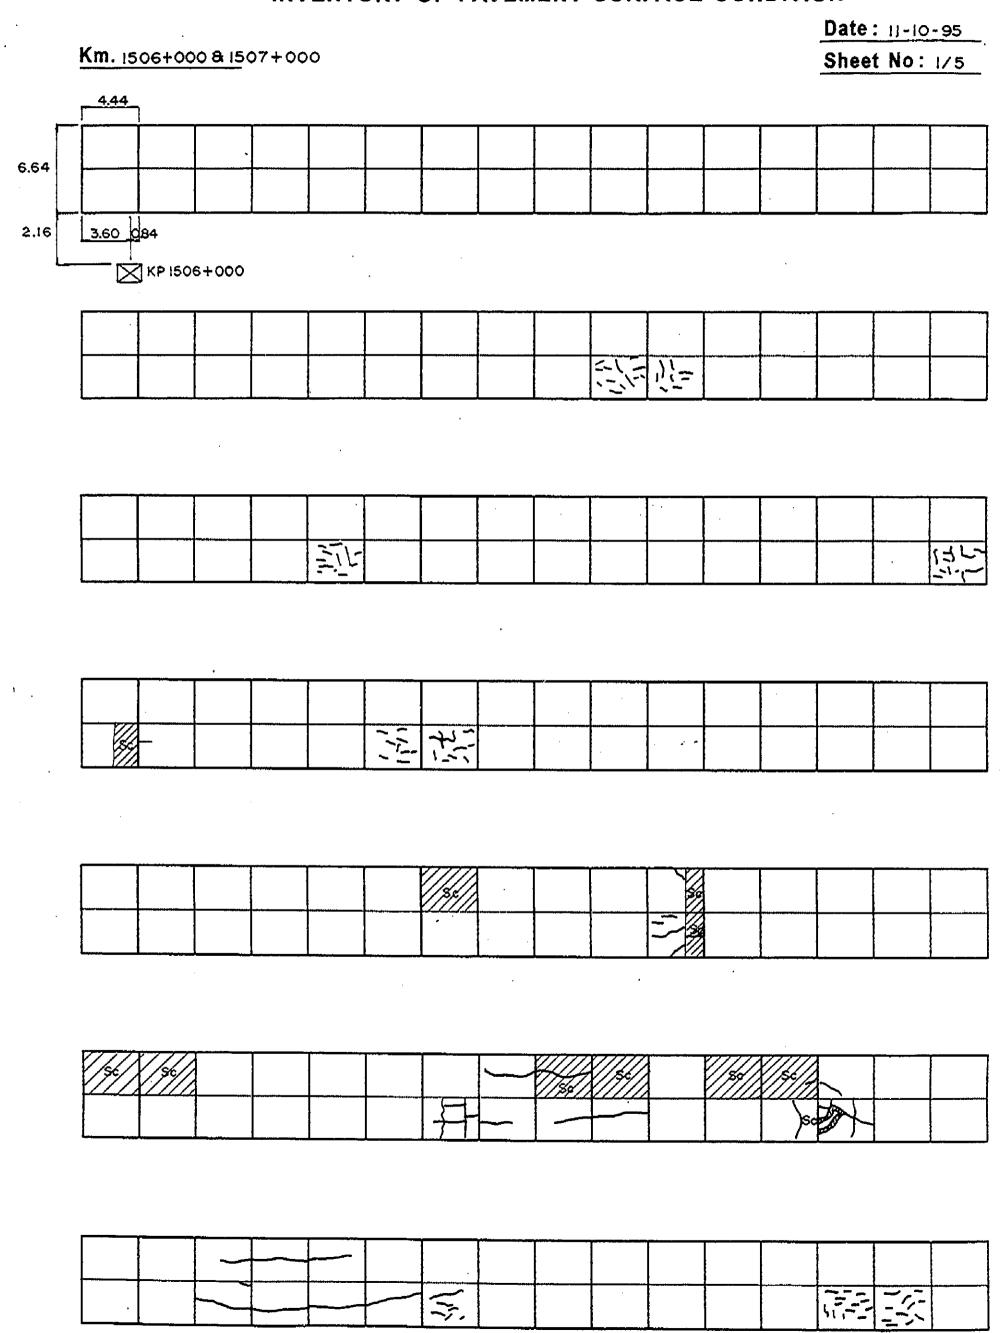


The state of the s

Date: 11-10-95 Km. 1506+000& 1507+000 Sheet No: 2/5 FC FC 5.15 3.95 Davao River Br. (L= 124,00) 9.40

Km. 15	06+00	008 150	7+000	)					: •					: 11-10 t No:	
		T		<b>\</b>			-			]					
				-											
	<u>i</u>	1	<u> </u>	<u> </u>		<u> </u>	<u> </u>		L	<u> </u>		1	1		
	I	T	,	1	1	T	<b>T</b>	· 1	<u> </u>	1	<u> </u>		<del></del>	<u>.</u>	1
						<u> </u>									
						<u> </u>	<u> </u>				_				
															-
					,			Ph	EcO	Es	F¢	Fc.	Ec		
				•••											
	<u> </u>	<u> </u>	<u> </u>		<u> </u>	1	V///	inkina	Fc	Fc	F¢	Fc			
							,								
		·	1	····	γ	·		T	r	<b>.</b>	,		Y	<u>,                                      </u>	<del>,                                    </del>
ļ		ļ							·						
												·			
							•								
													•		
						115						Sinking	Fc	Sinking	Sinking
						<u>                                   </u>		THE REAL PROPERTY.							
					<u> </u>	<u> </u>	Si	nkino	Sinking	Fc	F¢				
		,					,			•					
	1		<del>,</del>												
Sinking	Fc	∠Fe\	} Fc¶	-Fà	FC										
								· · · · · · · · · · · · · · · · · · ·				· · · · · · · · · · · · · · · · · · ·			
•			·		1	1		<u> </u>	l	·			<u> </u>		<u>.                                    </u>
		<u> </u>		<del></del>											
							//								
				,											

Date: 11-10-95 Km. 1506+0008 1507+000 Sheet No: 4/5


												,	Date	: 11-10	)-95
Km. 15	506+00	008 150	07+000	)									Shee	t No:	5/5
,								4.50	7			·			
			1					İ	11	T	Ţ	1			
			-						6.7	<del>-</del>			<u> </u>		1
			<u></u>	<u> </u>	<u> </u>	<u>.j</u>	<u> </u>	1						<u> </u>	
								2.502.0	_						
								$\bowtie$	KP 150	8+000					
									]						
				<b></b>							-		<del> </del>	<del> </del>	
Į	<u></u>	1		<u>.                                    </u>	.1	<u> </u>	1	<u>i</u>				1	1		
										1					
	d	1	1	•	<u> </u>	<u></u>									
·	<b>-</b>	·	· · · · · · · · · · · · · · · · · · ·												
	_				1		,								
		•	<del></del>	·	· • · · · · · · · · · · · · · · · · · ·	<b>-1-</b>			1	1	<u> </u>		<u> </u>	<u></u>	<u> </u>
								•							
	<del></del>	1	<u> </u>	1	<del> </del>	Υ	<u>.                                    </u>	<u> </u>	· · · · · · · · · · · · · · · · · · ·	1	T		<del>,</del>	1	т
					ļ <u></u>	·			<b>.</b>	<u> </u>					
								-				<u> </u>	<u> </u>		<del></del>
	<del>                                     </del>			1	1	<b>T</b>	<del> </del> -				1	1	<del>,</del>	1	ī
		<u> </u>	<u> </u>					•							
		•													<b></b>
			Γ			1				]	<b>1</b>	Γ			1
					<del></del>										
															-

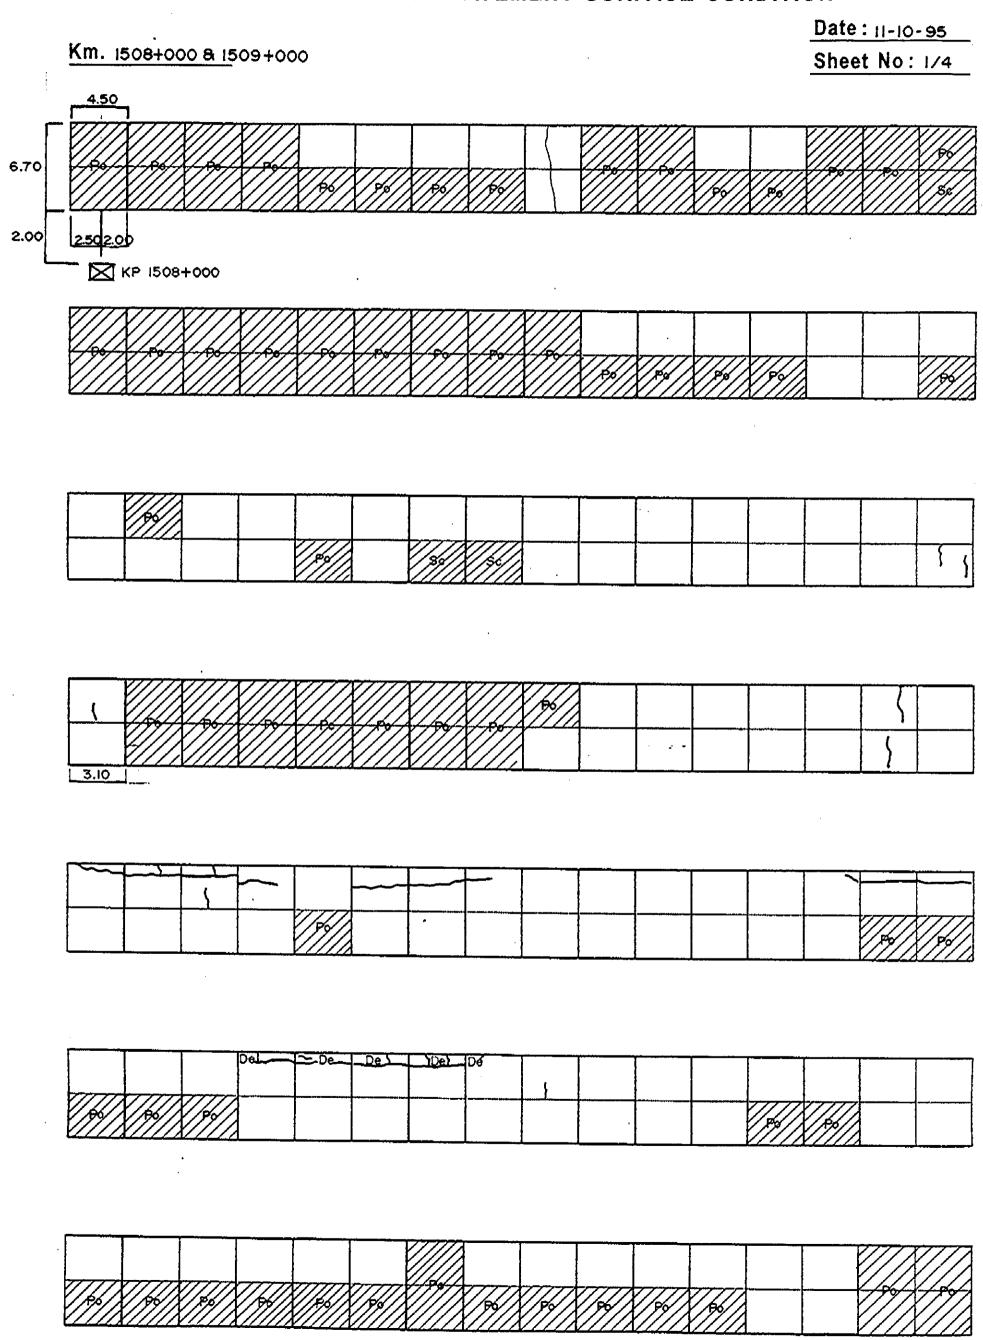

Km. 1508+000 & 1509+000

Date: 11-10-95

Sheet No: 2/4

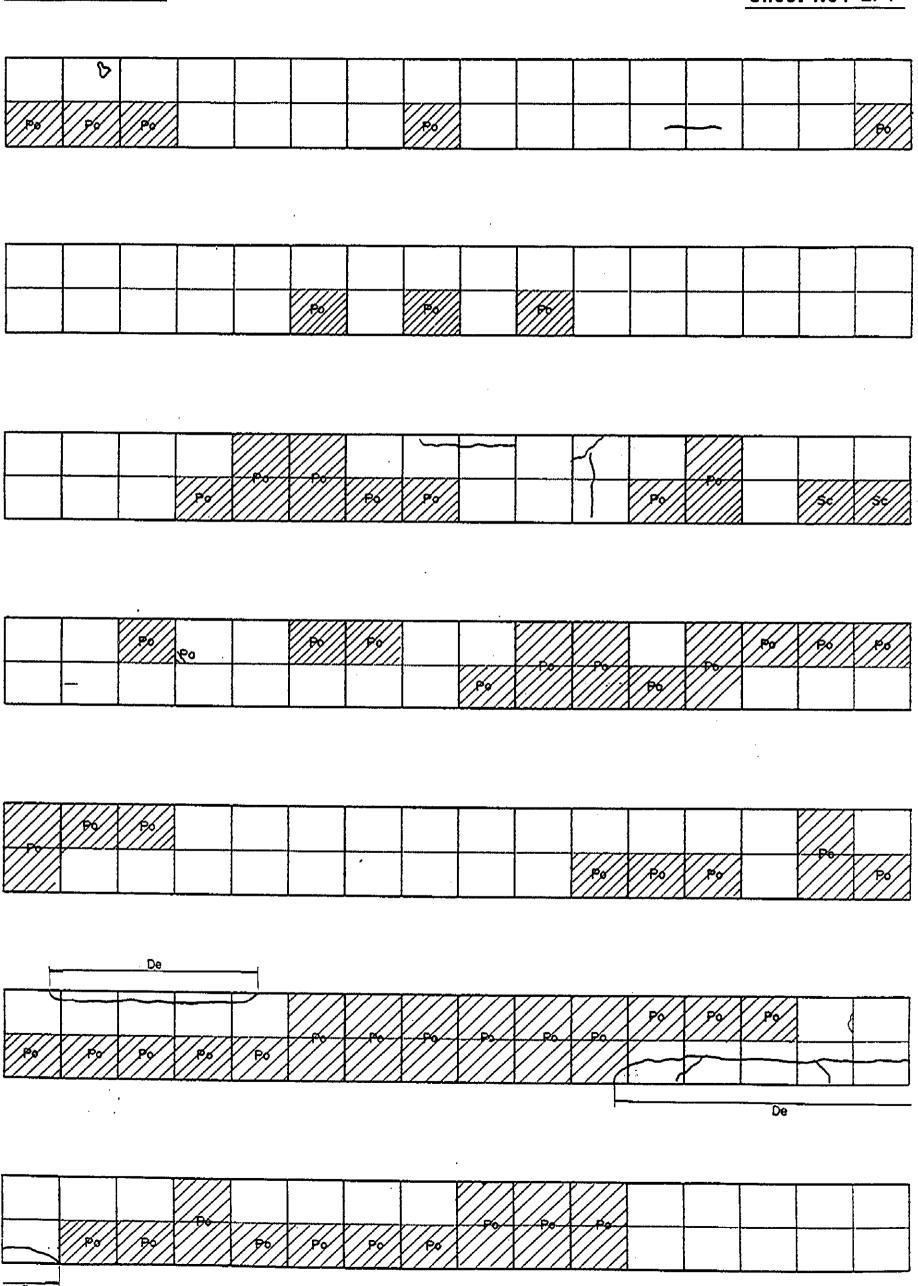


Date: 11-10-95 Km. 1508 +000 & 1509+000 Sheet No: 3/4 Flooded Area Flooded Area 3.00

Date: 11-10-95 Km. 1508+000& 1509+000 Sheet No: 4/4 4.50  $_{i},\zeta_{i},$ 2.68 135 3.15

The state of the s


KP 1510+000

and the second of the particular contraction of the second

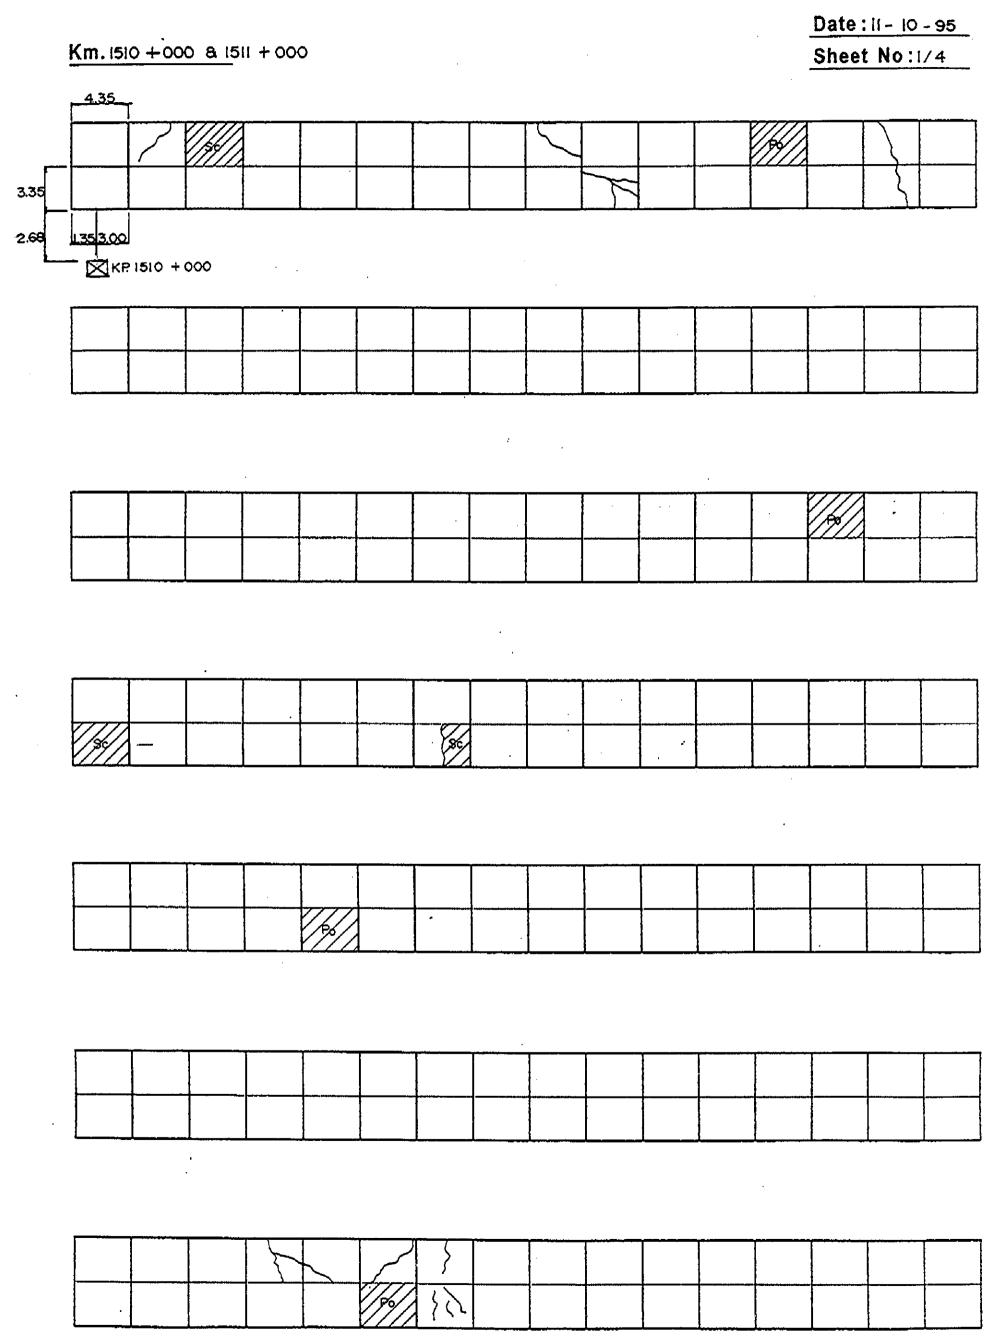

													Date	:11- 10	) <b>-</b> 95
Km.15	10 + 0	00 & 15	511 + 00	0										t No:	
												•	<u></u>		
<u></u>	<u> </u>	1	Т	T			1		1	T	1	<u> </u>	1	ł	
		<u> </u>	17777												
					١ ٢		3365								·
	_[	<u> </u>	5/////	4			1, - ,	l	<u> </u>	<u> </u>				<u> </u>	1
{		Ţ			Ţ					[		<u> </u>		<u> </u>	1
}			1	ļ	<del>                                     </del>	<u> </u>				<u> </u>			-		
			76												
										·	<u> </u>				<u></u>
								-							
		ļ	-						<del>                                     </del>	7777	1777	ZZZZZZZ Z	0/86/2	2.0	<u></u>
									\					心院	175
				•					•						
	<b>.</b>														
55%	~~	125	= 7	~2,E	~-:-	-72		} \ (	2~			7		-15	
13/1	2-7	ンバイ	1254	نې <u>ر</u> د.	-625	ベボ	メウン	イベン	77/1	<b>ード</b> で	7.2	~	7:5	775	=3
	1	Υ	<del></del>		<del> </del>	<del></del>				<del>/u-=</del> -u <sub></sub> .		····	<del>,,,,,,,,,,,,,,,,,,,,,,,,,,,,,,,,,,,,,</del>	<del></del>	<del></del>
	ŀ														
جيء	-6	<b>₹</b>	51	27		<u>.</u>		<u> </u>					1997		
75	<u> </u>	1,20		<b>ノ</b> ト	·										
			•									•			
7777		<del>                                     </del>			· · · · · · · · · · · · · · · · · · ·			· · · · · · · · · · · · · · · · · · ·	<del>////</del>	<del>,,,,</del>	17777		·r······		<u>,</u>
				,					79/	/%//	<b>P</b>				
						,	·								
	1	<u></u>	<u>!</u>		<u> </u>			· · · · · · · · · · · · · · · · · · ·					<u> </u>		<u> </u>
		•													
															•
	<u> </u>			<del></del> -			· T		ľ	, , , , , , ,			· · · · · · · · · · · · · · · · · · ·	1	ı
										1					
			/\$G/											*****	

	<u>Km.15</u>	<u>10 + 0</u>	<u>00 8 15</u>		0		0. 17	A • E 11			. AUL			Date	:II - 10 t No:	95 3/4
					<u> </u>		<u> </u>					<u> </u>	<u> </u>			
		<del></del>		<del>-</del> -				<u> </u>	<i>V]]])</i>	1	T		<del></del>		<del> </del>	
	•															
36/ 36/ 36/									)\{\\							
36/ 36/ 36/																
36/85/																
36/85/		[] 			[\$]											
		Γ					<i>Y/77</i> ]	<u> </u>	<b></b>	<del>.</del>	<u></u>	г	<del>                                     </del>	γ	I	<u> </u>
							/ <u>%/</u> )								/\$g/	5/
				···		····	<u> </u>		<u> </u>		!			<u> </u>		
1/8-/A 1/6-/X/c//Y/c//V/A/A										<del> </del>						
		\\\\\\\\\\\\\\\\\\\\\\\\\\\\\\\\\\\\\\							/ <u>\$</u>			[5¢]	/s/			/\$¢/
	777									////	////	7777				

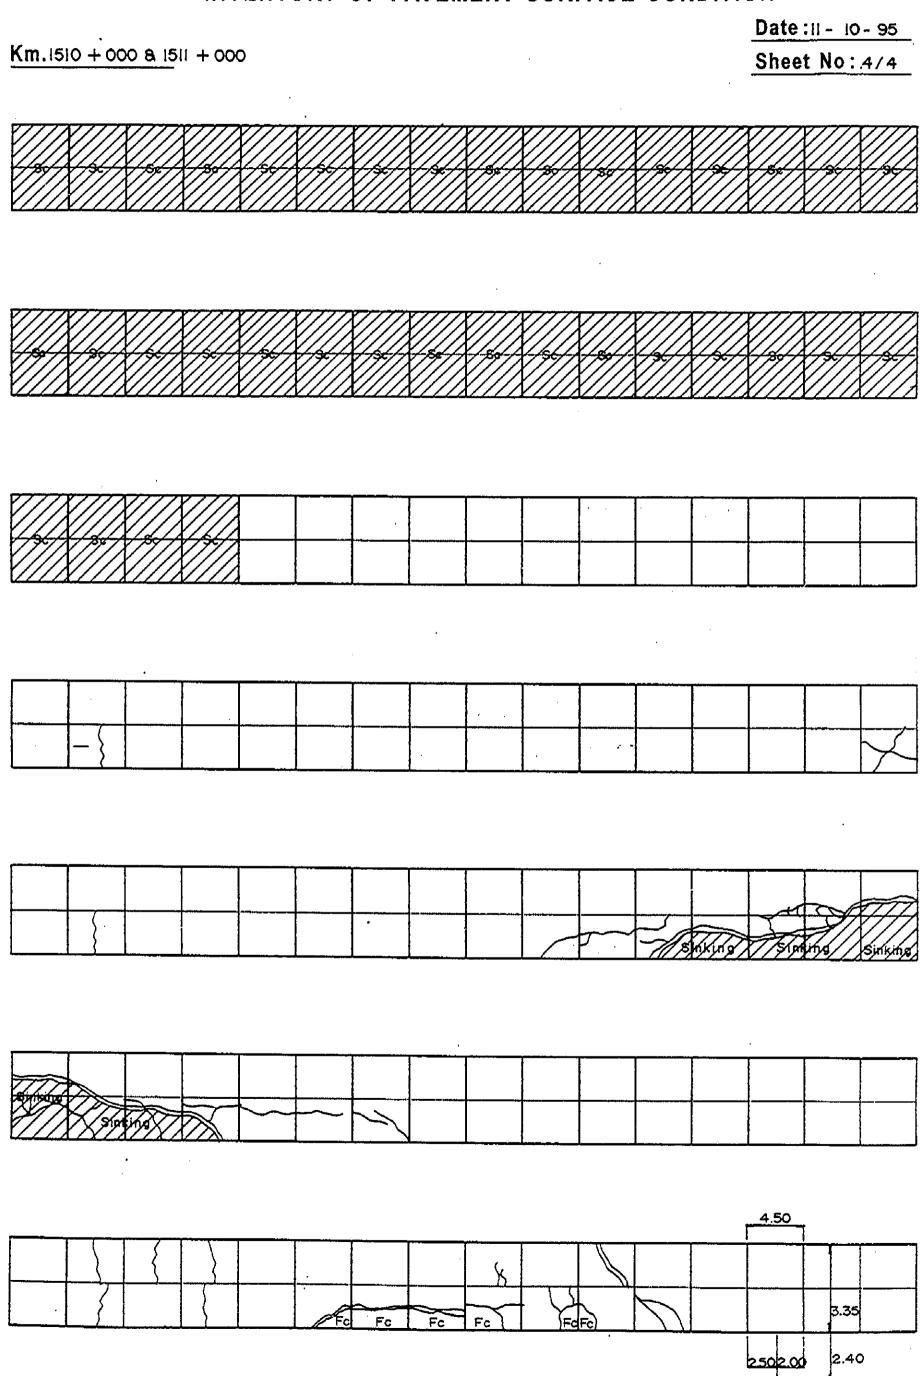

KP 1512 +000

Date: 11-10-95 Km. 1512 +000 - 1515+000 Sheet No:1/8 4.50 6.70 2.40 2.502.00 1.40

Date: 11-10-95 Km. 1512+000 - 1515+000 Sheet No: 2/8 OL 1.30

<u>Km.1512+000 - 151</u>5+000

Date: 11-10-95
Sheet No: 3/8

										•			
\\\\\\\\\\\\\\\\\\\\\\\\\\\\\\\\\\\\\\													
13//2										\\\\\\\\\\\\\\\\\\\\\\\\\\\\\\\\\\\\\\			
				De De					<b>1</b>		<u> </u>	~~~~	
								÷					
				<del></del>						***************************************			
(//////////////////////////////////////		1			1	<u> </u>	£		<u> </u>	<u> </u>		<u> </u>	<u></u>
	,												
										//%//			
		3////	V / / / /	<i>V./././</i> .		<u> </u>	L	1/////	1	1/////	<u> </u>	<i>V////</i>	<u> </u>
					•								
							<u> </u>						
								·					
		4		******		1 <u> </u>				<u> </u>			l
				•									
		·	·	1	·	<u>V. /. /. /. / /</u>	1	1/////	<i>V-7-7-7</i>	<i>V.Z.Z.Z.</i>			<u>i.                                    </u>
											,		
					· ·								
						•	-		-			•	sene alakakakak
	( )	1-3	11	-	_								
		\\\\\\\\\\\\\\\\\\\\\\\\\\\\\\\\\\\\\\	1,							}			
· · · · · · · · · · · · · · · · · · ·	-					7							<u> </u>

1.30

i o

Date: 11-10-95 Km. 1512+000 - 1515+000 Sheet No:4/8 1.30 3.60 3.80 4.90 Pandi Br. (L=99.00) · <u>2.35</u>

Km. 1512+000 - 1515+000

Date: 11-10-95

Sheet No: 5/8

	Sileet No. 5/8
\\\\\\\\\\\\\\\\\\\\\\\\\\\\\\\\\\\\\\	
	<u> </u>
<u> </u>	<i>?}/}\/?</i> \$/ <i>}\/?</i> \$//}\/}
VIII XIII XIII XIII XIII XIII XIII XIII	~~~~~~~~~~~~~~~~~~~~~~~~~~~~~~~~~~~~~~
<u> </u>	<u> </u>
\\\\\\\\\\\\\\\\\\\\\\\\\\\\\\\\\\\\\\	<i>~~~~~~~~~</i>
	<u> </u>
•	
\\\\\\\\\\\\\\\\\\\\\\\\\\\\\\\\\\\\\\	<del>\\\\\\\\\\\\\\\\\\\\\\\\\\\\\\\\\\\\\</del>
<u> </u>	
2.00	
\\\\\\\\\\\\\\\\\\\\\\\\\\\\\\\\\\\\\\	<del>~~~~~~~~~</del>
	<u> </u>
·	
<i>\\\\\\\\\\\\\\\\\\\\\\\\\\\\\\\\\\\\\</i>	
\\\\\\\\\\\\\\\\\\\\\\\\\\\\\\\\\\\\\\	<del>/////////////////////////////////////</del>
<i>\\\\X\\\\X\\\\X\\\\X\\\\X\\\\X\\\X\\\X</i>	///X///X///X///X///X///X////

Date: 11-10-95

Km. 1512 +000 - 1515+000	Sheet No: 6/8
	X///X///X///
<u> </u>	<u> </u>
	•
	/X////X////X/////X/////
<u> </u>	<i>X///X///X///</i>
	X///X///X///X
<u> </u>	<i>B((()X(())X(())</i>
	787777787777
<u> </u>	<u> </u>

Date: 11-10-95 Km. 1512+000 - 1515+000 Sheet No: 7/8

	•								•				Date	: 11-10	)-95
Km. 15	12+00	0 - 151	5+000										Shee	t No:	8/8
												•			
	7	1.	Ţ	<u> </u>	<del>                                     </del>	<del></del>		X////	1	Ī	1	<i>V///</i>	X////	<b>Y</b> ////	<del></del>
	<u> </u>		77777	17777					1						1
			/59//		X/\$\/										1
		1	<u> </u>	X/////	<u> </u>	<i>X2.7.7.7.</i>	X/////	1	.1	<u> </u>		<b>X</b> ////	8////	<i>Y////</i>	1
			•												
7///	<i>X////</i>	X////	X////	X////	X////	X////	<i>X/////</i>	X////	1		V////	<i>X////</i>	<del>a .</del>	1	1
									1				1	<b>,</b>	<b></b>
											<i>\\\\\\</i>				
		<u> </u>	1////		<u> </u>	<i><u> </u></i>	<u> </u>	<u> </u>	<u> </u>	<u> </u>	<i>Y/////</i>	X/////	8/////	<u> </u>	<u> </u>
				V////	<i>V////</i>	X////	<i>V////</i>	V////		1	V////	<i>V////</i>	<i>V////</i>	X////	<i>V////</i>
	V11111	77777	277777												
				X-1-1-1-1-1	V. C. C.	<u> </u>	<u> </u>		<i>X/////</i>	<i>X/////</i>		<i>(////</i>	<i>Y////</i>	8/////	<i>X.L.L.L.</i>
			•												
•															
		T ·	T -		<u> </u>		]	}			1	r	7	l	
77777	7777	27777						·	}	*****			<u> </u>		
															,
								<u>.                                    </u>		<i>X././././</i>	<u> </u>	<i>V././//</i>	<u> </u>		<u> </u>
													•		
			X////			1				V////	·				
						77777	77777	777777	77777		77777	~~~~~		22777	77777
					*/			<u> </u>			<u> </u>	<i>V./</i>	1/////	<i>//////</i>	<u> </u>
		••													
	}		7				1								
77777		11111	77777		/////	0000		ļ. <u></u>				ļ	77777	77777	
		•								•	<u> </u>	·			
				•			-	End of P	roject ( E	nd. Dave	o Divers	ion Road	<b>i)</b> .		
										. <u>, , , , , , , , , , , , , , , , , , ,</u>	. 1313+9	<del>43</del> )			
	//5///	<i>\////</i>	<i>\////</i>			<i>\////</i>									

