


Date: 10-21-95 Km. 1312+000 Sheet No: 2/3 Pa Embankment Slip

OBS 3.65		 Km. ₁₹	<u> </u>	<u> </u>					·							: 10-2 t No:	
		. O	1		00		•	·		<u> </u>			•				<u> </u>
	,				:			<u> </u>	<u>,</u>	<u>!</u>	<u> </u>			<u>} </u>	<u> </u>		
								,									Γ
					•												
	[· -
													·				
	:											,					
					·	L .,	<u> </u>	<u> </u>		<u>1</u>	<u> </u>		I		<u> </u>		<u> </u>


INVENTORY OF PAVEMENT SURFACE CONDITION Date: 10-21-95 Km. 1313+000 Sheet No: 1/2 4.50 2.25 6.70 0.85 3.65 KP 1313 + 000

INVENTORY OF PAVEMENT SURFACE CONDITION Date: 10-21-95 Km. 1313 + 000 Sheet No: 2/2 2.90 De De р́е De Robe De De Po De De De De 6.70 3,60 0.80 3.70


| KP | 3 | 4+000

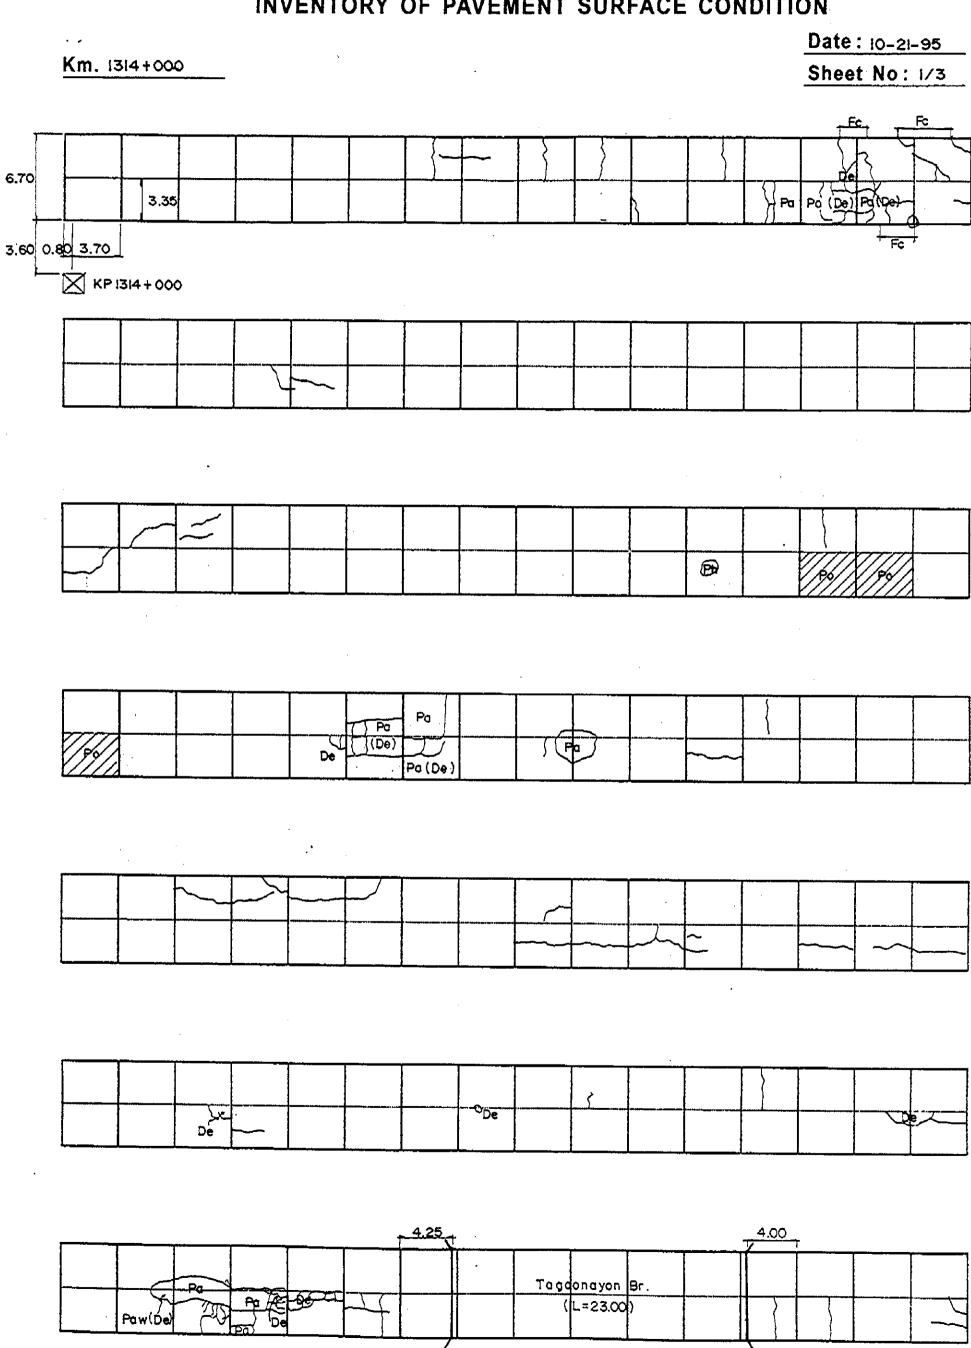


Date: 10-21-95 Km. 1314+000 Sheet No: 2/3 **₹\$**€⊘ Po Pa Pa 4.70 Pa Pa Pa Pa Be yugan II Br. (L = 22.00) Pa Pa

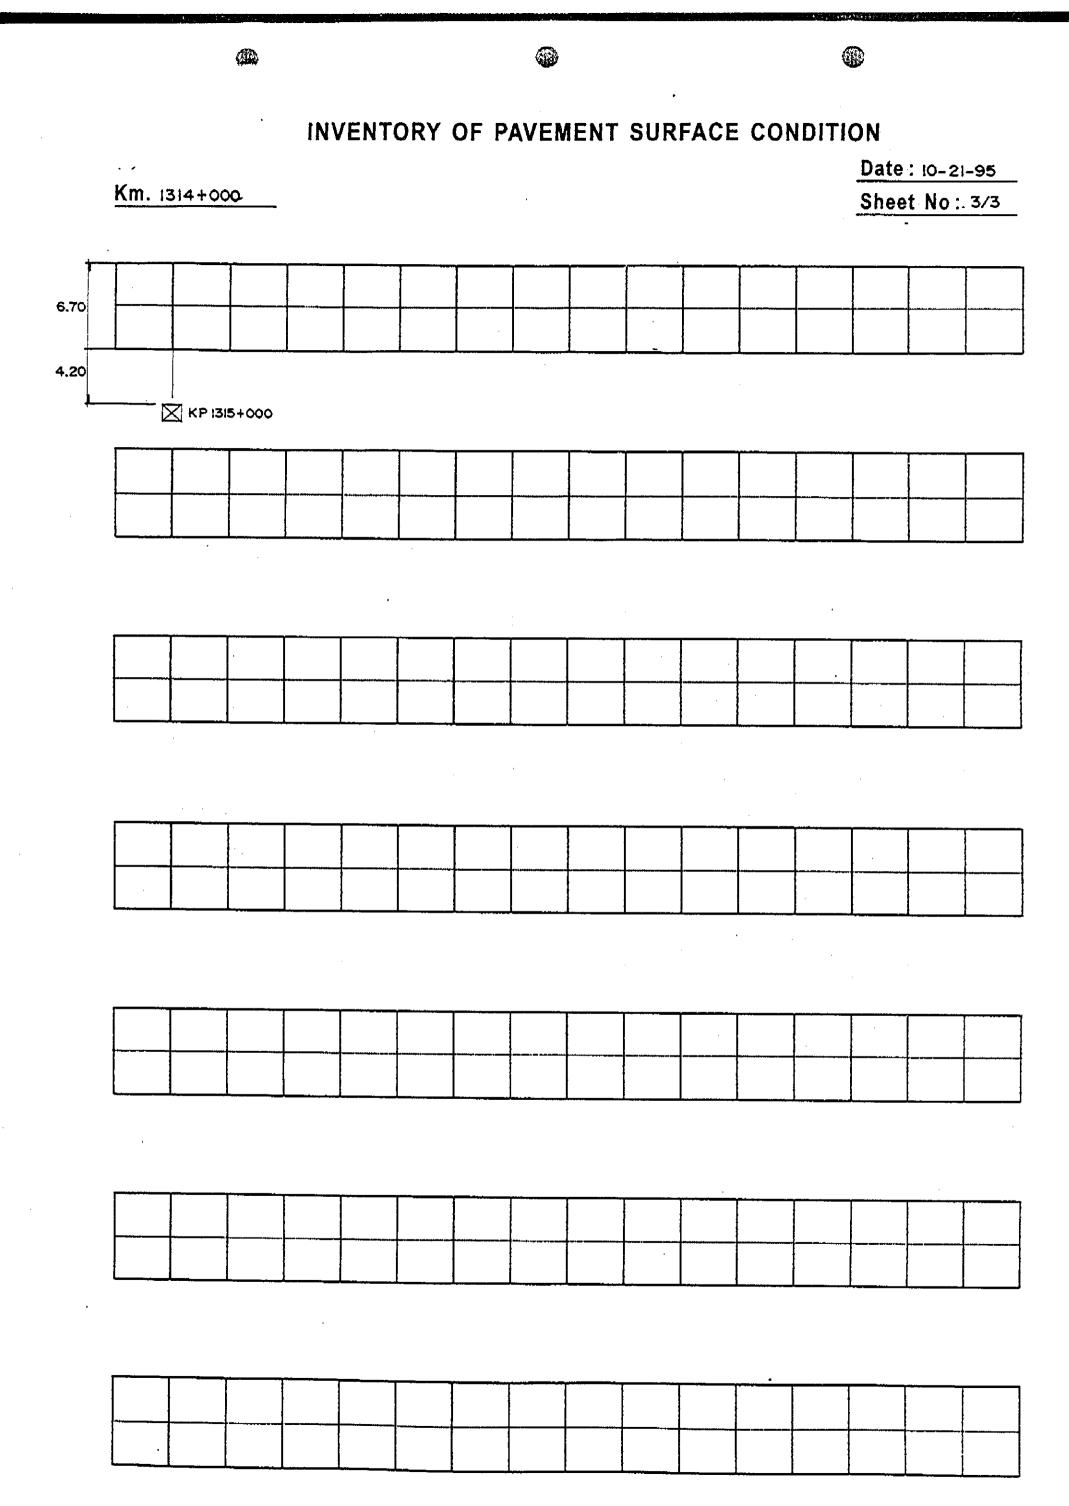


Date: 10-21-95 Km. 1315+000 Sheet No: 1/2 6.70 4.20 XP1315+000

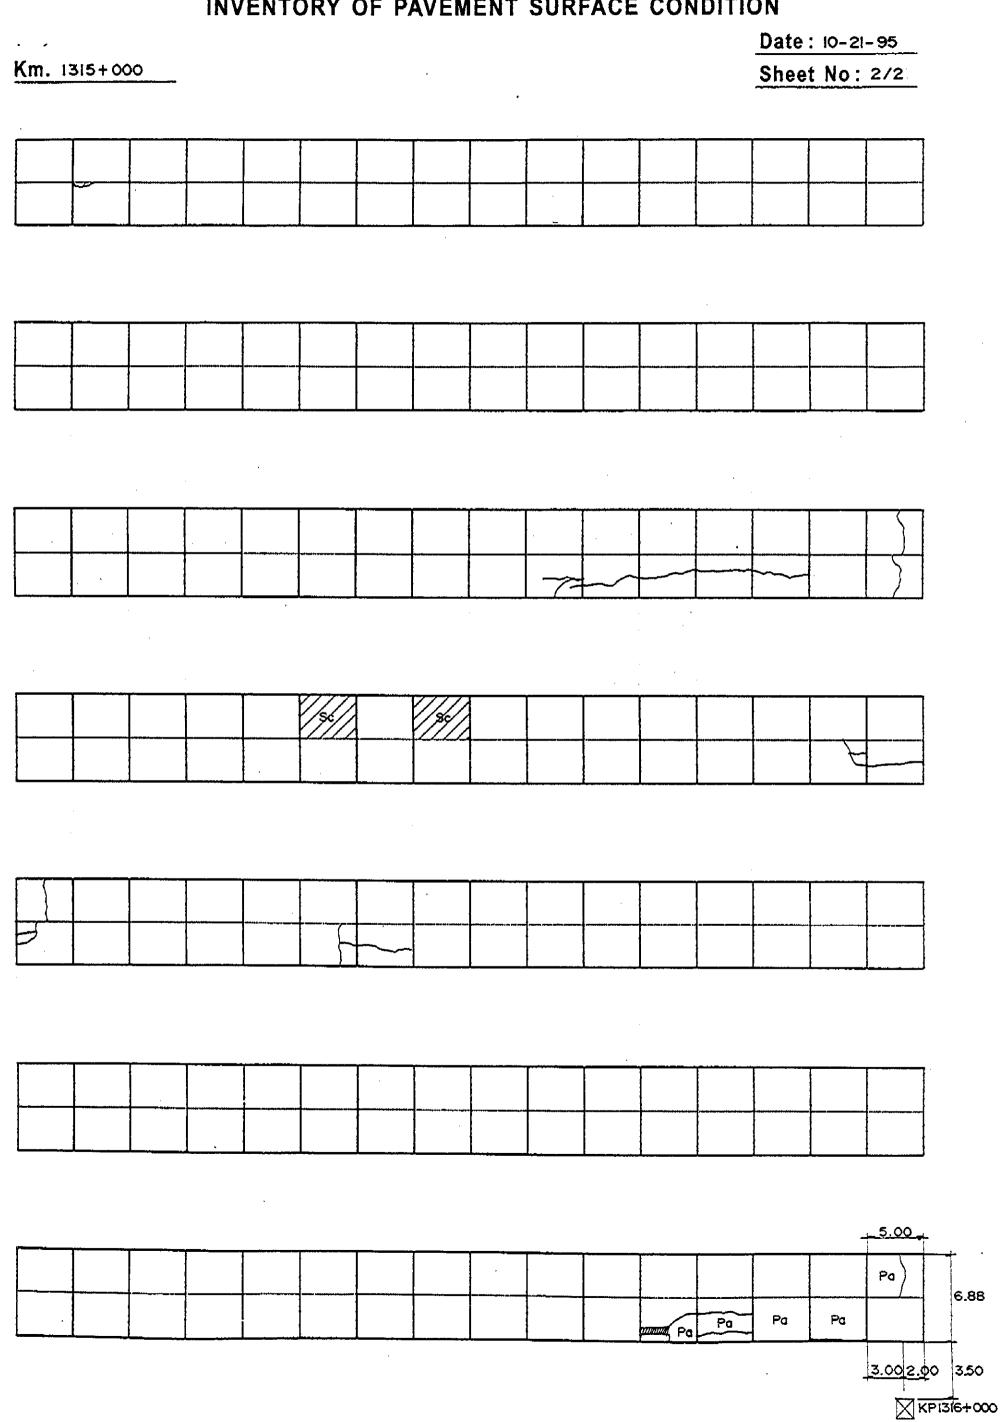


INVENTORY OF PAVEMENT SURFACE CONDITION Date Sheet

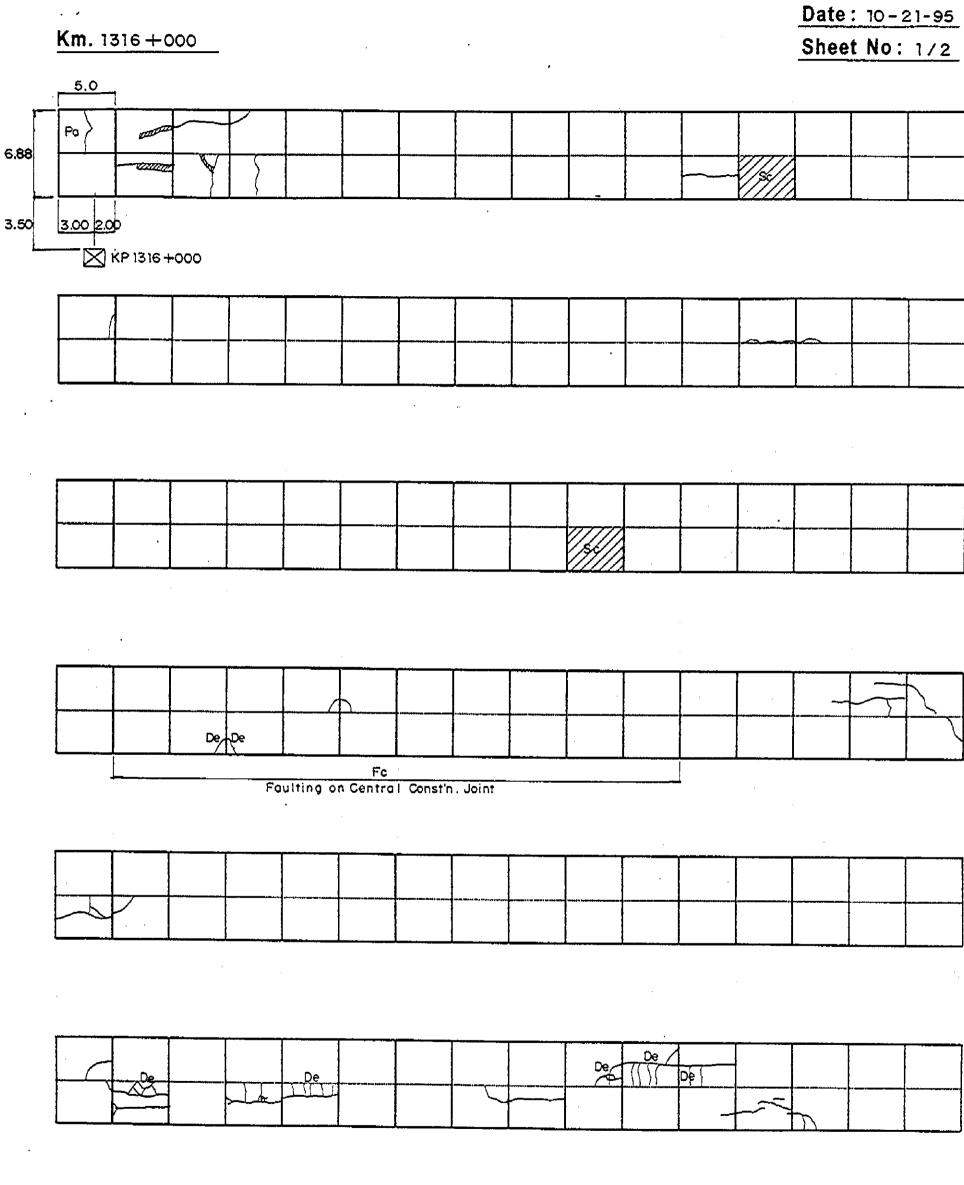

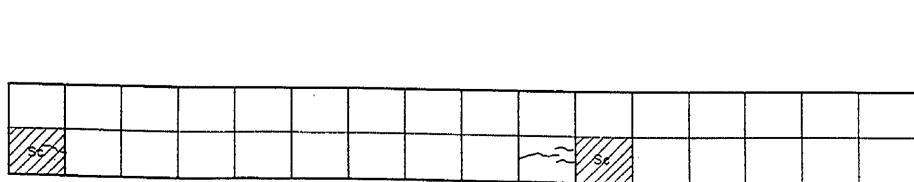

INVENTORY OF PAVEMENT SURFACE CONDITION Date: 10-21-95 Km. 1316+000 Sheet No: 2/2 0.80 3.70

KP 1317 +000

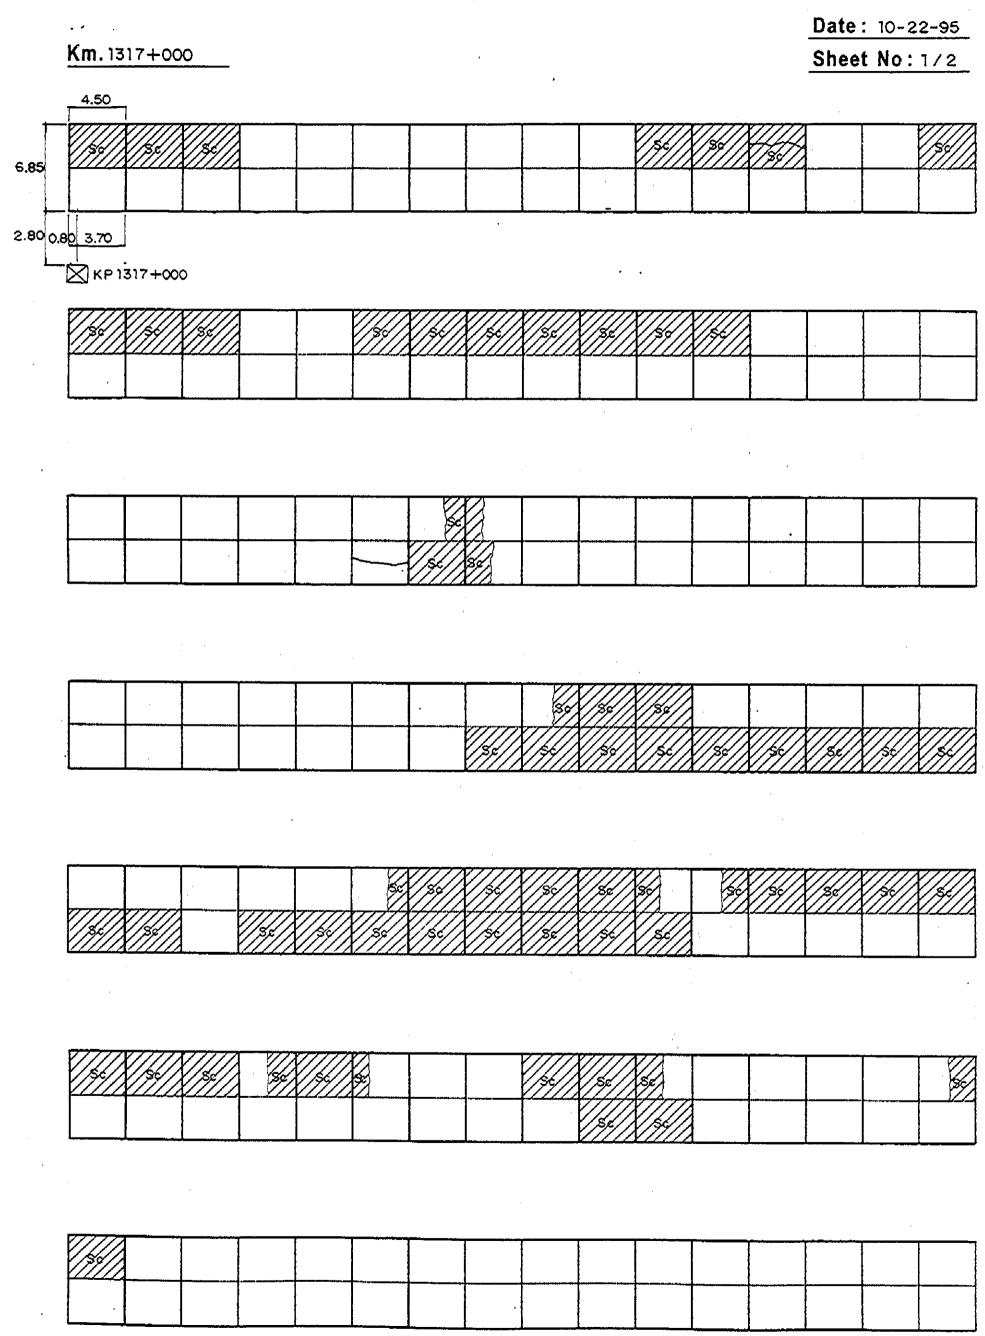

			INV	/ENT	ORY	OF P	AVEN	IENT	SUR	FACE	COI	IDITI	ON		
													Date	: 10-2	2-95
Km.1	317+00	<u> </u>		•									Shee	t No:	2/2
								•				•			
	T.	1	T	<u> </u>			Υ	T]	V////	V////	1			1
~~~		-	<u> </u>	<u> </u>								1			
									,						,
							,							•	<u> </u>
				3.00		•	٠.				17	6.60	) ]		
								_							
· · · · · ·	₽ <mark>De</mark>	<u> </u>	\			(	nagasio L= 32.0	h <u>8r.</u> D)		<u> </u>					
			}				<u> </u>								
,						,						•			
	<del></del>	T	····	1	Υ	T	, <del></del>				,				17777
						İ									135/
											<del></del>				
		1	l	<u> </u>	<u> </u>	<u> </u>	<i>\////</i>		1	}			<u> </u>		
•									•						
			V////	V////	V////	V////	ł		<u> </u>	1		X/\$Z/X/	<u> </u>		
	<b>2</b>							<u> </u>	V2777		89/		:		
	B		İ			<u>.</u> :			/ <u>\$</u> \$//		30				
						•		-			<i>K. Z.</i>	1.7.22.			
,															
		<u> </u>						<u> </u>		<del> </del>					
		<u>l</u>	<u> </u>												
													•		
	<u> </u>	T -		Υ	1	1		<u> </u>	<u> </u>	·		<del></del>			
	<u>l.</u>			J	<u> </u>	<u>i</u>				<u> </u>	<u> </u>		<u> </u>		<u> </u>
												4.50	_		
	T						1	<u> </u>	T	Į			Ţ <b>Ţ</b>		
···						ļ							6:70		
			_												
	<del></del>		<u>.</u>	<u></u>	1	1	<u> </u>	<del></del>	<del></del> -	<u>.                                    </u>	<u>!</u>				)
									•		;	2.05 2.45	- 1		
												$\times$ K	P 1318+	000	





Date: 10-21-95 Km. 1318+000 a 1319+000 Sheet No: 1/4 4.50 6.70 2.30 2.05 2.45 

								Date		1-95
Km. 1318+000 & 1319+000			•					Shee	t No:	2/4
		<del></del>		1	I			1		1
				1	<u> </u>	<u> </u>		<u> </u>	<u> </u>	
							,	:		
					·					
			<u></u>						-	
										1
<u> </u>			<del></del>	<b></b>		·			···.	
		· · · · · · · · · · · · · · · · · · ·								
					•					
									300	
		,								
				<u> </u>		,				<u> </u>
De			\ \ <u>\</u>							

Date: 10-21-95 Km. 1318 +000 a 1319 +000 Sheet No: 3/4

<u>Km.</u>	13	18+00	<u>0 a 131</u> 9	9+000				· .						: 10-2 t No:	
		}						 \\\							
			•	**************************************	A	·	<u> </u>		••••••• <u>•</u> ••••	<b>.</b>			<u> </u>	•	
														,	
					,					,					{
	***************************************		,												
															٠,
					}						4.50	6.70			
<u></u>								<u> </u>	<u> </u>		<u> </u>				
											3.90 X KP 1	1			

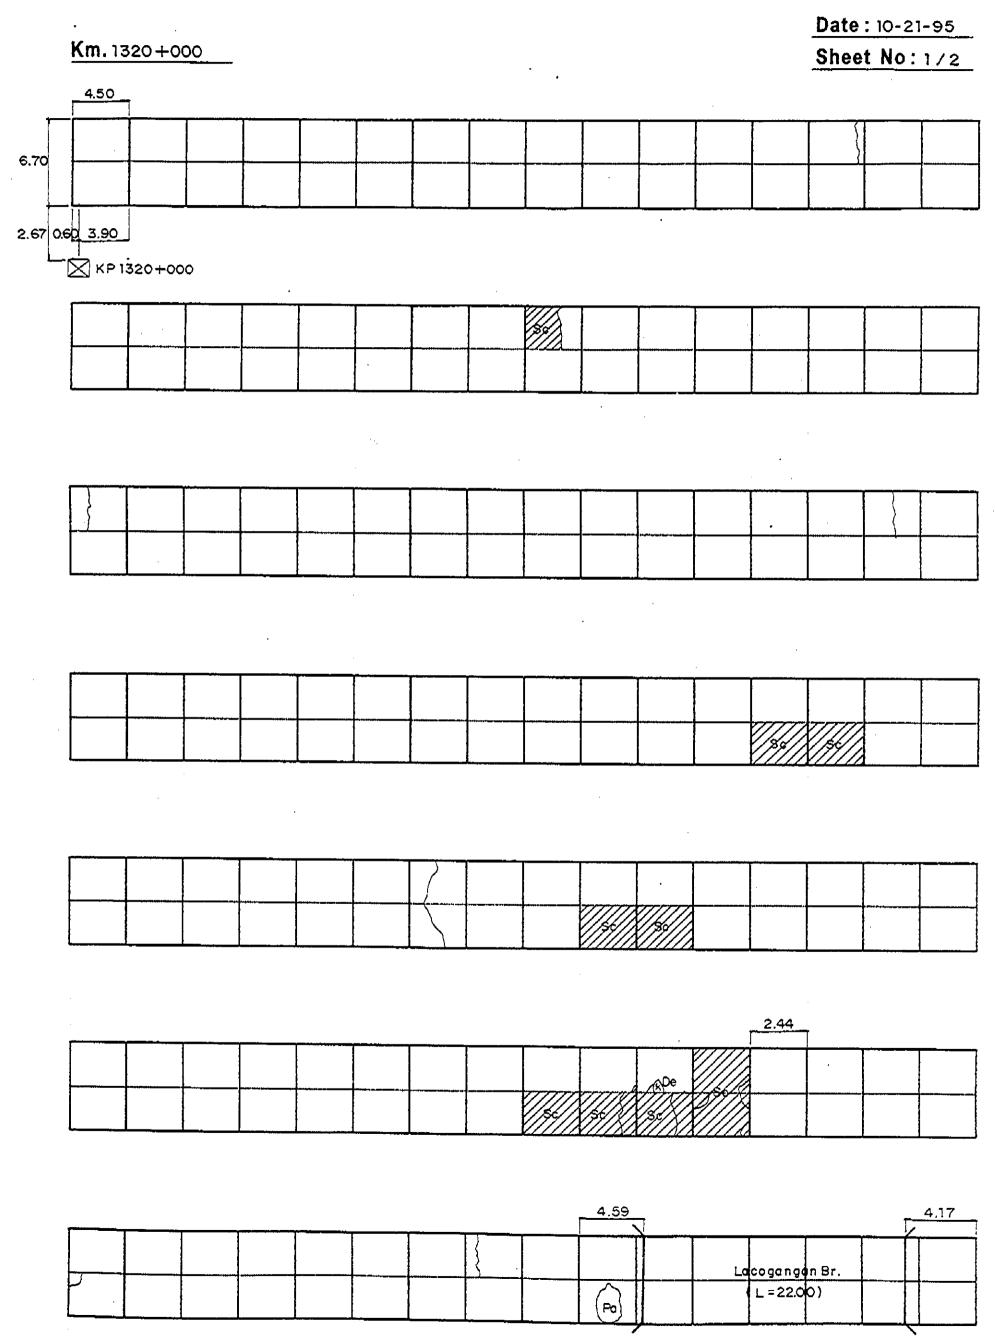


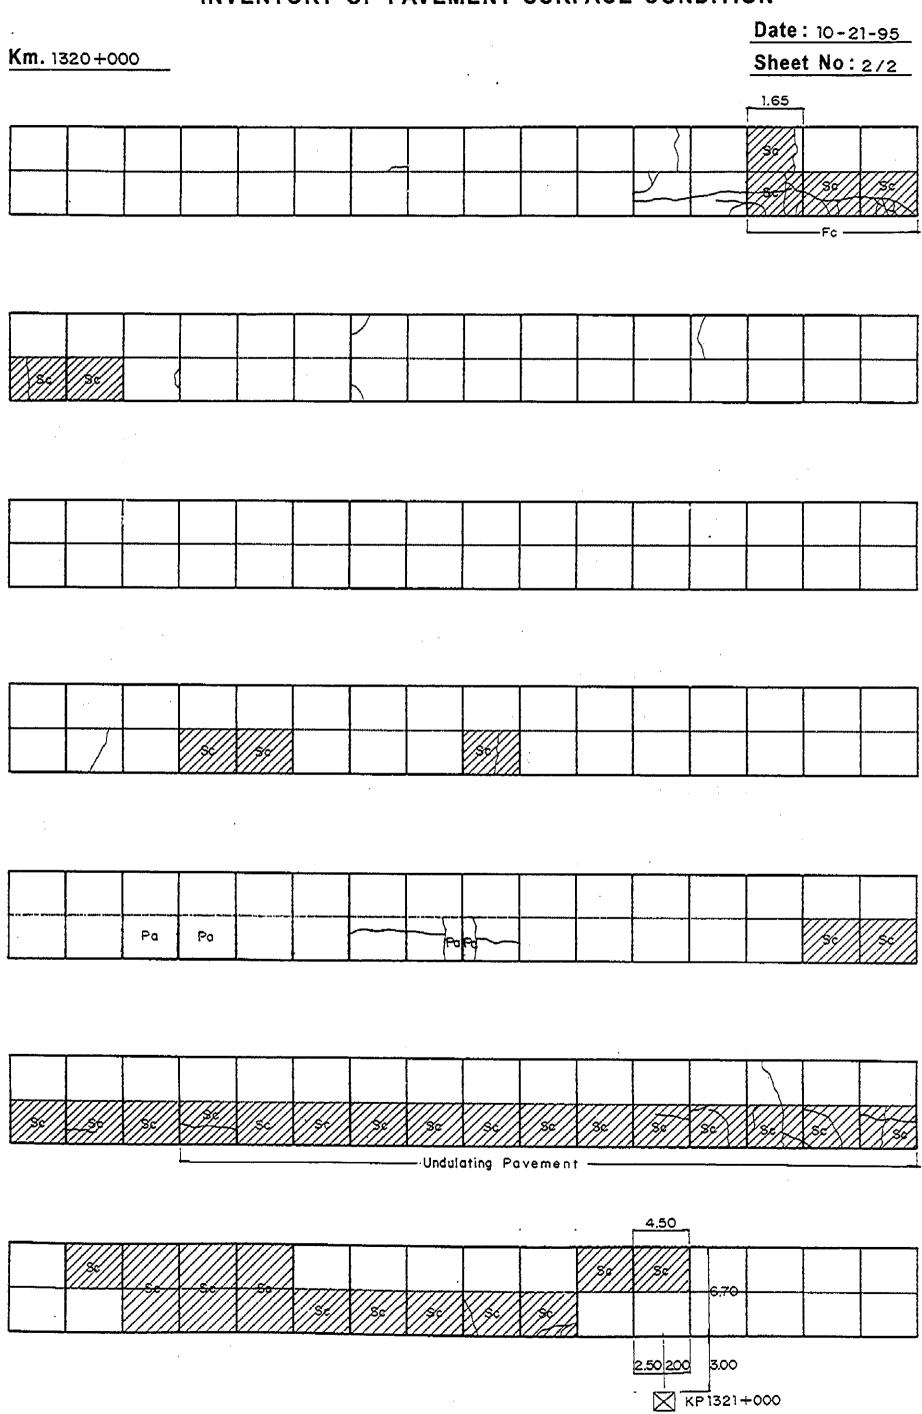


Date: 10-22-95 Km. 1321+000 Sheet No: 1/3 4.50 -Gravel Section ₹ 98.00 M 3.00 2.50200 KP 1321+000 3.50 Gravel Section Gener France

Sheet No: 2/3
35/ 35/ 35/ 35/ 35/ 35/ 35/ 35/ 35/ 35/

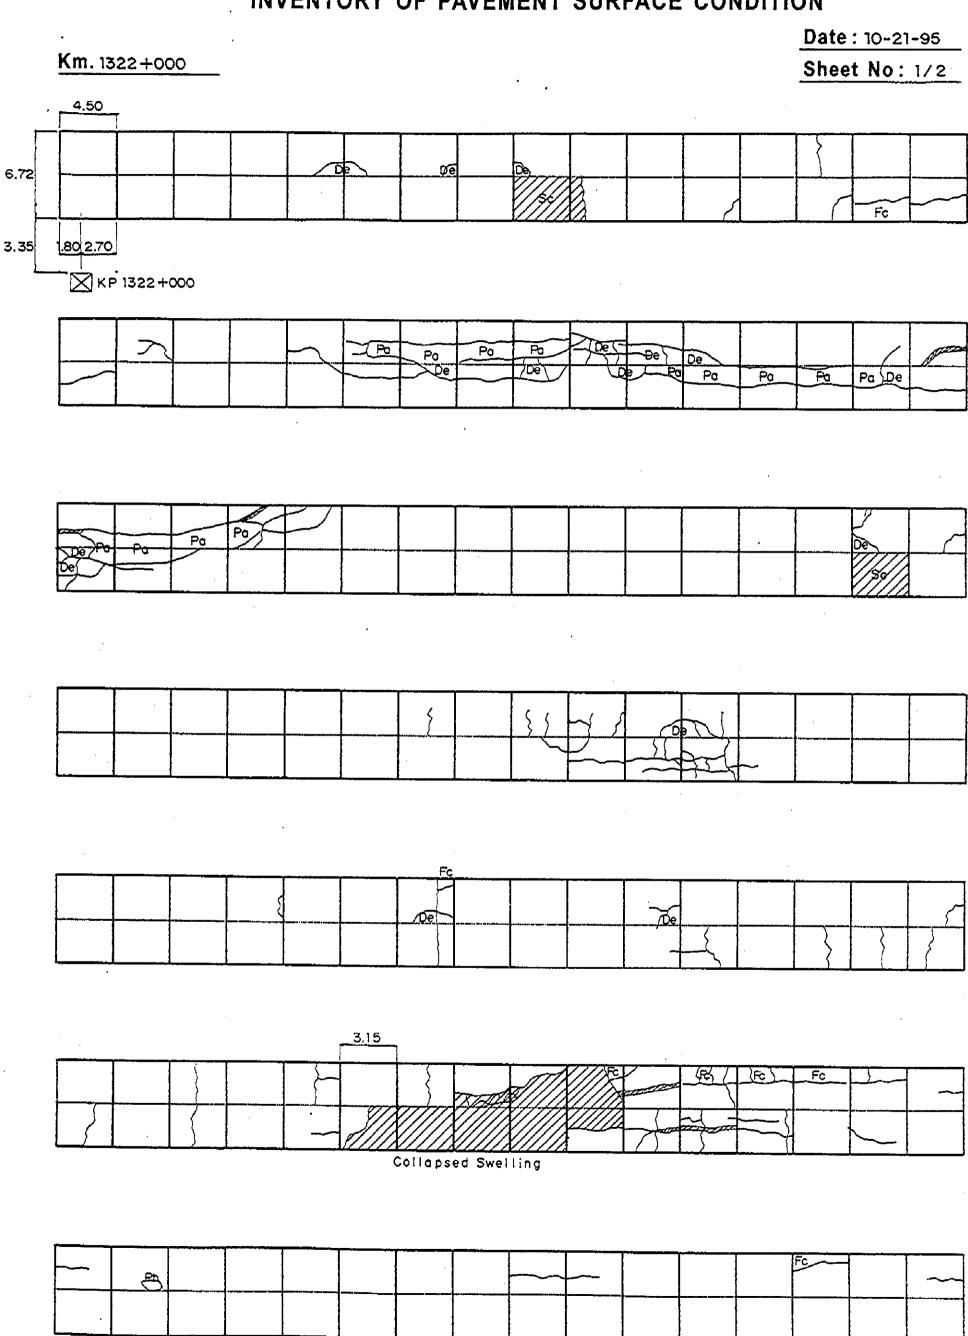


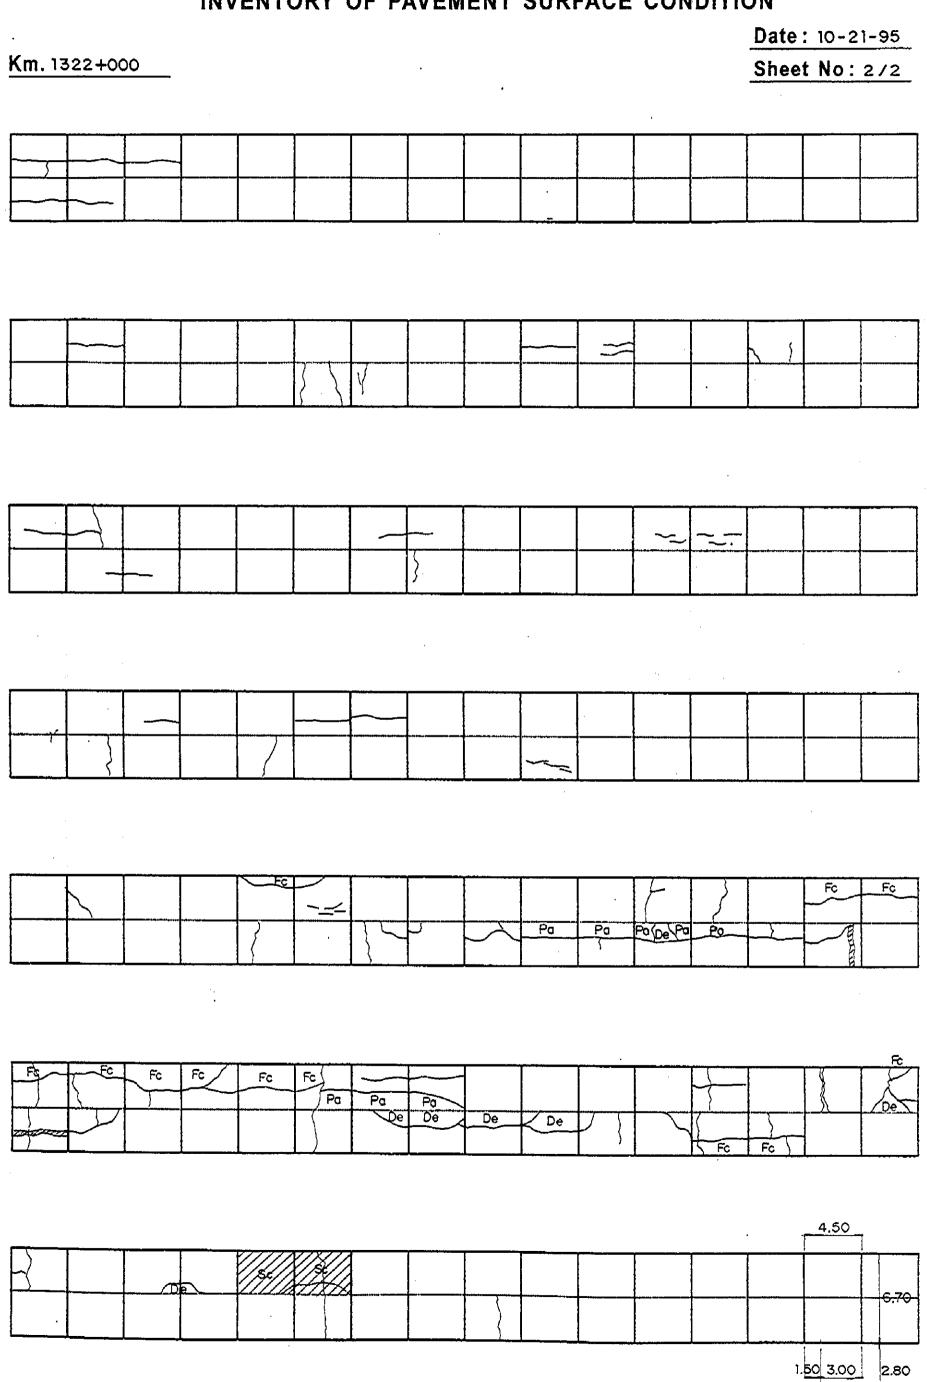

KP1323+000

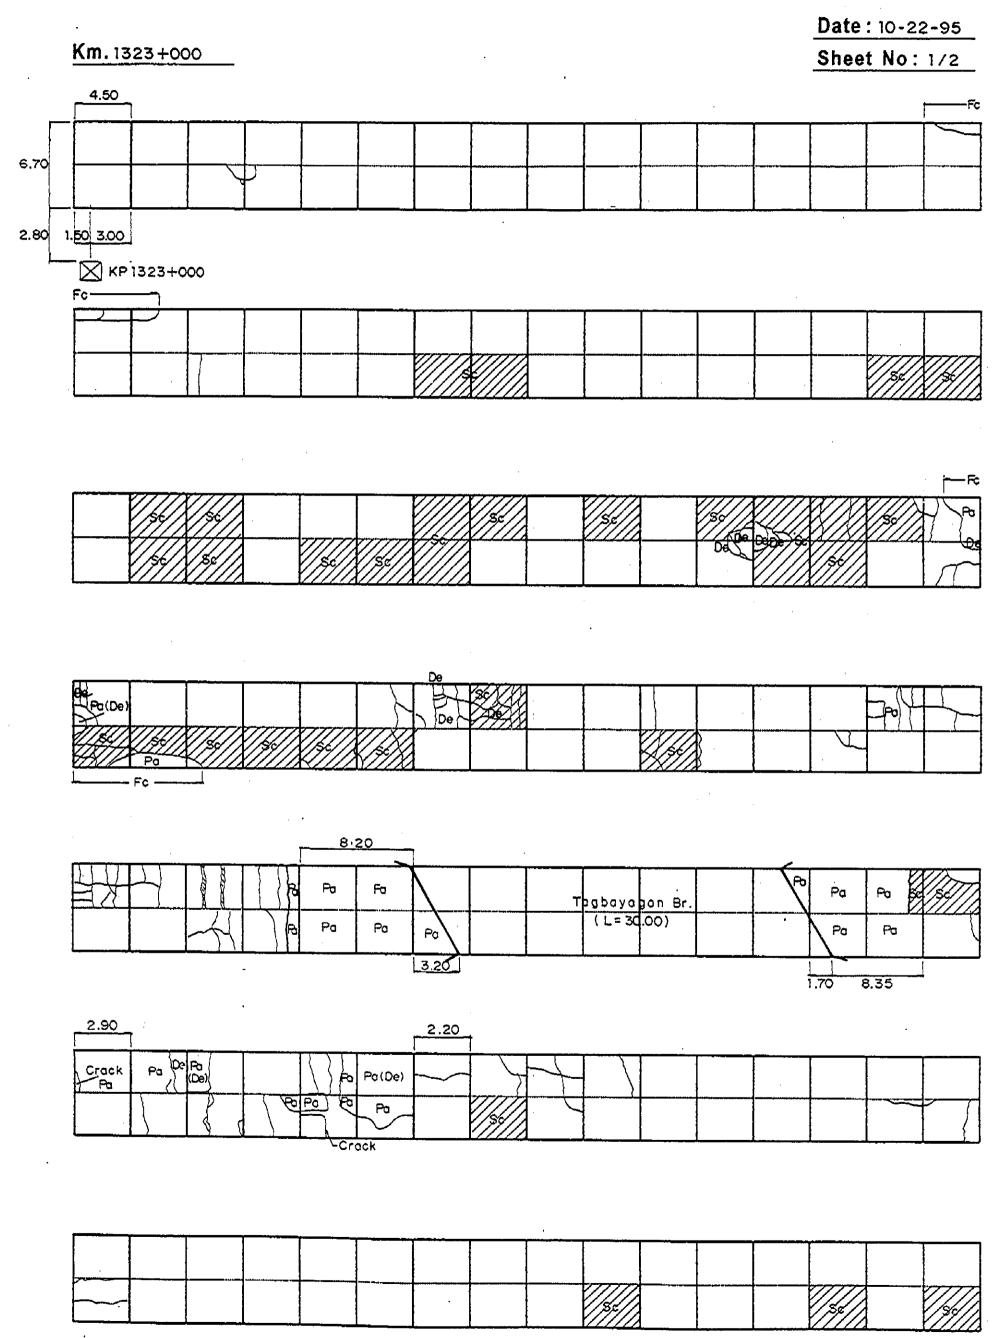

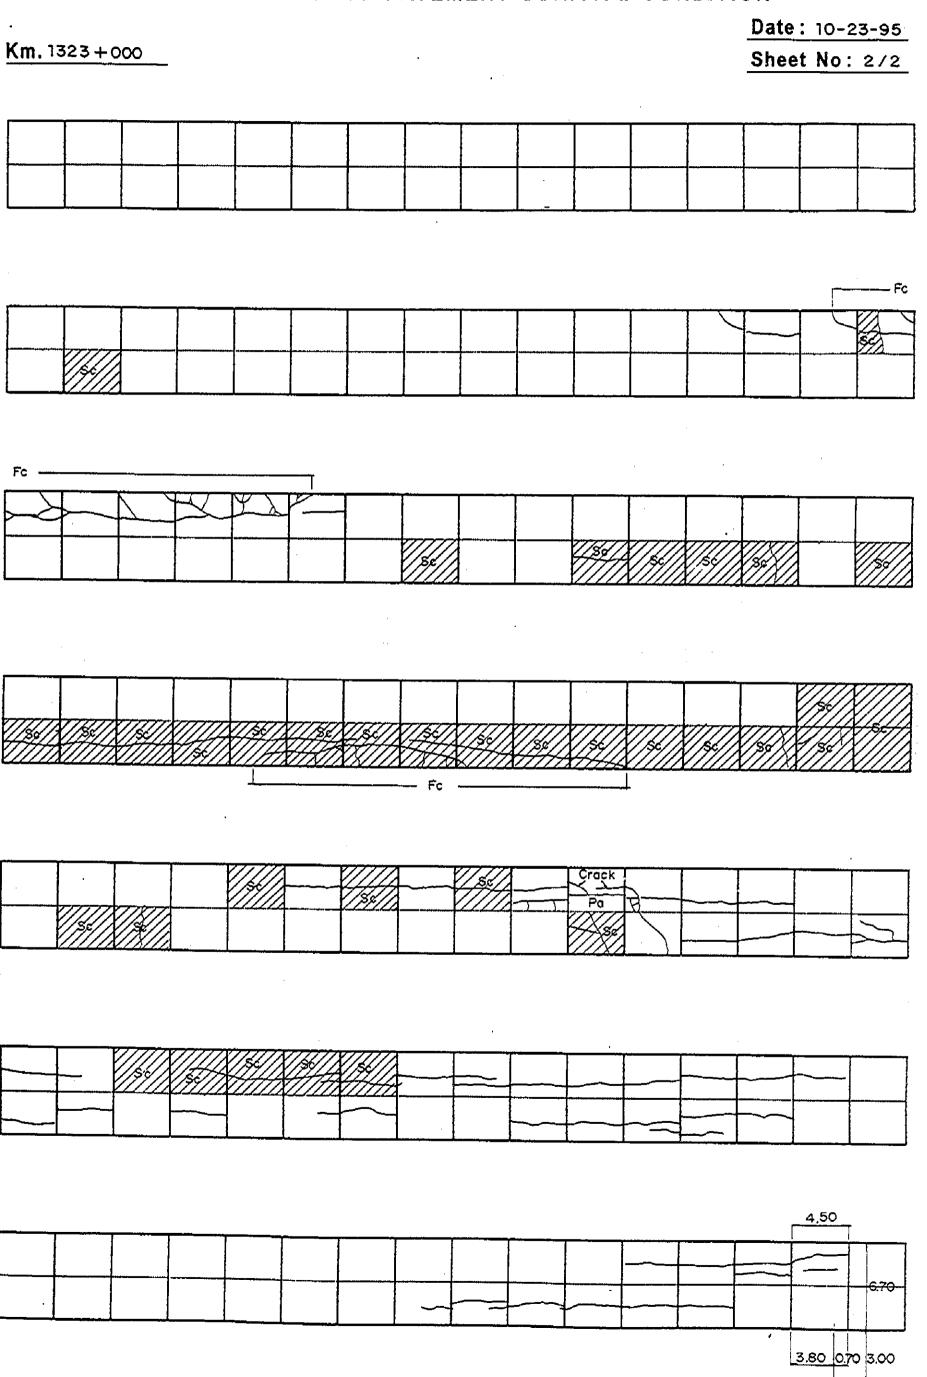

×P1324+000

