
Sheet No.

200

Thana	Chuadanga	
Union	Pourashava	-
Mouza	Hat Kaluganj	-
Location	Girl School (Urban-2)	<b>-</b>


Drilling No.	GeCC-1	
Date	29/Jan/200/	
Core recorder	Suenaga	

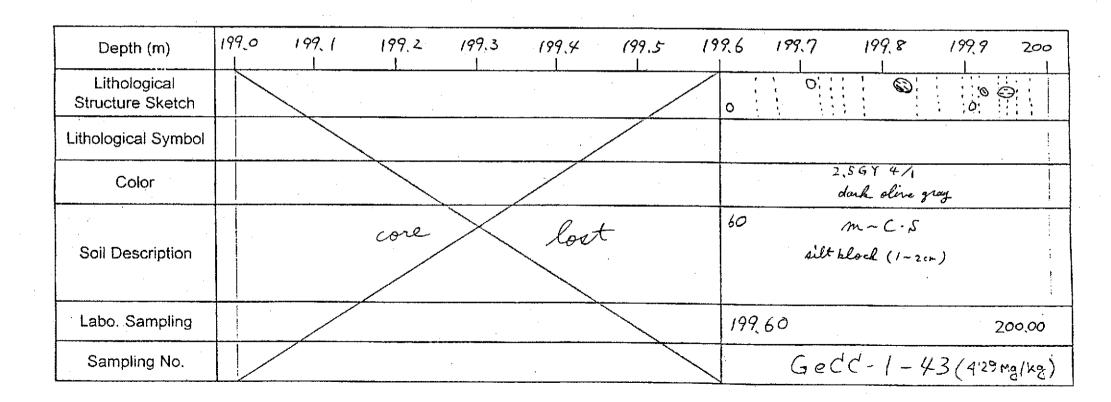

Sheet No. 20/


Thana	Chuadanga
Union	Pourashava
Mouza	Hat Kaluganj
Location	Girl School (Urban-2)

Drilling No.	GeCC-1
Date	29/Jan/2001
Core recorder	Suenaga

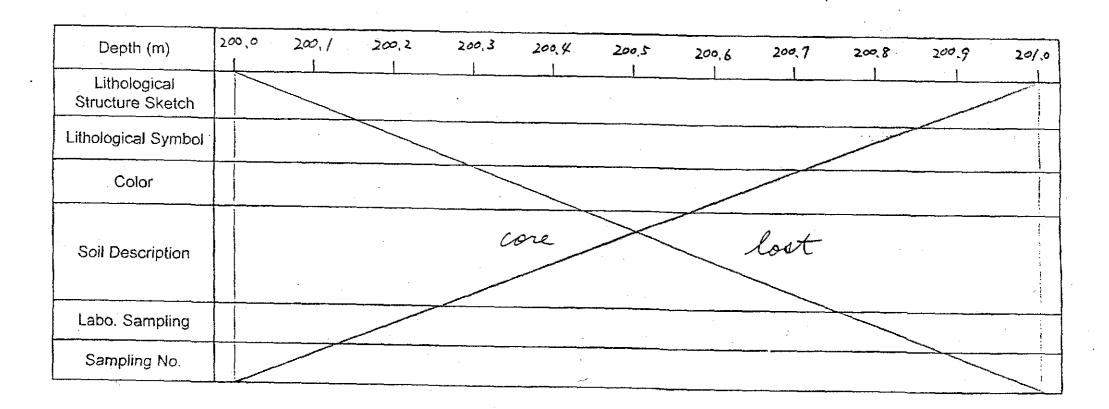


Sheet No. 202

Mouza Hat Kaluganj Date	Union	Pourashava Hat Kalugani	29/Jan/200/
-------------------------	-------	----------------------------	-------------

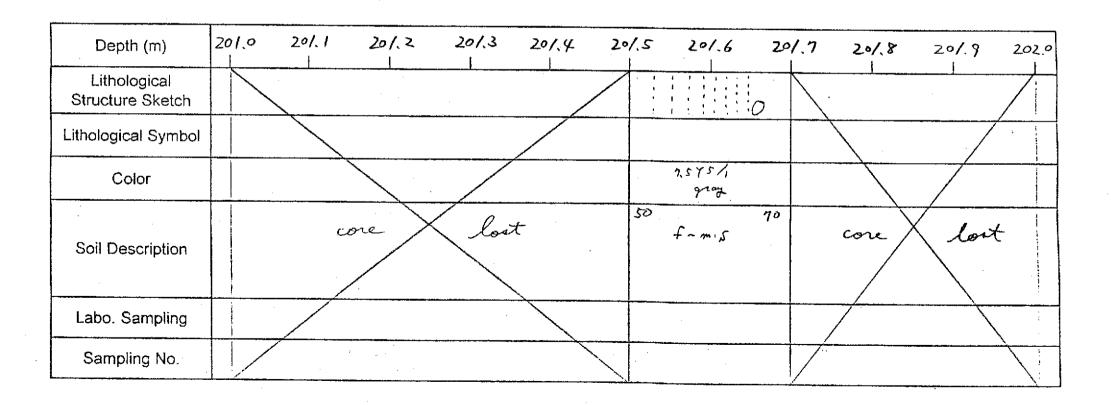

Sheet No. 203

Thana	Chuadanga	Drilling No. GeCC-1	
Union	Pourashava	20/- /2-0	!
Mouza	Hat Kaluganj	Date 29/Jan/200/	
Location	Girl School (Urban-2)	Core recorder Suenaga	

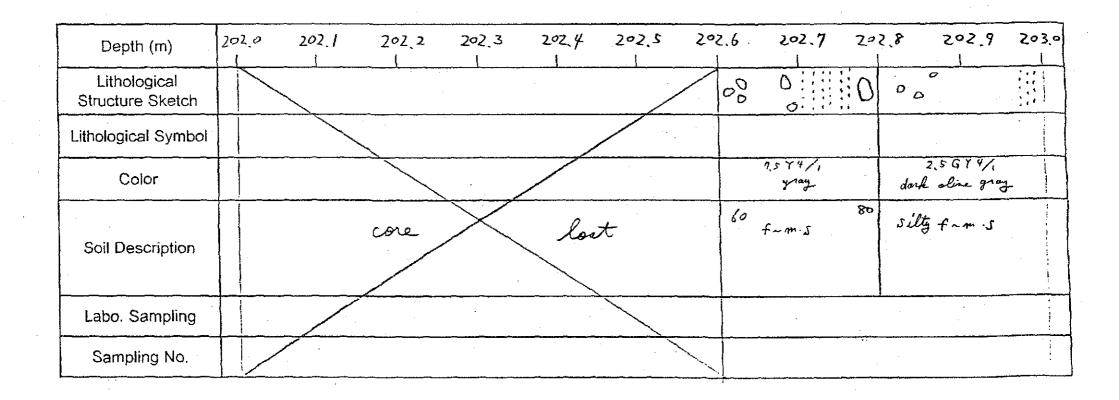


Sheet No.

Tnana	Chuadanga	Drilling No. GeCC-1
Union	Pourashava	20/7/21
Mouza	Hat Kaluganj	Date 29/Jan/200/
Location	Girl School (Urban-2)	Core recorder Suraya

Depth (m)	203.0	203.	/ 203.	2 2033 1	203, K	203.5	203,6	2.03.7	203.8	203, 9 	2040
Lithological Structure Sketch		3	11194 ( O		0	0	* * * * * * * * * * * * * * * * * * *				
Lithological Symbol		*				· · · · · · · · · · · · · · · · · · ·	,				
Color	1 ;	7 5/1 ray	2575/i gray		2.5 T 4						
	f~	m.5	21 m~C·s		f~m.	۲.	65	Co	ne X	lost	-
Soil Description				203.26 org.	inic Laminae			·			
Labo. Sampling	20	3,00					203.65	1			i
Sampling No.				, Co	مرر - ا-	44 (5.0	8mg/kg)				

Sheet No. 205


Thana	Chuadanga	Drilling No. GeCC-1
Union	Pourashava	20/7/21
Mouza	Hat Kaluganj	Date 29/ Jan / 200/
Location	Girl School (Urban-2)	Core recorder Sueraga

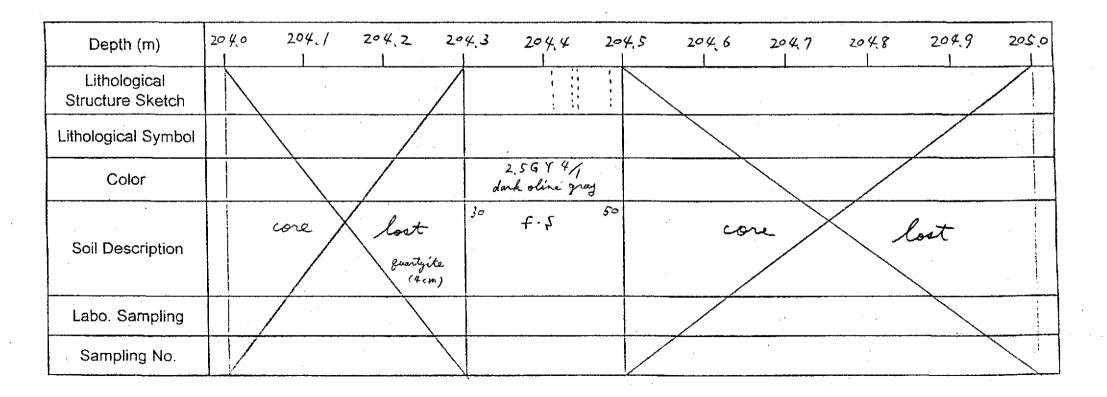

Sheet No.

206

Thana	Chuadanga	Drilling No.	GeCC-1
Union	Pourashava		20/7 /2 /
Mouza	Hat Kaluganj	Date	29/Jan/2001
Location	Girl School (Urban-2)	Core recorder	Suenega

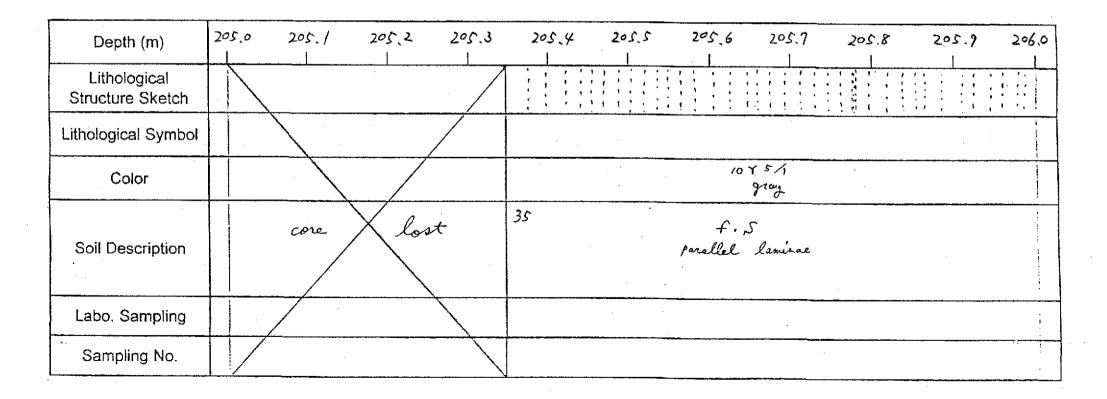

Sheet No. 2

207

Thana	Chuadanga	Drilling No.	GeCC-1
Union	Pourashava	)	9/Jan/2001
Mouza	Hat Kaluganj	Date	1 0001/2-1
Location	Girl School (Urban-2)	Core recorder	Suenaga

Depth (m)	206.0	206./	206.2	206.3	206.4	206,5	206.6	206.7	206,8	206.9	207.0
Lithological Structure Sketch		: ;;0		0	0,	# # # # # # # 1 # # 1 #		Ö	11		> 0
Lithological Symbol											
Color				`	/	gray					
Soil Description		-		mica ru	f~mil. w	.S ixt pebble	(quartyi)	'a man 3.5	(m)		
Labo. Sampling	206.0	0 .	206,20	200	(,30		, ·			,2	07.00
Sampling No.	Ga	CC-1-4	15		Gedd -	1-45	(10.58	mg/kg)	,	-	:

Sheet No. 208

Thana	Chuadanga		Drilling No.	GeCC-1
Union	Pourashava			20/1-12-1
Mouza	Hat Kaluganj		Date	29/Jan/2001
Location	Girl School (Urban-2)	+	Core recorder	Suenaga

Depth (m)	207.0	207.1	207.2	207,3	207.4	207.	.5 20% (	5 2 <i>01.7</i>	207.	8 207.9 I	208.0
Lithological Structure Sketch					1 1 2 1 1 2 1 1 1 1 1 1 1 1 1	!					1
Lithological Symbol					,			11/1/1	0	MII	MI
Color				10 7 5/1	10TS/1		10 GY 4, dank greeni	l gray	10 x 5/1	donk ground ground	dork granish grang
Soil Description		core	lost	25 35 f~m.s	<b>₹∙</b> \$	51	Silty hard	clay 12	£-m 5	88 94 Silty M.S Clay	Silty Clay
Labo. Sampling	,	/					207.50	207.72			!
Sampling No.							1	-1-46			

Sheet No. 209

THE STUDY ON THE GROUNDWATER DEVELOPMENT OF DEEP AQUIFERS
FOR SAFE DRINKING WATER SUPPLY TO ARSENIC AFFECTED AREAS IN WESTERN BANGLADESH

Thana	Chuadanga	Drilling No. GeCC-1	
Union	Pourashava	20/T/200/	
Mouza	Hat Kaluganj	Date 29/Jan/200/	
Location	Girl School (Urban-2)	Core recorder Suenaga	

Depth (m)	208.0 208./	208. Z	208.3 201	8.4 208.5	208,6	208.7	208.8	2°8.9	209.0
Lithological Structure Sketch	0				1 1 1 1 1 1 1 1 1 1 1 1 1 1 1 1 1 1 1		0		)
Lithological Symbol		1							
Color	70 Y			1075 gra			dark olin	= brost	
Soil Description		- m - 5	30 g) 208.42~	m. 5 44 Silt (5mm. c	,	14	Jaye 208.93~209.00	y Silt pebble puntzita, ma	x 3 con)
Labo. Sampling							208.74	. 2	09.00
Sampling No.							Ge	dd - 1-14	7

(22.39 mg/kg)

Sheet No. 2/0

Thana	Chuadanga	Drilling No.	GeCC-1
Union	Pourashava		20/7 1/2-1
Mouza .	Hat Kaluganj	Date	29/Jan/200/
Location	Girl School (Urban-2)	Core recorder	Suenaga

Depth (m)	209.0	209./	209. 2	209.3	209.4 20	9.5 Z	09.6 209.7 209.8 209.9	210.0
Lithological Structure Sketch						1 1 1 1 1 1 1 1 1	WO DOON OODO,	
Lithological Symbol								:
Color		2 / 2 / 101	Josep Josep		10 Y 4/1	10 75%	575/,	<u> </u>
Soil Description		m - 5.	20 25 Cleyey Filt	m ,5	41 50 clayey silt	59 m .s	Filty f-m.5 Nilt. clay block.	
Labo. Sampling				:	,			;
Sampling No.								• 1

Thana	Chuadanga	Drilling No.	GeCC-1
Union	Pourashava		~ 0 /T
Mouza	Hat Kaluganj	Date	29/00
Location	Girl School (Urban-2)	Core recorder	Suena

Depth (m)	210 . D	210./	210. 2	210.3	210.4	210.5	2/0.6	210.7	210.8	2/0.9	211.0
Lithological Structure Sketch			0		000	o	0	, o		0	
Lithological Symbol				Time :							; ; ;
Color				7.5 75/1 ~				7.5 Y 5/	í ————	·	
Soil Description	cer	lost	15 m	alternation from 5 and il pebble (f	of I clayey Ne Evantzita ne	50 lt ×3cm)		f~ m·s			
Labo. Sampling								2/0.65			<b>→</b> :
Sampling No.									Ge CC	-/-48(5	56 mg/ng

Sheet No. 2/2

THE STUDY ON THE GROUNDWATER DEVELOPMENT OF DEEP AQUIFERS
FOR SAFE DRINKING WATER SUPPLY TO ARSENIC AFFECTED AREAS IN WESTERN BANGLADESH

Thana	Chuadanga	Drilling No. GeCC-1
Union	Pourashava	>0 / T / > /
Mouza	Hat Kaluganj	Date 29/Jan/200/
Location	Girl School (Urban-2)	Core recorder Suemaga

Depth (m)	21	1.0	2//_/	211.	۲ 2/	/.3	211.4	2/	1,5	2//	1.6	211.7	211.8	2//	9	2/2.0
Lithological Structure Sketch		00	* * * * *		0:1	0::::				<b>Ø</b>			11000		o	
Lithological Symbol								V								
Color				7 4/1 7 mg		3. (4.) (5.)	10 Y 4	/	₹56¥ 3/i	1074/ gray	2.59 dark olin	Y3/1 . gray	10 \ 4/1 gray	2,567 3/1	10 Y 4/	
Soil Description	3	A CANADA	with p	~m.s rabble (8	uertyite.	35 37 (c~)	f~m. Silt b	•	54 Clayey Silt	60 f~m.s clayblad	Claying 211.68~6	74 Silt 9 (light gra	f~m.s		f~m·S	
Labo. Sampling		$\leftarrow$			2]],30						211,60	211,74	4			:
Sampling No.			GeCC	-1-48	× ×						Gedd	-1-49				.

(24 43 May 20)

Sheet No. 2/3

Thana	Chuadanga	Drilling No. GeCC-1	
Union	Pourashava	29/ Jan/ 200/	
Mouza	Hat Kaluganj	Date 27/ Can 25/	
Location	Girl School (Urban-2)	Core recorder Suenaga	

Depth (m)	212.0	212.1	2/۲, ۲	212,3	212,4 21.	2,5 212,6	2/2/	212.8	3 212,	9 2/3.0
Lithological Structure Sketch		0 000		(U) 6						
Lithological Symbol		/			<u>                                    </u>				<i>[</i> ]	:
Color			7.545)	í		10 Y 4/1 gray	ए क्षेत्र १८	1044/ 2568 gray 3/1	drad 3/	drant 1
Soil Description	core	<i>t</i> /0	m~ C clayey Silt k	. p 4	) 212.45-46	f.s	E Clemen Silit	78 81 f · 5 clayer 5ibt	& clayer silet	212 95-00
Labo. Sampling				-						
Sampling No.										

Sheet No. 2/4

Thana	Chuadanga	Drilling No. GeCC-1
Union	Pourashava	20/5 /2/
Mouza	Hat Kaluganj	29/Jon/200/
Location	Girl School (Urban-2)	Core recorder Suena gra

Depth (m)	213.0	2/3.1	2/3,2	2/3.3	2/3.4	2/3,5	2/3.6	2/3.	7	2/3.8	213.9	21%,0
Lithological Structure Sketch	1:		, N , 1 1 3 ,	4 4 4					,	f 3	000	
Lithological Symbol												
Color		gray 10 %	+1			10 Y 4/1			<del> </del>		10 4 9/1 gray	<u> </u>
Soil Description	2.	f. 13.03-04 charce	2	2.8 )		f-m.s		70	213,8	33 - 88 /	m. s	23.5cm
Labo. Sampling					,			·!			· · · · · · · · · · · · · · · · · · ·	
Sampling No.			, .					<del></del>		<u></u> .		· · · · · · · · · · · · · · · · · · ·

Sheet No.

Location	Girl School (Urban-2)	Core recorder	Suenago
Mouza	Hat Kaluganj	Date	21/00/1
Union	Pourashava		29/Jan/200/
Thana	ু Chuadanga	Drilling No.	GeCC-1

Depth (m)	214.0	214.1	214,2	2/4,3	214. 9		2145	2/ <del>/</del> (	6	214.7	2/4.8	214.9	2/5.0
Lithological Structure Sketch	0;		ိုဝ						) / ) 6 ) 4 ) 7		1	(1.0	
Lithological Symbol													
Color		10 Y 4/1		gray -			gray				0 Y 4/1 pray		
		f~ m.s	18	m . s	41	f	٦٠	60	+	c m.s			
Soil Description	214	16-17 mica den	uly 214.	33~34 mica dens	ely				2/4.	90 silt blo	ek (3mm)		1
Labo. Sampling							:						
Sampling No.													

Sheet No. 216

Thana	Chuadanga	Drilling No. GeCC-1
Union	Pourashava	-0 /7 / 20-1
Mouza	Hat Kaluganj	Date 29 / Jan / 2001
Location	Girl School (Urban-2)	Core recorder Suenaga

Depth (m)	215.0 215.1 215.2 215.3 215.4 215.5 215.6 215.7 215.8 215.9 216.0
Lithological Structure Sketch	
Lithological Symbol	
Color	7.5 Y 5/1 gray
Soil Description	f-m.5
Labo. Sampling	2/5.30 2/6.00
Sampling No.	GeCC-1-50 (3:09 mg/kg)

Sheet No. 217

Thana	Chuadanga		Drilling No.	GeCC-1
Union	Pourashava			0/7/201
Mouza	Hat Kaluganj	•	Date	29/Jan/200/
Location	Girl School (Urban-2)	_	Core recorder	Suenaga

Depth (m)	216.0	216.1	214-2	216 - 3	2/6.4	216.5	216-6	214-7	216.8	216.9	217.0
Lithological Structure Sketch			# # # #}	1 1 1 1 1 1 1 1 1 1 1 1 1 1 1 1 1 1 1				1111			
Lithological Symbol											
Color				7.9	sys/1~ 10 y	4/1 ray					
Soil Description					<i>f</i> ~	m - L					
			· · · · · · · · · · · · · · · · · · ·	·				2/6.96~97	silty Vf.	5 (dark olive,	yay)
Labo. Sampling								·			
Sampling No.			<u> </u>								1

Sheet No. 2/8

Location	Girl School (Urban-2)	Core recorder Suenaga
Mouza	Hat Kaluganj	Date 29 / Jan / 200/
Union	Pourashava	79 /T. / 2001
Thana	Chuadanga	Drilling No. GeCC-1

Depth (m)	217.0 217.1 217.2 217.3 217.4 217.5 218.4 217.7	219.8 219.9 212.
Lithological Structure Sketch	1001	0
Lithological Symbol		
Color	10 Y 4/1 gray	7.5 T 4/1 gray
Soil Description	f~m.5	m~C.5
Soil Description	217.45 silt block (1cm. hand) 217.50-60 clay block (1~2cm. soft)	
Labo. Sampling		
Sampling No.		

Sheet No. 279

Thana	Chuadanga
Union	Pourashava
Mouza	Hat Kaluganj
Location	Girl School (Urban-2)

Drilling No.	GeCC-1
Date	29/Jan/2001
Core recorder	Suenaga

Depth (m)	218-	0 218	1	2/8-2	218-3	213.4	218.5	218.5	2/2·7	2/g·8	2   8 - 9	2/9.0
Lithological Structure Sketch		500	0		0					·		
Lithological Symbol												:
Color				7.5 Y5/1.					10 Y 4 /	í		
Soil Description		218,00~2	.o si	m-C.		47 L)			M ب <sub>ه</sub> ا	<u> </u>		
Labo. Sampling						·	· · · · · · · · · · · · · · · · · · ·					
Sampling No.							· · · · · · · · · · · · · · · · · · ·	*•				

Sheet No. 2.23

Thana	Chuadanga	Drilling No. GeCC-1	
Union	Pourashava		
Mouza	Hat Kaluganj	Date 29/Jan/200/	
Location	Girl School (Urban-2)	Core recorder Suenaga	

Depth (m)	2/9.0 2/9.1 2/9.2	219.3 21	9.4 219.5 219.6 2	19.7 219.8 2.9.9	223
Lithological Structure Sketch					
Lithological Symbol					1.1.1
Color	10 x 4 /1	5GY 2/1 oline black	7.5 ° 7 4 11 gray	7.5 T 4/1 gray	25GY dark din yen
Soil Description	19.04~06 wilt  (dark dine gray - light gray)	silt 40	M. J. nich	m~ (.s	Saroly Silt
Labo. Sampling			219,40	219.90	
Sampling No.			GeCC - 1-5	/(9.78 mg/kg)	:

Sheet No. 221

Thana	Chuadanga	Drilling No. GeCC-1
Union	Pourashava	
Mouza	Hat Kaluganj	Date 31/Jan/200/
Location	Girl School (Urban-2)	Core recorder Suenagea

Depth (m)	220.0 220-1 220.2 220.3 220.4 220.5 220.6 220.7 220.8 220.9 221.
Lithological Structure Sketch	
Lithological Symbol	
Color	25 Y 4/1 gray
Soil Description	220.02~04 Sandy sile block (2×3cm. gray) mica nich 220.18~20 Silty Vf.5 (grayist cline)
Labo. Sampling	
Sampling No.	

Sheet No. 222

Thana	Chuadanga		Drilling No.	GeCC-1
Union	Pourashava	• ,		31/Jan/2001
Mouza	Hat Kaluganj	÷	Date	31/ Jan/ 2001
Location	Girl School (Urban-2)	•	Core recorder	Svenoga

Depth (m)	221.	٥	221	•		221·2		22	1.3		221.4	,	2	11 - 5	•	2 9	21.6		2	21.5	7	22	_1. ; [	5	2	.21.°	)	22	-6
Lithological Structure Sketch		1 1 1 1 1 1 1 1 1 1 1 1 1 1 1 1 1 1 1	•		l,			,	111	+ 1 + 1 + 1		1:		1 1 • 1 • 1	f 1 f f f (	3 · 1	; ;	1 1	;	; ! ; ; ; ;	1 1		1 1	, , , , , ,	1 1 1		1 +		
Lithological Symbol												1	' '		,								,						
Color		-										/0 ነ ያ	ray	í	-														
Soil Description		22/.	/1~ 18~	12 ]	nui-Ca	. den	oely				paral	C _ lel . . 45-	lani	~aL					gra	7)									
Labo. Sampling														22	1.5	0					٠.						22.	2,00	
Sampling No.					, <del>, , , , , , , , , , , , , , , , , , </del>												Ge	ے کے	۔ بے	/-	5	2	(1	'66 I	180	kg)	)	!	

Sheet No. 223

Thana	Chuadanga	Drilling No. GeCC-1
Union	Pourashava	31/Jan/200/
Mouza	Hat Kaluganj	Date 7/ Cipic/ 2007
Location	Girl School (Urban-2)	Core recorder Suenaga

Depth (m)	222.0	222-1	222.2	222-3	222.4	222.5	222.4	222.7		222.9	223.0
Lithological Structure Sketch			0		, , <b>P</b>		1	1 r	1 1 1	1	
Lithological Symbol											
Color					/0	gray 4/1	-			-	
Soil Description	722	.06~09 } 15~16 }	silt block (oline black	2)	f ~ m	٠ ,ؼ					
Labo. Sampling									· ·		
Sampling No.			· · · · · · · · · · · · · · · · · · ·								:

Sheet No. 224

Thana	Chuadanga	Drilling No. GeCC-1
Union	Pourashava	31/Jan/2001
Mouza	Hat Kaluganj	Date 31/ (am/ 200/
Location	Girl School (Urban-2)	Core recorder Suenaga

Depth (m)	2230 2231 223.2 223.3	223.4 22	3.5 223.6	223.7 223.	8 223.9	224.0
Lithological Structure Sketch		1 1			11 11 11 11 11 11	
Lithological Symbol						
Color	10 T 4/1 910y			2,50 dark gru	die black	3207 Star
Soil Description	f - m·s mica nich	50	COYL	S.B	85 92 ty Silt	m·s
Labo. Sampling					, ,	
Sampling No.						:

Sheet No. 225

Location	Girl School (Urban-2)	Core recorder Suenaga	
Mouza .	Hat Kaluganj	Date 51/ 00h/ 200/	
Union	Pourashava	31/Jan/2001	
Thana	Chuadanga	Drilling No. GeCC-1	

Depth (m)	224.0	227.1	224.2	224.3	224.4	224.5	224.6	224.8	2	24.8 22	4.9 22	50
Lithological Structure Sketch		1	•				1		1111	0	; ; ; ; ; ; ; ; ; ; ; ; ; ; ; ; ; ; ;	
Lithological Symbol			, ' — , ' — Color				7.5 T 4/1 gray	:	,			·	7.5 Y 8/1	5675/1 Oline gray	
Soil Description				M. S Mica rich					80	90 m~(·s	Saroly Vilt	
Labo. Sampling	224,0	20				· · · · · · · · · · · · · · · · · · ·	224,7	70	<u> </u>	1		-
Sampling No.		Gec	10-1-	53 (6.5	id ma/kg	)						İ

Sheet No. 226

Thana	Chuadanga	Drilling No. GeCC-1
Union	Pourashava	
Mouza	Hat Kaluganj	Date 31/Jan/2001
Location	Girl School (Urban-2)	Core recorder Sugnaya


Depth (m)	225.0 225.1 225	52 225.3 225.4	225.5 225.6 225.7	225.2 225.9 226.
Lithological Structure Sketch		(D)		
Lithological Symbol				
Color	7.5 Y 5/, gray		7.5 Y 5/, gray	
Soil Description	m. 5 mica niel 225, 22-23 cilt block (	ion olive black	f. 5 mica nich	
Labo. Sampling		1/- \		
Sampling No.				;

Thana	Chuadanga	Drilling No. GeCC-1	
Union	Pourashava		
Mouza	Hat Kaluganj	Date 3/ Jan / 200/	
Location	Girl School (Urban-2)	Core recorder Suenaga	<u></u>

Depth (m)	226.0	226.1	226-2	226.3	224.4	2.26.5	22	6.6 22	6-7	226.8	226.9	227.0
Lithological Structure Sketch			1 1 7 .	\$ 1 \$ 1 \$ 1 \$ 1 \$ 6 1 \$ 6 6 6		* 1 1 1 1 1 1 1 1 1 1 1 1 1 1 1 1 1 1 1	1 1 3 1 1 1 1 1 1 1 1 1 1 1 1 1 1 1 1 1	0				
Lithological Symbol								· · · · · · · · · · · · · · · · · · ·				<u> </u>
Color				15/j				10 YS	/z . gray			
Soil Description			f- mica.	m ,5 rick			60	silty -	f-m.5 80	Gre	Last	
Labo. Sampling								;		1/	<u> </u>	<del>-                                    </del>
Sampling No.									<del></del>			X .

Sheet No. 228

Thana	Chuadanga	Drilling No. GeCC-1
Union	Pourashava	
Mouza	Hat Kaluganj	Date 3/ Jan / 200/
Location	Girl School (Urban-2)	Core recorder Suenaga

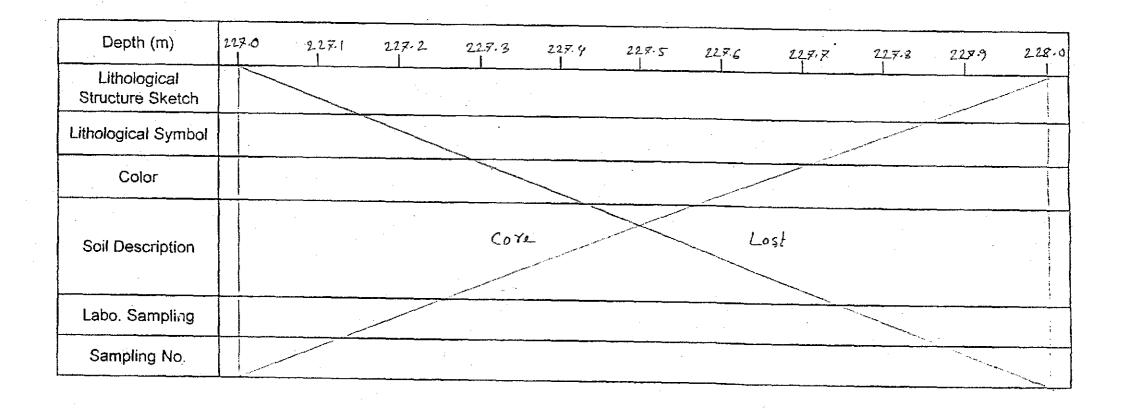

Sheet No. 229

Thana	Chuadanga	Drilling No.	GeCC-1	
Union	Pourashava	**************************************		
Mouza	Hat Kaluganj	Date	31/Jan/200/	•
Location	Girl School (Urban-2)	Core recorder	Suenaga	

Depth (m)	228.0 228.1 228.2 228.3 228.4 228.5 228.6 228.7 228.8 228.9 229.0
Lithological Structure Sketch	
Lithological Symbol	
Color	10 Y 5/2 olin gray
Soil Description	mica rich hard (228.40-70)  228.11-13 with block (2cm. greenish gray)  Core Lost
Labo. Sampling	228.00
Sampling No.	GeCC-1-54 (51.50 mg/kg)

Sheet No. 230

Thana	Chuadanga	Drilling No.	GeCC-1	
Union	Pourashava			
Mouza	Hat Kaluganj	Date	31/Jan/2001	
Location	Girl School (Urban-2)	Core recorder	Svenaya	<u></u>

Depth (m)	229.0 229.1	223-2	229.3	229.4	229.5	229.6	229.7	227.8	2,29.9	230.0
Lithological Structure Sketch		1	1 1	<del></del>	<u> </u>	·	:		, , ,	
Lithological Symbol			· · · · · · · · · · · · · · · · · · ·		<del></del>			1 ( 4	· · ·	
Color					10 Y 5/2 oline gray	1				<u> </u>
Soil Description	Lore Loss	15		mi	f~m.,	<i>ي</i>				
Labo. Sampling	/	7			· · · · · · · · · · · · · · · · · · ·			· · · · · · · · · · · · · · · · · · ·	<u> </u>	
Sampling No.										

Sheet No. 231

Thana	Chuadanga	Drilling No. GeCC-1	
Union	Pourashava		·
Mouza	Hat Kaluganj	Date 31 / Jan / 200/	
Location	Girl School (Urban-2)	Core recorder Suenaga	

Depth (m)	230.0	•	230.1	230.2	230.3	230.4	230.5	230.6	230.7	230.8	230.9	231.0
Lithological Structure Sketch	,	1 3 1 7 1 7							, 1 1 1 1 1 1 1 1 1 1 1 1 1 1 1 1 1 1 1	; ;		
Lithological Symbol					[F]			ľ.		·		
Color			·-			2.567 ol	ine gray					
Soil Description		230.	34~35 d	lty vf.s		mica rick	230.62	- 63 Vr.s	(oline black)			
Labo, Sampling			٠.									; ;
Sampling No.			·				<del></del>					

Sheet No. 232

Thana	Chuadanga	Drilling No. GeCC-1
Union	Pourashava	
Mouza	Hat Kaluganj	Date 31/Jan/200/
Location	Girl School (Urban-2)	Core recorder Suenaga

Depth (m)	231.0	231.1	231-2	231.3	231.4	231-5	251-6	231.7	231.8	231-9	2.32-
Lithological Structure Sketch				1 · · · · · · · · · · · · · · · · · · ·						, , , , , , , , , , , , , , , , , , , ,	
Lithological Symbol	1								<u>, , , , , , , , , , , , , , , , , , , </u>		
Color						2.564 5/ oline 9	ray				-
Soil Description	Core	Lost	IS			f.S mica nick					
Labo. Sampling				231	.30				<u> </u>	232	.00
Sampling No.						GeC	C-1-5	5 (20.36	mg/kg)		1

Sheet No. 233

Thana	Chuadanga	Drilling No. GeCC-1
Union	Pourashava	
Mouza	Hat Kaluganj	Date 31/Jan/200/
Location	Girl School (Urban-2)	Core recorder Suenaga

Depth (m)	232.0 232.1 2	£2.2 232.3 231	· 4 232·5 232·6 232·7 232·8 232·9 233·6
Lithological Structure Sketch			
Lithological Symbol			
Color	2.5675/1 Oline gray	2,5GY5/1 2,5GY5/ -5GY4/1 oline gre	
Soil Description	mico nich	alternation of sica nick	alternation of f.S and Silt  (0.3~1cm) (0.2~0.5cm)
Labo. Sampling			
Sampling No.			

Sheet No. 234

Location	Girl School (Urban-2)	Core recorder	Sunaga
Mouza	Hat Kaluganj	Date	31/Jan/2001
Union	Pourashava		31 / 7 / -
Thena	Chuadanga	Drilling No.	GeCC-1

Depth (m)	233.0 283.1 233.2 233.3 233.4 233.5 233.6 282.7 233.8 233.9 334.0				
Lithological Structure Sketch					
Lithological Symbol					
Color	2.5G T 5/1 ~ 5GT 4/1 oline gray dark oline gray				
Soil Description	alternation of f. 5 and Silt (0.3~0.5cm) (0.3~0.5cm)				
Labo. Sampling	233.00				
Sampling No.	Gedd-1-56 (10.27 mg/kg)				

Sheet No. 235

Thana	Chuadanga	Drilling No.	GeCC-1
Union	Pourashava	-	21/7 / 2 - 21
Mouza	Hat Kaluganj	Date	31/Jan/2001
Location	Girl School (Urban-2)	Core recorder	Suenaga

	Depth (m)	234.0 234.1	234.2 234.	3 234.4 13	4.5 234.6 234.7	237-8 234.9 235-0
	Lithological Structure Sketch					
L	ithological Symbol					
	Color	25615/1 - 5614/		2.5675/1 ~ 5674/1 line gray dark olive gray		2.56Y S/1 ~ 56 Y 4/1
	Soil Description	alternation of f. 5 and Silt (0.2-0.5cm) (0.2-0.5cm)	4.5	alternation 50 of of S and Wilt 1-4 cm) (0.2-0.7 cm)	core Lost	alternation of  f. 5 and Silt  (0.1-0.200) (0.3-100)
	Labo. Sampling					
	Sampling No.			Ż		

Sheet No. 236

Thana	Chuadanga	Drilling No.	GeCC-1
Union	Pourashava	· · · · · · · · · · · · · · · · · · ·	21 / T
Mouza	Hat Kaluganj	Date	31 / Jan
Location	Girl School (Urban-2)	Core recorder	Suena

Depth (m)	235.6	235.1	235.2	235.3	235.4	235-5	235.6	235-7	235.8	235.9	236-0
Lithological Structure Sketch											
Lithological Symbol	,										
Color					2.5GT. olina gr	5/1 ~ 56 ay da	it 4/1 ch oline	gray	•		ļ
Soil Description				alter	nation o	f f.S (0,2~0,5cm)					
Labo. Sampling				235	,30			235.7	8		•
Sampling No.						GeCC-	1-57 (-	21.90 mg/kg	F)		

Sheet No. 237

Thana	Chuadanga	Drilling No. GeCC-1
Union	Pourashava	. /
Mouza	Hat Kaluganj	Date 31/Jan/200/
Location	Girl School (Urban-2)	Core recorder Suenaga

Depth (m)	2360 236.1 236.2 236.3 236.4 236.5 236.7 236.7 236.8 236.9 238.0
Lithological Structure Sketch	
Lithological Symbol	
Color	25GT 5/1 ~ 5GT 4/1 Oline gray dark oline gray
Soil Description	Core Lost 40 alternation of f. S and Silt (0.2-0.5cm) (0.2-1cm)
Labo. Sampling	
Sampling No.	

Sheet No. 238

Thana	Chuadanga	Drilling No. GeCC-1
Union	Pourashava	21/7 /21
Mouza	Hat Kaluganj	31/Jan/2001
Location	Girl School (Urban-2)	Core recorder Suenaga

Depth (m)	237.0 237.1 237.2 237.3 237.4 23;	7.5 237.6 237.7 237.8 237.9 2850
Lithological Structure Sketch		
Lithological Symbol		
Color	2.5675/ ~ 5674/ oline gray dark oline gray	2.5 G Y 5/1 Oline gray
Soil Description	alternation of f.S and Silt 50 (0.2-0.5cm) (0.3-0.8cm)	f.S mica nich
Labo. Sampling		
Sampling No.		

Sheet No. 239

Location	Girl School (Urban-2)	Core recorder	Suenaga	
Mouza	Hat Kaluganj	 Date	31/Jan/2001	
Union	Pourashava		, , ,	
Thana	Chuadanga	Drilling No.	GeCC-1	

Depth (m)	238,0	238.1	238.2	238.3	238-4	238-5	238.6	238.	₹.	238.8	2.	36.9	239.0
Lithological Structure Sketch								1 1 3	1 5	11111	1 1 1	# 7 7 3 1 1	
Lithological Symbol													v .
Color					2.5 GY 5/1 oline gray			, ·	~	·			
Soil Description				M	ica rich								
Labo. Sampling	23	8.00					238.	10					
Sampling No.					Gedd-	1-58	(8:67 mg/x	<b>a</b> )			·		!

Sheet No. 240

Thana	Chuadanga	Drilling No. GeCC-1	
Union	Pourashava		
Mouza	Hat Kaluganj	Date 31/Jan/2001	
Location	Girl School (Urban-2)	Core recorder Suenaga	

					· · · · · · · · · · · · · · · · · · ·	<del></del>	
Depth (m)	289.0 239.1 23	9.2 239.3	239.4 239.5	239.6 239.7	2/39,8	3 <i>5</i> 9. <b>9</b>	240-
Lithological Structure Sketch							
Lithological Symbol							
Color	10 Y 4/1 gray						
	f-m.5 20						
Soil Description	239.18~20 sity vf·s		Core		Last		
Labo. Sampling							;
Sampling No.							

Sheet No. 24/

Thana	Chuadanga	Drilling No.	GeCC-1	
Union	Pourashava		, /- 1	
Mouza	Hat Kaluganj	Date 3	1/Jan/2001	
Location	Girl School (Urban-2)	Core recorder	Sueroga	

Depth (m)	240.0 240.1 240.2 240.3 240.4 240.5 240.6 240.7 240.8 240.9 241.
Lithological Structure Sketch	
Lithological Symbol	
Color	5GY 9/1 Sank oline gray
Soil Description	Core Lost 50 f. S mica nich
Labo. Sampling	
Sampling No.	

Sheet No. 242

Thana	Chuadanga	Drilling No. GeCC-1
Union	Pourashava	21/4/
Mouza	Hat Kaluganj	Date 31/Jan/2001
Location	Girl School (Urban-2)	Core recorder Suenaga

Depth (m)	241.0	241.1	241.2	241.3	241.4	241.5	241.6	241.7	241.8	241.9	242.0
Lithological Structure Sketch								1 1 4 4			
Lithological Symbol						<u>.</u>				-	
Color					\$64 4/1 La oline gra	y.			;	10.7 5/1 gray	?56 <b>7</b> 8/
Soil Description				mica	f.S nick				85	96 1m.5	silty vrs
Labo. Sampling	241,0	)0				· · · · · · · · · · · · · · · · · · ·	241,70				
Sampling No.		Gec	d-1-5	9 (7'88	mg/kg)						

Sheet No. 243

Thana	Chuadanga	Drilling No. GeCC-1
Union	Pourashava	31/Jan/2001
Mouza	Hat Kaluganj	Date
Location	Girl School (Urban-2)	Core recorder Suenaga

Depth (m)	242.0	247.1	242.2	242-3	242	. 4 2	42.5	242.6	242.7	2428	242.9	242.0
Lithological Structure Sketch				1		· · · · · · · · · · · · · · · · · · ·	1 1 1 1 1 1	1 : 1 1 : 1 1 : 1 1 : 1	1 1		1 1	
Lithological Symbol												! :
Color			567 dark ol	4 / gray			9104	7,56 Y 4/1 dark greenied gray	10 Y 5/1	44 4567	40 A 2/1	
Soil Description			f., mica A	s vick		49	54 m-C·S		m-C-S	79 82 Sily	m ~ C • S	and the second s
Labo. Sampling			·	i,						٧.		! :
Sampling No.												}

Sheet No. 249

Trana	Chuadanga	Drilling No. GeCC-1
Union	Pourashava	21/ T / 22/
Mouza	Hat Kaluganj	Date 31/ Jan/ 2001
Location	Girl School (Urban-2)	Core recorder Sugnaga

Depth (m)	2	43.0		243.1	2	432	2	-43.3 24 1	13.4	24	3.5 2	-43.6 i	243.7	243.8	243.9	244.0
Lithological Structure Sketch		1	1	: ::			0	© /////:	1 ', ,	0				11(11)	0	
Lithological Symbol			-											MM		
Color			` .	10 Y S gray	•			1075/1.	7.56 74 dank greeni gray	a.R			1012/1	7.56 43/1 dark greenisk gray	2.5684/1 dark sline grav	4
Soil Description				M ~ C·	<sup>-</sup> که	25	sit (	M.S It block 1-2cm dine groy)	Setty	50	Core	Lost	78 M.S	clayey Silt	Z,• m	
Labo. Sampling						,								٠.	7	
Sampling No.				~							/	`\	. ;			!

Sheet No. 245

Thana	Chuadanga	Drilling No.	GeCC-1
Union	Pourashava		21 / 7 / 2 /
Mouza	Hat Kaluganj	Date	31/Jan/2001
Location	Girl School (Urban-2)	Core recorder	Suenaga

Depth (m)	244.0 2	244.1 244	:2 244.3	244.4 2	44.5 20	14.6	244.7	244.8	44.9 245.0
Lithological Structure Sketch							<b>巡</b> : (1		
Lithological Symbol			f 1 1 1 1					1/201613	
Color	2.5674/1 dark oline	saya dark oli	ne groy dark ground	SGY4/ 1073 dark oline gray oline plan	25GY dark sline g	4/i roy	10 Y 4/1	5673/1 ~ dark oline gray	· Z. S 6 Y %,
	f~m·s 10		<i>∔</i> ∙ ↓			65	f~m 5	alternation Vf-f'S and	of Silt
Soil Description		244, 28~34. 45~46 48~50	} silt	244.56~58 A	rica donsely	2	244,66–90 Siltblock		
Labo. Sampling						······································	÷	244.74	
Sampling No.								Gedd-	1-60(3533mg/z

Sheet No. 246

Thana	Chuadanga	Drilling No.	GeCC-1
Union	Pourashava		21/- / 2001
Mouza	Hat Kaluganj	Date	31/Jan/2001
Location	Girl School (Urban-2)	Core recorder	Suenoya

Depth (m)	2450 2451	245.2	245.3	245.4	245.5	245.6	245.7	245.8	245.9	276.0
Lithological Structure Sketch				, , , , , , , , , , , , , , , , , , ,	·	1   1   e   f   e   f   e   f   e   f   e   f   e   f   e   f   f		<i>(</i>	0	
Lithological Symbol									÷.	
Color	2,5GY4/1 5GY3/1				10 Y 4,	•				
	alternation 17				mis	,				The state of the s
Soil Description	of Vf-f.5 and Silt					24	45.76~78 V	1.f.s block		
Labo. Sampling	← 245,17		245.3	0					_	246,00
Sampling No.	Gell-1-60				Ge CC	-1-6	/ (5.82 m	g/kg)		

Sheet No. 247

Thana	Chuadanga
Union	Pourashava
Mouza	Hat Kaluganj
Location	Girl School (Urban-2)

Drilling No.	GeCC-1	
Date	31/Jan/2001	
Core recorder	Suenaga	

Depth (m)	246.0	2.46.1	246.2 2	76.3 276.4 1	246-5	246.6 2	yc-z 246-8	2.44-9 242.0
Lithological Structure Sketch								
Lithological Symbol								
Color		7.5 74/1 gray	2.5GY oline g	5/1 ~ 5G Y 4/1 cay dark oline	z ray			
Soil Description		ms	f.s (0.3~1.00	ternation of and Silt m) (0.2-1.0cm) 4 organic laminar (Oline blank)	50	Core		Lost
Labo. Sampling			······································				i	
Sampling No.								

Sheet No. 248

Thana	Chuadanga		Drilling No.	GeCC-1
Union	Pourashava	_		
Mouza	Hat Kaluganj	<del>-</del>	Date	31/Jan/2001
Location	Girl School (Urban-2)	<del>-</del>	Core recorder	Suenaga

Depth (m)	2470 247.1 249.2 247.3	247.4 247.5	- 247.6 247.7 2	47.8 247.9	248.0
Lithological Structure Sketch		000			•
Lithological Symbol					
Color		10741 gray	56 Y 4/1 oline gray	· dran	
Soil Description	Coro	M.S 54 Quantitie (may 2.5 cm)		frm.s sil	ty -s
Labo. Sampling					
Sampling No.				——————————————————————————————————————	1

Sheet No. 249

Thana	Chuadanga	Drilling No. GeCC-1	
Union	Pourashava	$\gamma_1/T/\gamma_2$	
Mouza	Hat Kaluganj	Date 31/ Jan/ 20	,
Location	Girl School (Urban-2)	Core recorder Swenaga	

Depth (m)	24	1k. 0	248.1	248:	2	248	3	246	7.4	24	18-5	2	48·6	248	, <b>z</b> .	2'	18.8	2	.48.9	249.0
Lithological Structure Sketch		1 1	1 5 1	) ; ) ; ) ;			1 1 1		11 11 11 11 1 11 1 1 11 1	1 -		. (		1 1 1	7 1 6	1 1	f :		f f	
Lithological Symbol			٠.			·														
Color				10 Y 4/1		<u> </u>	· · ·							10 Y 8,			····		······································	
Soil Description			mi	f~m:s	-		41	9				,		m.s. ca ruc.		'lty				
Labo. Sampling											'									
Sampling No.		1			· · · · · · · · · · · · · · · · · · ·															

Sheet No. 250

Thana	Chuadanga	Drilling No. GeCC-1
Union	Pourashava	21/T/2=1
Mouza	Hat Kaluganj	Date 31/Jan/200/
Location	Girl School (Urban-2)	Core recorder Suenaga

Depth (m)	2490 27.1 29	19.2 249.3 249.4 249.5 2	249.6 249.8 249.8 250.
Lithological Structure Sketch	0::::::::::::::::::::::::::::::::::::::		
Lithological Symbol			
Color	9107	10 Y 4/1 gray_	
Soil Description	frm.5 mica rick	m.5 60 mica nich	Core Lost
Labo. Sampling		· · · · · · · · · · · · · · · · · · ·	
Sampling No.			

Sheet No. 251

Thana	Chuadanga	Drilling No. GeCC-1	
Union	Pourashava		
Mouza	Hat Kaluganj	Date 02/Feb/200/	
Location	Girl School (Urban-2)	Core recorder Suanaga	

Depth (m)	250.0 250.1 250.2 250.3 250.4 250.5 250.6 250.7 250.2 250.5	- 3
Lithological Structure Sketch		
Lithological Symbol		:
Color	2.5GY 5/1 Oline gray	1
Soil Description	m. 5	
Labo. Sampling	250.00	1
Sampling No.	GeCC-1-62 (6'03 mg/xg)	·

Sheet No. 252

Thana	Chuadanga	Drilling No. GeCC-1	
Union	Pourashava		
Mouza	Hat Kaluganj	Date 02/Feb/2001	
Location	Girl School (Urban-2)	Core recorder Suenega	

Depth (m)	251.0 251.1 251.2 251.4 251.5 251.6 251.7 251.8 251.9 252.5
Lithological Structure Sketch	0 0 0 0
Lithological Symbol	
Color	2.5GY 5/1 olive gray
Soil Description	m. S with silty vf.s block (1cm, light gray)
Labo. Sampling	
Sampling No.	

Sheet No.

53

Thana	Chuadanga		Drilling No.	GeCC-1
Union	Pourashava			
Mouza	Hat Kaluganj		Date	02/Feb/2001
Location	Girl School (Urban-2)	* .	Core recorder	Suenagu

Depth (m)	25	52.0		25:	2-/		, 23	F2.	2	25	{2·3	 25,7	.4	<del></del>	252.	5	2	<u> </u>		2	<u> 5</u> 2.7		2	<u></u> 52	8		<u> </u>	<u>;</u>		23.	) C
Lithological Structure Sketch		1 1	1 (	, ,	1	1		1 1 1	1 1 4	1 1		 , ,		, (	- <u></u> -	1		11	1		1 1	1 1	1		, ,		. 1	1 . (	٢	-	
Lithological Symbol			<del></del>															····											,		7
Color													GY. line		L.																1
Soil Description				-		-						. 1	א . הל																		
Labo. Sampling									3 -	<u> </u>						<u>-</u>			- Ng	<del>- L.,</del>			··	<del> </del>		<del></del>	·	<del></del>	· · ·	:	
Sampling No.		1										 	· · · · · · · · · · · · · · · · · · ·			<u> </u>									<del></del>					1	-

Sheet No. 255

Location	Girl School (Urban-2)	Core recorder	Surrage
Mouza	Hat Kaluganj	Date	02/Feb/200/
Union	Pourashava		
Thana	Chuadanga	Drilling No.	GeCC-1

Depth (m)	25	3.Ò	253-1	253.2	, 	253.3	253.4	253.5	253.6	253-	7	253	. 5	250 (	: 254.
Lithological Structure Sketch			1 1 1 1 1 1 1 1 1 1 1 1 1 1 1 1 1 1 1	 , , ,	1 1 1 1 1 1 1 1 5 1 1 5	1 1	7.4 / 	/ / / / / / / / / / / / / / / / / / /							
Lithological Symbol															
Color			· · · · · · · · · · · · · · · · · · ·			4	stire gray				13GY and dark	106T 4/1 greened	2.56 Y 3/1 dank obin gray	25GY 2/1 black	25949/1 Such olins gray
Soil Description							m.s			73	7	5:04	88	<del> </del>	
Labo. Sampling				 <del></del>		· · · · · · · · · · · · · · · · · · ·			·		1 -	<u> </u>	!	<u> </u>	1
Sampling No.							<del></del>			<u> </u>		<del></del>	<del></del> _	<del>-</del>	:

Sheet No. 255

Location	Girl School (Urban-2)	Core recorder Swanaga
Mouza	Hat Kaluganj	Date 02/ Feb / 200/
Union	Pourashava	22/-0/
Thana	Chuadanga	Drilling No. GeCC-1

Depth (m)	254.0	25%	254.2	257.3	f			254.6				255.0
Lithological Structure Sketch							1					
Lithological Symbol												;
Color		. \		/					Y5/, me gray			
Soil Description		Core		Lost	4-	0		<i>+-</i>	-m .5		je i	
Labo. Sampling					,. 2	154.4	0				-	255,00
Sampling No.								GeC	'C-1-1	53 (3.9	4 mg/Kg	3)

Location	Girl School (Urban-2)	Core recorder Sugnaga
Mouza	Hat Kaluganj	Date 02/Feb /200/
Union	Pourashava	
Thana	Chuadanga	Drilling No. GeCC-1

Depth (m)	255.0 255.1 255.2 255.5 255.4 255.5 255.6 255.7 255.8 255.9 256.0
Lithological Structure Sketch	80
Lithological Symbol	
Color	7.5 7 5/1 1/1 2.5 G 7 4/1 7.5 G 7 4/1 97 ay gray gray
Soil Description	framis to Framis 25 min 5 min 5 min formation (3 min formation) (3 min formation) (3 min formation) (3 min formation)
Labo. Sampling	
Sampling No.	

Sheet No. 257

Thana	Chuadanga	Drilling No. GeCC-1
Union	Pourashava	02/Feb / 2001
Mouza	Hat Kaluganj	Date
Location	Girl School (Urban-2)	Core recorder Suenaga

Depth (m)	256.0 256.1 256.2 256.3 256.4 2	56.5 256.6 256.7 256.8 256.9 257.0
Lithological Structure Sketch		
Lithological Symbol		
Color		SGT 4/1 dork olive group
Soil Description	Core	f-m.5
Labo. Sampling		
Sampling No.		

Sheet No. 258

Thana	Chuadanga	Drilling No.	GeCC-1
Union	Pourashava		- / = 0 /
Mouza	Hat Kaluganj	Date	02/Fel /2001
Location	Girl School (Urban-2)	Core recorder	Suenaga

Depth (m)	257.0 257.1 257.2 257.3 257.4 257.5 257.6 257.7 257.2 257.9 25
Lithological Structure Sketch	
Lithological Symbol	
Color	59 y 4/1 dark olive gray
Soil Description	t-w.2
Labo. Sampling	257.00
Sampling No.	GeCC-1-64 (4:32 mg/kg)

Sheet No. 259

Thana	Chuadanga	Drilling No.	GeCC-1	
Union	Pourashava	,	,	
Mouza	Hat Kaluganj	Date	02/Feb/2001	
Location	Girl School (Urban-2)	Core recorder	Sueraga	<del></del>

Depth (m)	258.0 258.1 258.2 258.3 258.4 258.5 258.6 258.7 258.8 258.9 259.
Lithological Structure Sketch	
Lithological Symbol	
Color	dark oline gray gray gray
Soil Description	from 5 27 m. 5 50 with pelble (quartyite, 0,5-2cm) Core Lost.
Labo. Sampling	
Sampling No.	

Sheet No. 263

Thana	Chuadanga	Drilling No. GeCC-1
Union	Pourashava	
Mouza	Hat Kaluganj	Date 02/Feb./200/
Location	Girl School (Urban-2)	Core recorder Swenaga

Depth (m)	259.0 259.1 259.2 259.5 259.7 259.5 259.6 259.7 259.6
Lithological Structure Sketch	
Lithological Symbol	
Color	
Soil Description	Core
Labo. Sampling	
Sampling No.	

Sheet No. 26/

Thana	Chuadanga	Drilling No. GeCC-1
Union	Pourashava	2/50/201
Mouza	Hat Kaluganj	Date 03/Feb./200/
Location	Girl School (Urban-2)	Core recorder Suenaga

Depth (m)	260.0 260.1 260.2 260.3 260.4 260.5 260.6 260.7 260.8 260.9 261.0
Lithological Structure Sketch	
Lithological Symbol	
Color	
Soil Description	Lost
Labo. Sampling	
Sampling No.	

Sheet No. 262

Thana	Chuadanga		Drilling No.	GeCC-1
Union	Pourashava		^ 1	( - 1 / - 1
Mouza	Hat Kaluganj		Date 0.3	/Feb /200/
Location	Girl School (Urban-2)	ě,	Còre recorder	Suenaya

Depth (m)	261.0 20	(1.1. 26	1.2 261.3	261.4 2	61.5 24.6 261.7 261.9	261.9 262
Lithological Structure Sketch	1 1 1 1 1 1 1 1 1 1 1 1 1 1 1 1 1 1 1	d in 1999 (				
Lithological Symbol					syf# my£s. A	
Color	75644/1 dark greenish gray	2.5GYS/	2.56 Y 3/1 dark gray	2.5673/1 dark greenise gray	1012/1	
Soil Description	VF-F.S onlea Mich	F. 5	Vf - f.5 mica rich	sig vf.s	Vf - f.s cross laning	
Labo. Sampling						
Sampling No.						


Sheet No. 263

Chuadanga	Drilling No. GeCC-1
Pourashava	
Hat Kaluganj	Date 03/Feb./200/
Girl School (Urban-2)	Core recorder Suenaga
	Pourashava Hat Kaluganj

Depth (m)	262.0 262.1 262.2 262.3 .262.4	262.5 262.6	262.7	212.8 26	2.9 263.0
Lithological Structure Sketch				, , , , , ,	
Lithological Symbol					
Color	10 Y	S/1 ay			
Soil Description	VF ~ f. 262.24 ~ 29 organic luminose (with charcos 262.19 ~ 29 mica denesly				
Labo. Sampling	262.00	262.65			
Sampling No.	GeCC-1-	65 (6'43 mg/kg)			

Sheet No. 269

Location	Girl School (Urban-2)	Core recorder 5	Sulnaga
Mouza	Hat Kaluganj	Date 03	/ Feb. /200/
Union	Pourashava		/
Thana	Chuadanga	Drilling No.	GeCC-1

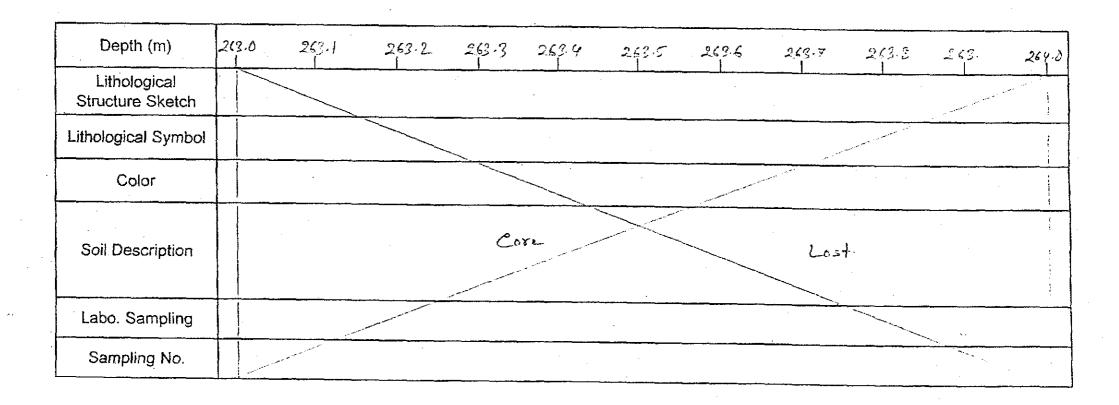

Sheet No. 265

Thana	Chuadanga	Drilling No. GeCC-1
Union	Pourashava	
Mouza	Hat Kaluganj	Date 03/Feb./200/
Location	Girl School (Urban-2)	Core recorder Suenaga

Depth (m)	264.0	264.1	264.2	254.3	264.4	25.4.5	257.5	214.7	264.2	257.9	255
Lithological Structure Sketch									<u> </u>		
Lithological Symbol											
Color											<u> </u>
Soil Description			Core	-				Los	†	···	1
Labo. Sampling											;
Sampling No.											

Sheet No. 246


Location	Girl School (Urban-2)	Core recorder Swenaga
Mouza	Hat Kaluganj	Date 05/Feb./2001
Union	Pourashava	
Thana	Chuadanga	Drilling No. GeCC-1

Depth (m)	265.0 265.1 265.2 265.3 265.4 265.5 265.6 265.7 265.2 265.9	256
Lithological Structure Sketch		
Lithological Symbol		
Color	10 Y 5 /1 gruy	
Soil Description	35 Vf. S cross laminae 265.48 ~ 70.} mica denely 88 ~ 96.} mica denely	
Labo. Sampling		
Sampling No.		:

Sheet No. 267

Thana	Chuadanga	Drilling No
Union	Pourashava	·
Mouza	Hat Kaluganj	Date
Location	Girl School (Urban-2)	Core reco

Drilling No.	GeCC-1	
Date	05/Feb. /2001	
Core recorder	Suenaga	

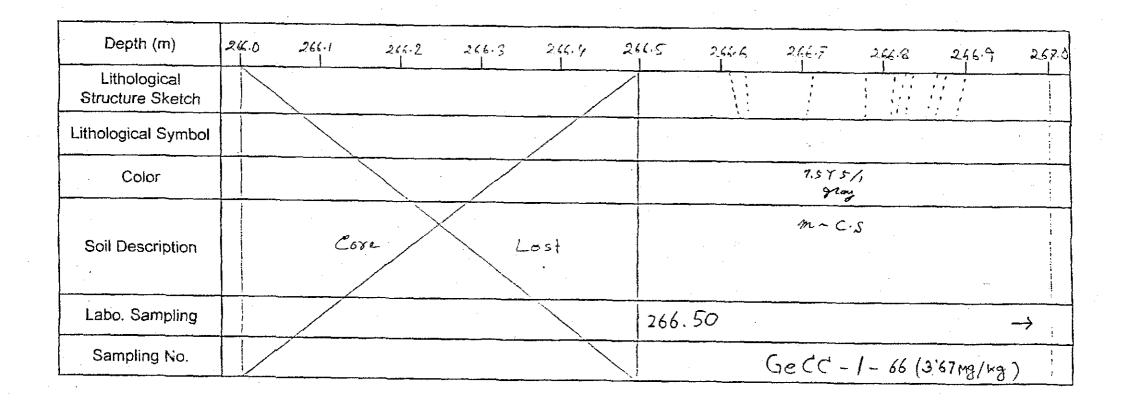

Sheet No.

268

Thana	Chuadanga		Drilling No.	GeCC-1	
Union	Pourashava			~ / = 0 / >	
Mouza	Hat Kaluganj	,	Date O.	5/tel./2001	
Location	Girl School (Urban-2)		Core recorder	Sueraga	

Depth (m)	267.0 267.1 267	-2 267-3	257.9 257.5	267.6 2	GF.7 247-8	F6F.9 258-0
Lithological Structure Sketch	0	6 .,, /		; ;	0	0
Lithological Symbol						
Color	7.5 Y 5/1 gray	• •			10 Y 5 /1 gray	
Soil Description	Soil Description			m. S runase grading		
Labo. Sampling	₹ 267,20					
Sampling No.	GeCC-1-66			-		

Sheet No. 469

Thana	Chuadanga	Drilling No. GeCC-1
Union	Pourashava	
Mouza	Hat Kaluganj	Date 05/Feb./200/
Location	Girl School (Urban-2)	Core recorder Suanaga

Depth (m)	268.0 258.1 268.2 268.3 248.4 268.5 268.6 248.7 248.8 248.9 269.3
Lithological Structure Sketch	0
Lithological Symbol	
Color	10 Y 5/1 gray
Soil Description	F ~ m.5  268.45-62 Silt block (1cm-5mm. dark greenish gray)  268.89-90 quantizite (2cm) 69-90
Labo. Sampling	268.60
Sampling No.	GeCC-1-67 (3.58 mg/xg)

Sheet No.

Thana	Chuadanga	Drilling No. GeCC-1
Union	Pourashava	-/
Mouza	Hat Kaluganj	Date 05/ Feb / 2001
Location	Girl School (Urban-2)	Core recorder Sueraga

Depth (m)	269.0 269.1 269.2 269.3 269.4 269.5	269.6 26 <del>9.</del> 7 269.8 269.9 27
Lithological Structure Sketch		
Lithological Symbol		
Color		7.575/1 gray
Soil Description	Corr	60 f ~ m. 5 with sandy with block (1-2cm, gray) 269.87-90 quartyita (3cm)
Labo. Sampling		
Sampling No.		

Sheet No. 27/

Thana	Chuadanga	Drilling No. GeCC-1
Union	Pourashava	
Mouza	Hat Kaluganj	Date 05/Feb /2001
Location	Girl School (Urban-2)	Core recorder Suena ga

Depth (m)	270.0	270.1	270.2	270.3	270.4	273.5	270.3	270.7	2,70.8	296.9	271.0
Lithological Structure Sketch			٥						1 1 11		• 1
Lithological Symbol						4					: :
Color					7.5 45/1 gray						
Soil Description					m·s		270.81-	-89 silt bl	lock (3cm,	dank greenish gra	<i>1</i> )
Labo. Sampling											
Sampling No.											

Sheet No. 272

Location	Girl School (Urban-2)	Core recorder Suenaga
Mouza	Hat Kaluganj	Date 05 / Feb / 200/
Union	Pourashava	
Thana	Chuadanga	Drilling No. GeCC-1

Depth (m)	27/-0	2×1·1	27/-	2_	27/-3	:	251.4	<u>.</u>	\$タルダ - 1	,	# 977. 	É	. £9	1.7	-	991. Z	<i></i>	. <del>?</del>	-072-0
Lithological Structure Sketch		4" 7 8" 2 1 1 1 1 2 1			· · · · · · · · · · · · · · · · · · ·	۱	• •			•	1		f 	•	•	<b>B</b> 0	)		:
Lithological Symbol																,			:
Color		10 Y 4											y 4/ gray						
Soil Description		+~	m.s		3	5					ni	m ca n	uch	,8v ~	8/ 4	rilt <b>b</b> l	och (2c	n hand	)
Labo. Sampling						2	71.3	5						-				272	,00
Sampling No.							-	Ge	ĆĆ	- 1-	- 6	8	(4'8	L Mg	/ Kg	<del>)</del>			

Sheet No. - 277

Thana	Chuadanga	Drilling No. GeCC-1
Union	Pourashava	
Mouza	Hat Kaluganj	Date 05/Feb./200/
Location	Girl School (Urban-2)	Core recorder Suenaga

	Depth (m)	27	2.0	٠.	272.1	!	2 <u>۶</u>	2.2		. ?	-17-	<b>'</b>	277	2.5	25	2 · 6	소로 1	2. <i>g</i>	Ć.	 72-ε 1		72.9	2,9	3.3
	Lithological Structure Sketch					>	:	' '	1 ; ; ;			; 1			Г ). З <u>ў</u>		` <b>.</b>	, , ,		O		1		
L	ithological Symbol										•			·							٠			
	Color				<del></del>						10 Y	-									·•			i
	Soil Description									m	f~ ica .r.	mick	2,،											
	Labo. Sampling														· · ·									:
	Sampling No.																					\		Ì

Sheet No. △ヌダ

Location	Girl School (Urban-2)	Core recorder Swenaga
Mouza	Hat Kaluganj	Date 05/Feb/200/
Union	Pourashava	
Thana	Chuadanga	Drilling No. GeCC-1

Depth (m)	273.0	273.1	2722	£39.5	253.9	2.F	3.7 C.7	734 493	F 273.0	25,29	27%
Lithological Structure Sketch		1 1 1 1 1 1 1 1 1 1 1 1 1 1 1 1 1 1 1		* ,	٥		1 1		000	, <sub>(D)</sub>	0
Lithological Symbol							7-17-1	·		,	
Color			10 Y 4/, gray				1.56 Y 4/1 Sork greenish	10 × 4/1	Į.	27 4/,	
Soil Description			f~m	کړ.		50	Sandy Silt	f . s 72	fr with Silt (1-2cm.	m 5 block dark greanis,	kgray)
Labo. Sampling						·				h	
Sampling No.											

Sheet No. 195

Thana	Chuadanga	Drilling No.	GeCC-1
Union	Pourashava		//
Mouza	Hat Kaluganj	Date	05/Feb./200/
Location	Girl School (Urban-2)	Core recorder	Surnaga

Depth (m)	279.0	294.1 2	z4.2	274-3	274,4	27.45	27%6	27/17	274.8	<i>j</i> : 7: 7: 1	49 2898
Lithological Structure Sketch	; ; ; ; ; ; ; ; ; ; ; ; ; ; ; ; ; ; ;				:	,		, ,			
Lithological Symbol											1417
Color	10x 9/1				10 Y 4/1 gray						7.56 74/dark gray
Soil Description	05 f~m·S					f · J			÷	90	Sardy Silt
Labo. Sampling			274	4,20				274	80		
Sampling No.				GeCC-1	- 69	(5.21 W	17 /rg)				

Sheet No. 💪 🎖 🗸

Thana	Chuadanga	Drilling No. GeCC-1	
Union	Pourashava		
Mouza	Hat Kaluganj	Date 05/Feb/200/	
Location	Girl School (Urban-2)	Core recorder Suenaga	

Depth (m)	2750 2751 2752 2759 2759 2755 2756	2707 2700	2950 2860
Lithological Structure Sketch			
Lithological Symbol			· ·
Color		107 4/1	2007
Soil Description	Core	72 87 f-m·s	4.5
Labo. Sampling			:
Sampling No.			

Sheet No. 277

Thana	Chuadanga	Drilling No. GeCC-1
Union	Pourashava	15/50 12001
Mouza	Hat Kaluganj	Date 05/Feb /200/
Location	Girl School (Urban-2)	Core recorder Suenoga

Depth (m)	2,5	76-6 1	)		27. 	(-1	2	タス・2 	<u>}</u>		276	3	274.9	<b>1</b>	94.5	276	5-6	2	75.7		⊉ેલ.	:	234.7		77:0 
Lithological Structure Sketch			* * * * * * * * * * * * * * * * * * *				:				, , ,	Ø			1				: 0						:
Lithological Symbol																									:
Color				• •	•••	<del></del>	 . •	10	74.	•						<del></del>		Y5/1 ray		<del></del>				15/1 ray	1
Soil Description					*\			+	~ 7	m . ,	S			50			C٠	٦,			83		m-	<i>د -</i> ۵	
Labo. Sampling																									
Sampling No.		-						· ·			•														

Sheet No. 278

Thana	Chuadanga	Drilling No. GeCC-1
Uniori	Pourashava	
Mouza	Hat Kaluganj	Date 05/Feb./200/
Location	Girl School (Urban-2)	Core recorder Swnaga

Ereoth (m)	277.0 277.1 277.2 277.3 277.4 277.5 277.6 277.7 277.8 277.	.७ २,४३४
Lithological Structure Sketch	0, 0	
Lithological Symbol		
Color	7.5 Y 5/1	10 74/1 .
Soil Description	M - C·S  with pebble (quantigite. max 2cm)	f-m-5
Labo. Sampling		
Sampling No.		

Sheet No. 279

Thana	Chuadanga	Drilling No.
Union	Pourashava	
Mouza	Hat Kaluganj	Date
Location	Girl School (Urban-2)	Core recorder

Drilling No.	GeCC-1	
Date	05/Feb/2001	
Core recorder	Sueraga	-

Depth (m)	278.0	278·1	278.2	258.3	273.4	278·	\$	278.6	278·		11	2 =7.3
Lithological Structure Sketch				•			; ; ; ; ; ; ; ; ; ; ; ; ; ; ; ; ; ; ;	0			00	
Lithological Symbol												
Calor		<u> </u>			10 Y 4							
Soil Description					£~ 1	n.s						
	200	7 00	<u> </u>	·			278.	60	. <u>.</u>			
Labo Sampling	211	3.00					<del></del>		••	· · · · · · · · · · · · · · · · · · ·		
Sampling No				Gec	10-1-1	70(5:43	ing/kg	)	····			

Sheet No. 221

Thana	Chuadanga	Drilling No.	GeCC-1
Union	Pourashava		150 1500
Mouza	Hat Kaluganj	Date	05/Feb./2001
Location	Girl School (Urban-2)	Core recorder	Suenaga

Depth (m)	277.0 277.1	279.2	279.3 279.	9 237.5 3	779.6 279.7	277.8 277.7 280.0
Lithological Structure Sketch	0					
Lithological Symbol						
Color	10 Y 4/1 gray		.10 Y 4/1 gray			
Soil Description	f~m.5 15		f·S		Core	Losi
Labo. Sampling						
Sampling No.						


Sheet No. 281

Thana	Chuadanga	Drilling No. GeCC-1
Union	Pourashava	
Mouza	Hat Kaluganj	Date 05/ Feb. /200/
Location	Girl School (Urban-2)	Core recorder Suenaga

Depth (m)	280.0	280.1	280.2	20.3	280.4	265	250.9	280.7	280.€	280.9	281.0
Lithological Structure Sketch						# T	. 0				
Lithological Symbol											
Color					10 Y 5,	•			<del> </del>		
					f. 2	·					
Soil Description		280,54	charcoal	wood frag	ment (1×3cm)	280 280	1.64~65 S. 14~19 /	ilt block mico dersl	( (2cm) 4		-
Labo. Sampling								,			
Sampling No.										,	


Sheet No 282

Thana	Chuadanga	Drilling No.	GeCC-1
Union	Pourashava		150 /201
Mouza	Hat Kaluganj	Date	15/Feb. /200/
Location	Girl School (Urban-2)	Core recorder	Suenaga

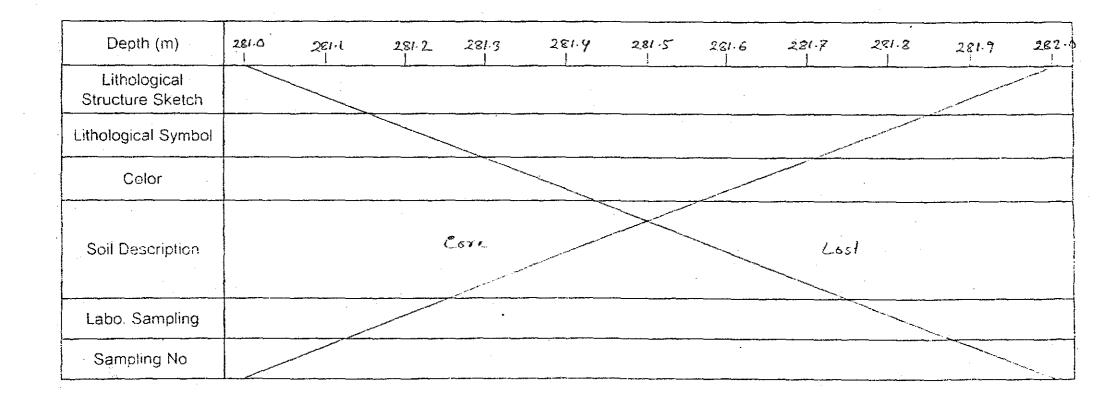

Sheet No. 283

Thana	Chuadanga	Drilling No.	GeCC-1
Union	Pourashava		05/50/
Mouza	Hat Kaluganj	Date	05/Feb./200/
Location	Girl School (Urban-2)	Core recorder	Sueraga

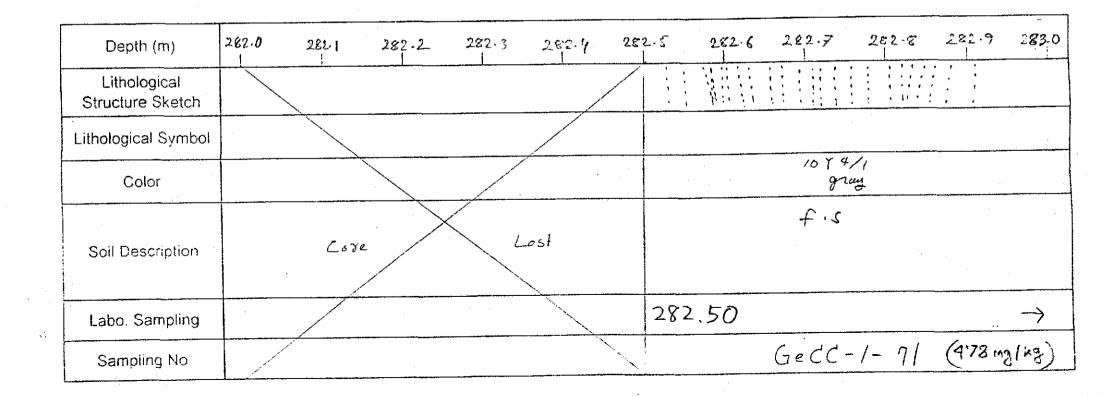

Sheet No. 284

Thana	Chuadanga	Drilling No.	GeCC-1
Union	Pourashava	Marrows - White marrows -	- 150 1- 1
Mouza	Hat Kaluganj	Date	05/Feb /2001
Location	Girl School (Urban-2)	Core recorder	Sulnaga

Depth (m)	283.0 283.1 283.2 283.3 283.4 283.5 283.6 283.7 283.8 283.9 284.0
Lithological Structure Sketch	
Lithological Symbol	
Color	10 Y 4 /1
	$f \cdot S$
Soil Description	283,30-95 trace fossil 283,55-60 Silt block (hard, 5cm, plate)
Labo. Sampling	← 283.15
Sampling No.	GeCC-1-71

Sheet No. 285

Thana	Chuadanga		Drilling No.	GeCC-1
Union	Pourashava	•		, _
Mouza	Hat Kaluganj		Date	05/ Feb.,
Location	Girl School (Urban-2)		Core recorder	Surray

Depth (m)	284.0	284.1	284.2	284.3	284.4	269.5	284.6	284.9	284.3	259.9 285
Lithological Structure Sketch										
Lithological Symbol										
Color										
Soil Description				Core				Los	-1	
Labo. Sampling										····
Sampling No.										The second secon

Sheet No. 286

Location	Girl School (Urban-2)	Core recorder Swanga
Mouza	Hat Kaluganj	Date 05/Feb. /2001
Union	Pourashava	~ / 5 0 / 2001
Thana	Chuadanga	Drilling No. GeCC-1

Depth (m)	285.0	285-1	285.2	285 3. 	28 S·7	235.5	285.6	285.7	235.3	285.9	286.0
Lithological Structure Sketch									) ! \ ! \ ! ! \ !	1	·
Li:hological Symbol							,				
Color	·								7.5 Y 5 gray		
Soil Description			Core			-ost		45	2.4		
Labo. Sampling											
Sampling No.											

Sheet No. 287

Thana	Chuadanga		Drilling No.	GeCC-1	
Union	Pourashava			1-2	
Mouza	Hat Kaluganj	•	Date	05/Feb. /2001	
Location	Girl School (Urban-2)		Core recorder	Suenaga	

Depth (m)	206.0	286-1	286-2	286 3	286.4	286.5	284-6	286.7	286.8	286.9	287.3
Lithological Structure Sketch	1 1 1 1 1 1 1 1 1 1 1 1 1 1 1 1 1 1 1			1 1	+ + 1 × + + + + + + + + + + + + + + + +		1111	1 1 1	1 1 1	e d d C	
Lithological Symbol											,
Color				·	10 Y 4.						
Soil Description	28 <i>6</i>	5.07~08 .36~38	clay block (20 Mica densely	·m. z <sup>nay</sup> ) y	f · 2						
Labo. Sampling		2	86.10				· · · · · · · · · · · · · · · · · · ·	286.	80		·
Sampling No.			18771		Ge	dd-1-	72 (3.72	mg/kg)			

Sheet No. 288


Thana	Chuadanga	Drilling No.	GeCC-1
Union	Pourashava		
Mouza	Hat Kaluganj	Date	05/Feb /2001
Location	Girl School (Urban-2)	Core recorder	Suenaga

Depth (m)	287.6	287-1	287.2	287.3	287.4	207.5	287.4	287.7	237.8	287.9	285.0
Lithological Structure Sketch			, , , , , , , , , , , , , , , , , , ,	· · · · · · · · · · · · · · · · · · ·				٥	000	00000	00
Lithological Symbol											-
Color				10 4 4 1 gray					1.5 Y 5/1 gray		
Soil Description			,	4.2			60	f	-m.5 th pebble (	quartyita mad	3cm)
Labo. Sampling									<u>-</u> -		<del></del>
Sampling No.		·			· · · · · · · · · · · · · · · · · · ·						·

Sheet No. 289

Thana	Chuadanga
Union	Pourashava
Mouza	Hat Kaluganj
Location	Girl School (Urban-2)

Drilling No.	GeCC-1	
Date	05/ Feb. / 2001	
Core recorder	Sulnaya	

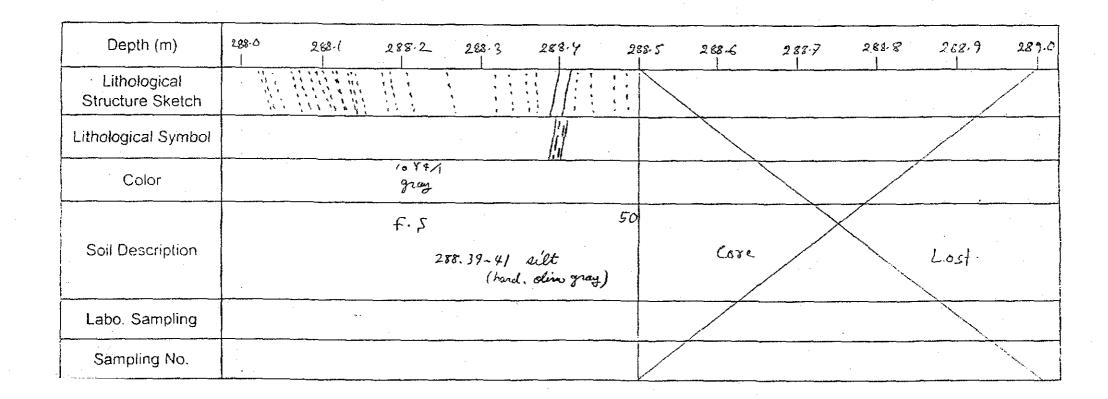

Sheet No.


290

Thana	Chuadanga	Drilling No.	GeCC-1
Union	Pourashava		
Mouza	Hat Kaluganj	Date	05/ Feb /2001
Location	Girl School (Urban-2)	Core recorder	Suenega

Depth (m)	289.0 289.1 289.2	289.3	269.4 28	9-5° 2.6°	3.6 2897 2	29.2 29.9 <b>29</b> 8.1
Lithological Structure Sketch					::::o ° /	0000000
Lithological Symbol						
Color			10,(4/1	·	7.5 Y 5/1	1.5 Y 5/1 gray
Soil Description	Core Lost	2.5	f~m·s	60	m ~ C·S 80  289.68~70  8 nontgito (3cm)	with pellile quartzita max 3 rm su 1 cm
Labo, Sampling						
Sampling No.						

Sheet No. 291

Thana	Chuadanga	Drilling No.	GeCC-1
Union	Pourashava		. / - 0 / 1
Mouza	Hat Kaluganj	Date O	5/Feb./. 2001
Location	Girl School (Urban-2)	Core recorder	Suenaga

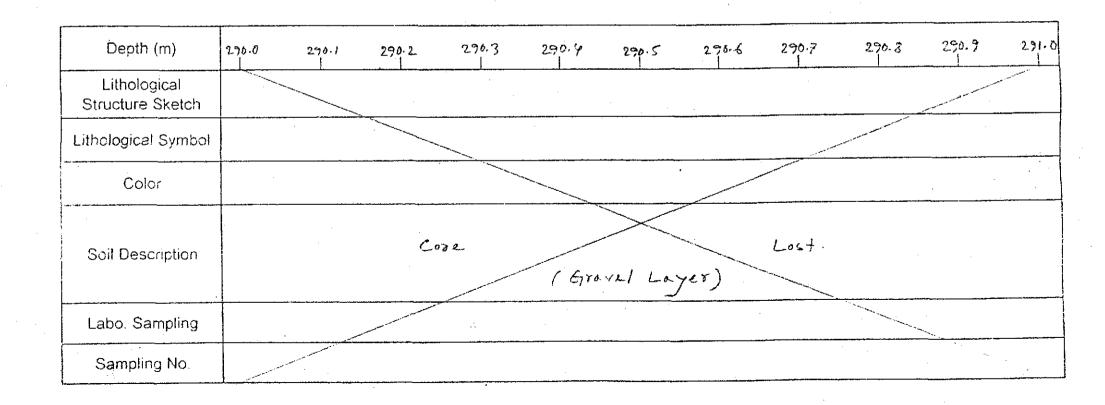

Sheet No.

292

Thana	Chuadanga	¥	Drilling No.	GeCC-1
Union	Pourashava			
Mouza	Hat Kaluganj		Date	05/ Feb. / 2001
Location	Girl School (Urban-2)		Core recorder	Suenagu

Depth (m)	291.0 291.1 291.2	-91.3 291.4 29	71:5 291.6 291.7	291.8 291.9 272.0
Lithological Structure Sketch		00		
Lithological Symbol				
Color				
Soil Description	Core Lost	30 alternation of C.S and Sandy Silt wiel pebble ("suntgite" 1-1.5cm)	Core	Lost-
Labo. Sampling				
Sampling No.		i.		·


Sheet No. 299

Thana	Chuadanga	Drilling No. GeCC-1	
Union -	Pourashava .	- ~ / - 1	131
Mouza	Hat Kaluganj	Date OS/Fel	. / 2001
Location	Girl School (Urban-2)	Core recorder Sugnag	<u> </u>

Depth (m)	292 0	292 1	292 2	292.3	292.4	292.5	292 6	292.7	292.8	292.9	293.0
Lithological Structure Sketch									The state of the s	11:5	2
Lithological Symbol											
Color											
Soil Description		quarty max s		YE (	Grovel	Layer)	Lost			90 Sil 292.90 Silt (hand.	1-98 block
Labo. Sampling											
Sampling No.											

Sheet No. 294

Thana	Chuadanga	Drilling No. GeCC-1
Union	Pourashava	- / - A / A
Mouza	Hat Kaluganj	Date 05/ Feb. / 200/
Location	Girl School (Urban-2)	Core recorder Suenaga

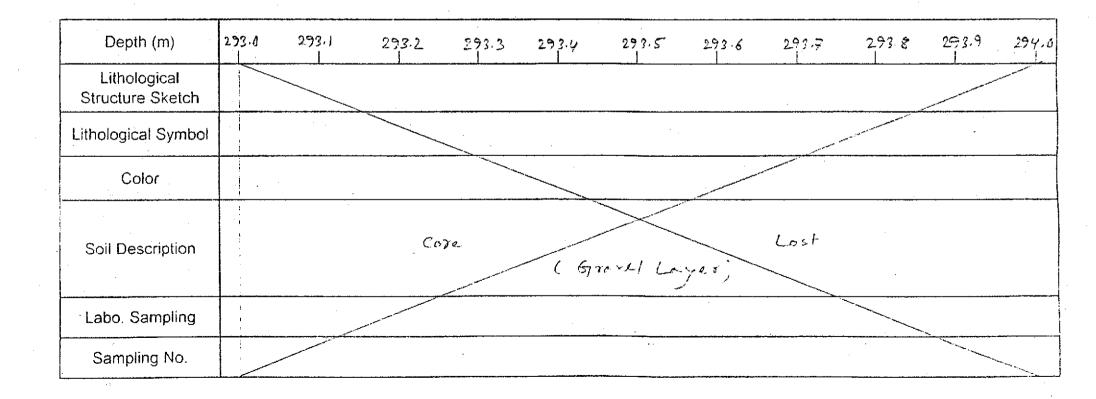


Sheet No. 295

Thana	Chuadanga	Drilling No.	GeCC-1
Union	Pourashava		05/50/5
Mouza	Hat Kaluganj	Date	05/Feb. /2001
Löcation	Girl School (Urban-2)	Core recorder	Sueraga

Depth (m)	294.0	290-1	294.2	274.3	294.4	294.5	294.6	29.4-7	294.8	294.9	2950
Lithological Structure Sketch			,							- Andrews - Market -	
Lithological Symbol										· .	
Color											}
Soil Description			C	071				Lost			
Labo. Sampling		-									
Sampling No.											


Sheet No. 296

Location	Girl School (Urban-2)	Core recorder Sulnaga
Mouza	Hat Kaluganj	Date 05/ Feb. /2001
Unjon	Pourashava	~ / E / /2 and
Thana	Chuadanga	Drilling No. GeCC-1

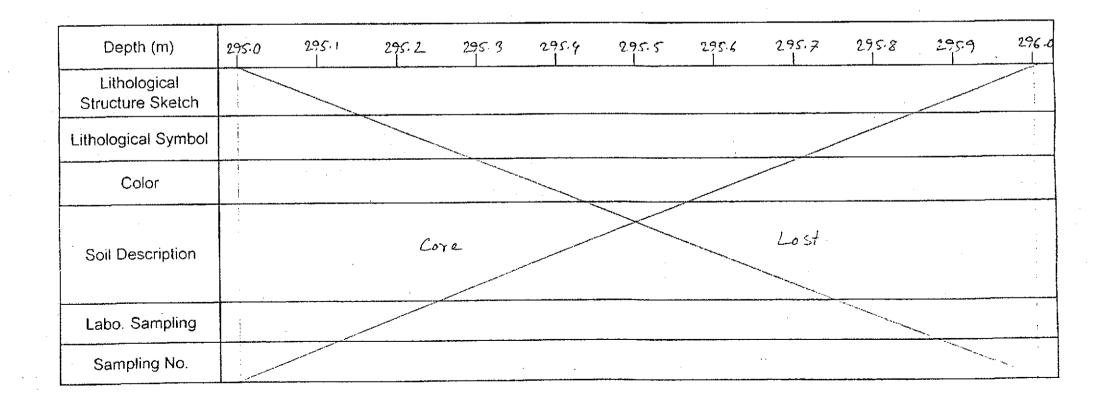

Sheet No. 297

Thana	Chuadanga	Drilling No. GeCC-1
Union	Pourashava	22/50/201
Mouza	Hat Kaluganj	Date 05/ Feb /200/
Location	Girl School (Urban-2)	Core recorder Suenaga

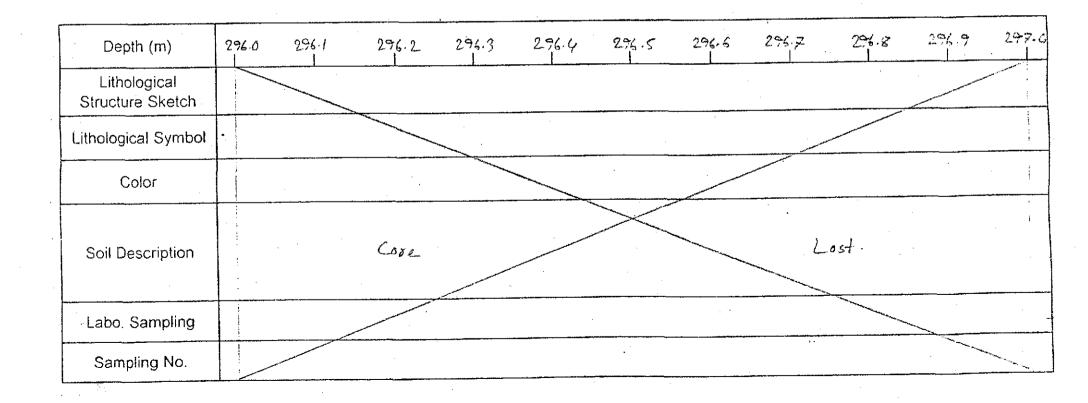

Sheet No. 278

Location	Girl School (Urban-2)	Core recorder	Sulmaga	
Mouza	Hat Kaluganj	Date	05/Feb./2001	
Union	Pourashava	•	/ - / - / - /	
Thana	Chuadanga	Drilling No.	GeCC-1	<u></u>

Depth (m)	2970	2 <del>9</del> 7.7	297.2	299.3	297.7	297.5	2954	297.7	297.8	257.9	238,0
Lithological Structure Sketch											
Lithological Symbol											: :
Color					7.5 Y 5/1 gray						
Soil Description				. !	f.S mica nick						
Labo. Sampling					·		**				
Sampling No.							•				

Sheet No. 2 3 9

Thana Chuadanga		Drilling No.	GeCC-1		
Union	Pourashava		150 15001		
Mouza	Hat Kaluganj	Date	05/Feb /2001		
Location	Girl School (Urban-2)	Core recorder	Surraga		

Depth (m)	2980 298.1	298.2	298.3	298.4	578·5	278.6	278.7	298.8	<u> </u>	299.0
Lithological Structure Sketch							11 11 11 11 11 11 11 11 11 11 11 11 11	1 1 2 E 4 I		
Lithological Symbol						· .				
Color							2.56Y oline of			
Soil Description	Lor		L	s <del>s 1</del> -	50		<b>∱</b> .5			
Labo. Sampling					129	8. <i>50</i>				$\rightarrow$
Sampling No.						G	eCC-1	- 73 (	5 78 mg/kg	)

Sheet No. 300

Thana	Chuadanga		Drilling No.	GeCC-1
Union	Pourashava	<del>-</del>		
Mouza	Hat Kaluganj	<del>-</del> .	Date	05/ Feb /2001
Location	Girl School (Urban-2)	······································	Core recorder	Suenaga

Depth (m)	299.4	299./	299.2	2.99.5	299.4	299.5	199.5	299.7	200.0	2.57.9	3 <b>%</b> -
Lithelogical Structure Sketch				,		t ;					
Lithological Symbol	·		·	X.							
- Color				2.5GY 5/1 Oline gray							
Soil Description					÷						
Labo. Sampling	<u> </u>		299.25		<u> </u>			<del></del>			
Sampling No.	G	eCC-1	1-73							· · · · · · · · · · · · · · · · · · ·	<del></del>