

Site Information & Scope of Work

Site Information

Site Name : Demra
Site Code : 30-DMR-401C & 30-DMR-100/100M

Site Address : To be provided later.

Coordinates : N 23° 42' 40.1 " : E 90° 30' 25.2 "
* Coordinates are surveyed by handy type GPS and might be inaccurate.

Site Type

| | |
|--|--|
| <input checked="" type="checkbox"/> Control Center | <input checked="" type="checkbox"/> Master Telemetry Station |
| <input type="checkbox"/> Gas Field | <input type="checkbox"/> Operating Company Terminal (OCT) |
| <input checked="" type="checkbox"/> CGS (City Gas Station) | <input type="checkbox"/> Power station/Fertilizer Factory |
| <input type="checkbox"/> Compressor Station | <input type="checkbox"/> TBS (Town Bordering Station) |
| <input type="checkbox"/> Pig Station | <input type="checkbox"/> DRS (District Regulating Station) |
| <input type="checkbox"/> MS (Metering Station) | <input type="checkbox"/> GMS (Gas Manifold Station) |
| <input type="checkbox"/> VS (Valve Station) | |

Site Status

- Originally covered by The Existing System and shall be covered by The New System.
- Currently not covered by The Existing System but shall be covered by The New System.
- Upcoming site which will be covered by The New System after the completion of the Project.

Operating Company : GTCL

Remarks : _____

Scope of Work

Works checked off hereinafter shall be carried out for the Project

1. SCADA System

■ : Control Center

- Design, supply and install following equipment as a minimum configuration of SCADA control room.
 - 2 SCADA servers (redundant)
 - 4 HMI work stations
 - 1 color printer
 - 1 monochrome printer
 - 1 Large screen monitor (flat panel)

■ : RTU

- RTU without display monitor
Design, supply and install a self-standing IP65 enclosure equipped with following items:
 - RTU
 - Instrumentation and communication equipment
 - Backup battery system with charger for 24 hours
 - Lighting
 - Anti-condensation heater
 - Earthing and lightning protection
 - All internal wiring
 - Other equipment to satisfy the functional requirements

- RTU with display monitor
Design, supply and install a self-standing IP65 enclosure equipped with following items:
 - RTU
 - Display monitor
 - Instrumentation and communication equipment
 - Backup battery system with charger for 24 hours
 - Lighting
 - Anti-condensation heater
 - Earthing and lightning protection
 - All internal wiring
 - Other equipment to satisfy the functional requirements

- RTU (design & supply only)
Design and supply self-standing IP65 enclosure equipped with following items:
 - RTU
 - Instrumentation and communication equipment
 - Backup battery system with charger for 24 hours
 - Lighting
 - Anti-condensation heater
 - Earthing and lightning protection
 - All internal wiring
 - Other equipment to satisfy the functional requirements

- Interface with flow computer
Make provision for:
 - Installation of the flow computer which shall be prepared by GTCL in the enclosure
 - Interface between RTU and the said flow computer
- Interface with receiver for turbine meter
Install the existing receiver for turbine meter(s) in the RTU enclosure and interface it (them) via communication (MODBUS) cable.
- Interface with other system
Provide the interface between RTU and other system such as PLC or PC operated by the operating company including all communication cables between RTU and other system.
- Cable between RTU and Master Telemetry Station
Design, supply and install the cable between RTU and Master Telemetry Station in case RTU and Master Telemetry Station are located in the same site.

■ : Instruments

- Existing instruments
Re-use the existing instruments and cables.

Note:

Existing instruments and cables shall be serviced by the Employer.

- New Instruments
Design, supply and install the following instruments.
Output signals from instruments are to be cabled via field junction box to the RTU.

■ : Pressure transmitters Q'ty

- Design, supply and intall:
 - Pressure transmitter on the existing spare tapping point
 - Tubing between tapping point and transmitter
- Prepare the tapping point for the pressure transmitter, and design, supply and install:
 - Pressure transmitter on the prepared tapping point
 - Tubing between tapping point and transmitter

■ : Differential pressure transmitters Q'ty

- Design, supply and install:
 - Differential pressure transmitter on the existing spare tapping point
 - Tubing between tapping point and transmitter

- Prepare the tapping point for the differential pressure transmitter, and design, supply and install:
 - Differential pressure transmitter on the tapping point
 - Tubing between tapping point and transmitter

■ : Temprature transmitters Q'ty

- Design, supply and install:
 - Thermowell in the spare boss on the pipe
 - Resistance temperature detector complete with a head mounted transmitter into the thermowell

■ : Limit switch Q'ty

- Design, supply and install the limit switch on the existing shutdown valve for valve position monitoring.

- Pick up Signal from the Existing Turbine Meter Q'ty
Supply and install a dual pulse output pickup head in place of the single pulse output pickup in the existing turbine flowmeter sensor head. The output signal from the existing turbine flowmeter to be cabled via junction box to RTU.

- Local Field Instrument Junction Box Q'ty
Design, supply and install an Intrinsic safety junction box. The junction box to be suitable for glanding appropriate cables.

- Instrument Cables
Design, supply, install the instrument cables from the field instruments to RTU via junction box including each cable termination with gland.

2. Communication System

- : Master Telemetry Station (Former Microwave Radio Station)
 - Removal of existing communication system
Remove and dispose following existing items used for microwave transmission system:
 - Microwave equipment/facilities in the radio equipment room
 - Antenna mounted on the existing tower
 - Cables between radio equipment room and existing tower

 - Radio equipment to connect Master Telemetry Station with Provider's Access Point
Design, supply and install IP radio equipment at existing radio equipment room to connect Master Telemetry Station with nearest Provider's Access Point (BTCL's AP), including all necessary cables, accessories and the antenna to be mounted on the existing tower.

 - Master telemetry equipment
Design, supply and install master telemetry equipment at existing radio equipment room to connect with slave telemetry equipment, including all necessary cables, accessories and the antenna to be mounted on the existing tower.

 - Radio equipment to connect Master Telemetry Station with OCT
Design, supply and install IP radio equipment at radio equipment room to connect Master Telemetry Station with Operating Company Terminal (OCT) at another site, including all necessary cables, accessories and the antenna to be mounted on the existing tower.

 - Radio equipment to connect Provider's Access Point with Master Telemetry Station
Design, supply and install IP radio equipment at nearest BTCL's access point to connect BTCL's AP with Master Telemetry Station, including all necessary cables, accessories and the antenna with monopole.

 - Network equipment
Design, supply and install all necessary Network equipment at radio equipment room of Master telemetry station as well as at nearest BTCL's access point.

 - Network cable to OCT
Design, supply and install network cable between Master Telemetry Station and OCT which shall be installed within the same site.

- : IP PBX System
 - IP PBX main unit
Design, supply and install IP PBX main unit with necessary accessories and spare parts.

 - Extension telephone set Q'ty
Design, supply and install extension telephone set(s) with required cables. [20]

3. Electrical Works

- : Power Supply to RTU
 - Electrical power shall be supplied to RTU from existing PDB, and existing power cable shall be re-used.

 - Design, supply and install MCB box for the power supply to RTU including all cables from existing PDB to MCB box and from MCB box to RTU.

 - Design, supply and install power controller and power cable to RTU at remote site where electrical power is supplied from existing solar panel.

 - Design, supply and install new solar panel, power controller and power cable to RTU.

- : Backup Batteries for Radio Equipment at Master Station
 - Remove and dispose existing backup batteries for radio equipment.
Supply & install new backup batteries with charger suitable to backup new radio equipment for 48 hours.

- : Replacement of Air conditioner at Radio room of Master Station
 - Remove and dispose existing window type air conditioner at radio room, and Supply & install new air conditioner suitably selected to maintain the specified temperature and humidity of radio room.

- : Supply of Portable Engine Generator Q'ty
 - Supply of the petrol and/or diesel driven 1 kVA portable engine generator [1]
for the maintenance of remote site(s) without commercial power supply.

4. Civil Works


- : Foundation & Sunshade for RTU
 - Re-use existing foundation & sunshade for RTU
Examine the condition of existing foundation and sunshade for RTU and repair the defects, if any.
 - Provide new foundation & sunshade for RTU
Design and construct the foundation and sunshade for new RTU at suitable location. The foundation and sunshade should be designed to suitably accommodate new RTU.

- : Instrument Stand with Foundation & Sunshade
 - Re-use existing Instrument stand(s) with foundation & sunshade
Examine the condition of existing Instrument stand(s) with foundation & sunshade and repair the defects, if any.
 - Provide new Instrument stand(s) with foundation & sunshade
Design and construct the Instrument stand(s) with foundation & sunshade at suitable location. It should be designed to suitably accommodate the required number of instruments and explosion proof instrument field junction box.

- : Refurbishment of Existing Radio Building/Radio Equipment Room
 - Refurbishment of Radio Building
Examine the condition of the whole existing radio building and repair the defects if any. Clean and touch-up the external and internal finish of the whole existing radio building.
 - Refurbishment of Radio Equipment Room
Examine the condition of existing rooms where radio equipment and backup batteries are installed and repair the defects if any. Clean and touch-up the internal finish of the said rooms.
 - Cleaning of Radio Equipment Room
Clean and tidy up the existing rooms where radio equipment and backup batteries are installed.

- : Refurbishment of Rooms at Existing Control Center
 - Examine the condition of following existing rooms at Main/Auxiliary Control Center and repair the defects, if any:
 - Equipment Room (GF)
 - Battery Room (GF)
 - System Management Room (1F)Clean & touch-up the internal finish of these rooms.

5. Site Photo

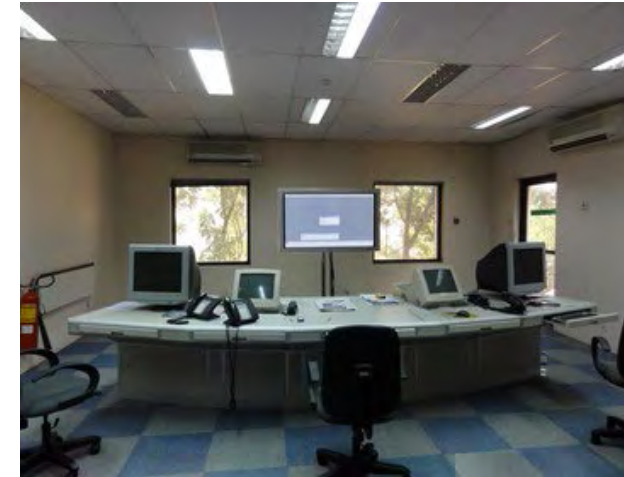


System Management Room



Radio Building

6. Site Layout

See attached Layout Plan.

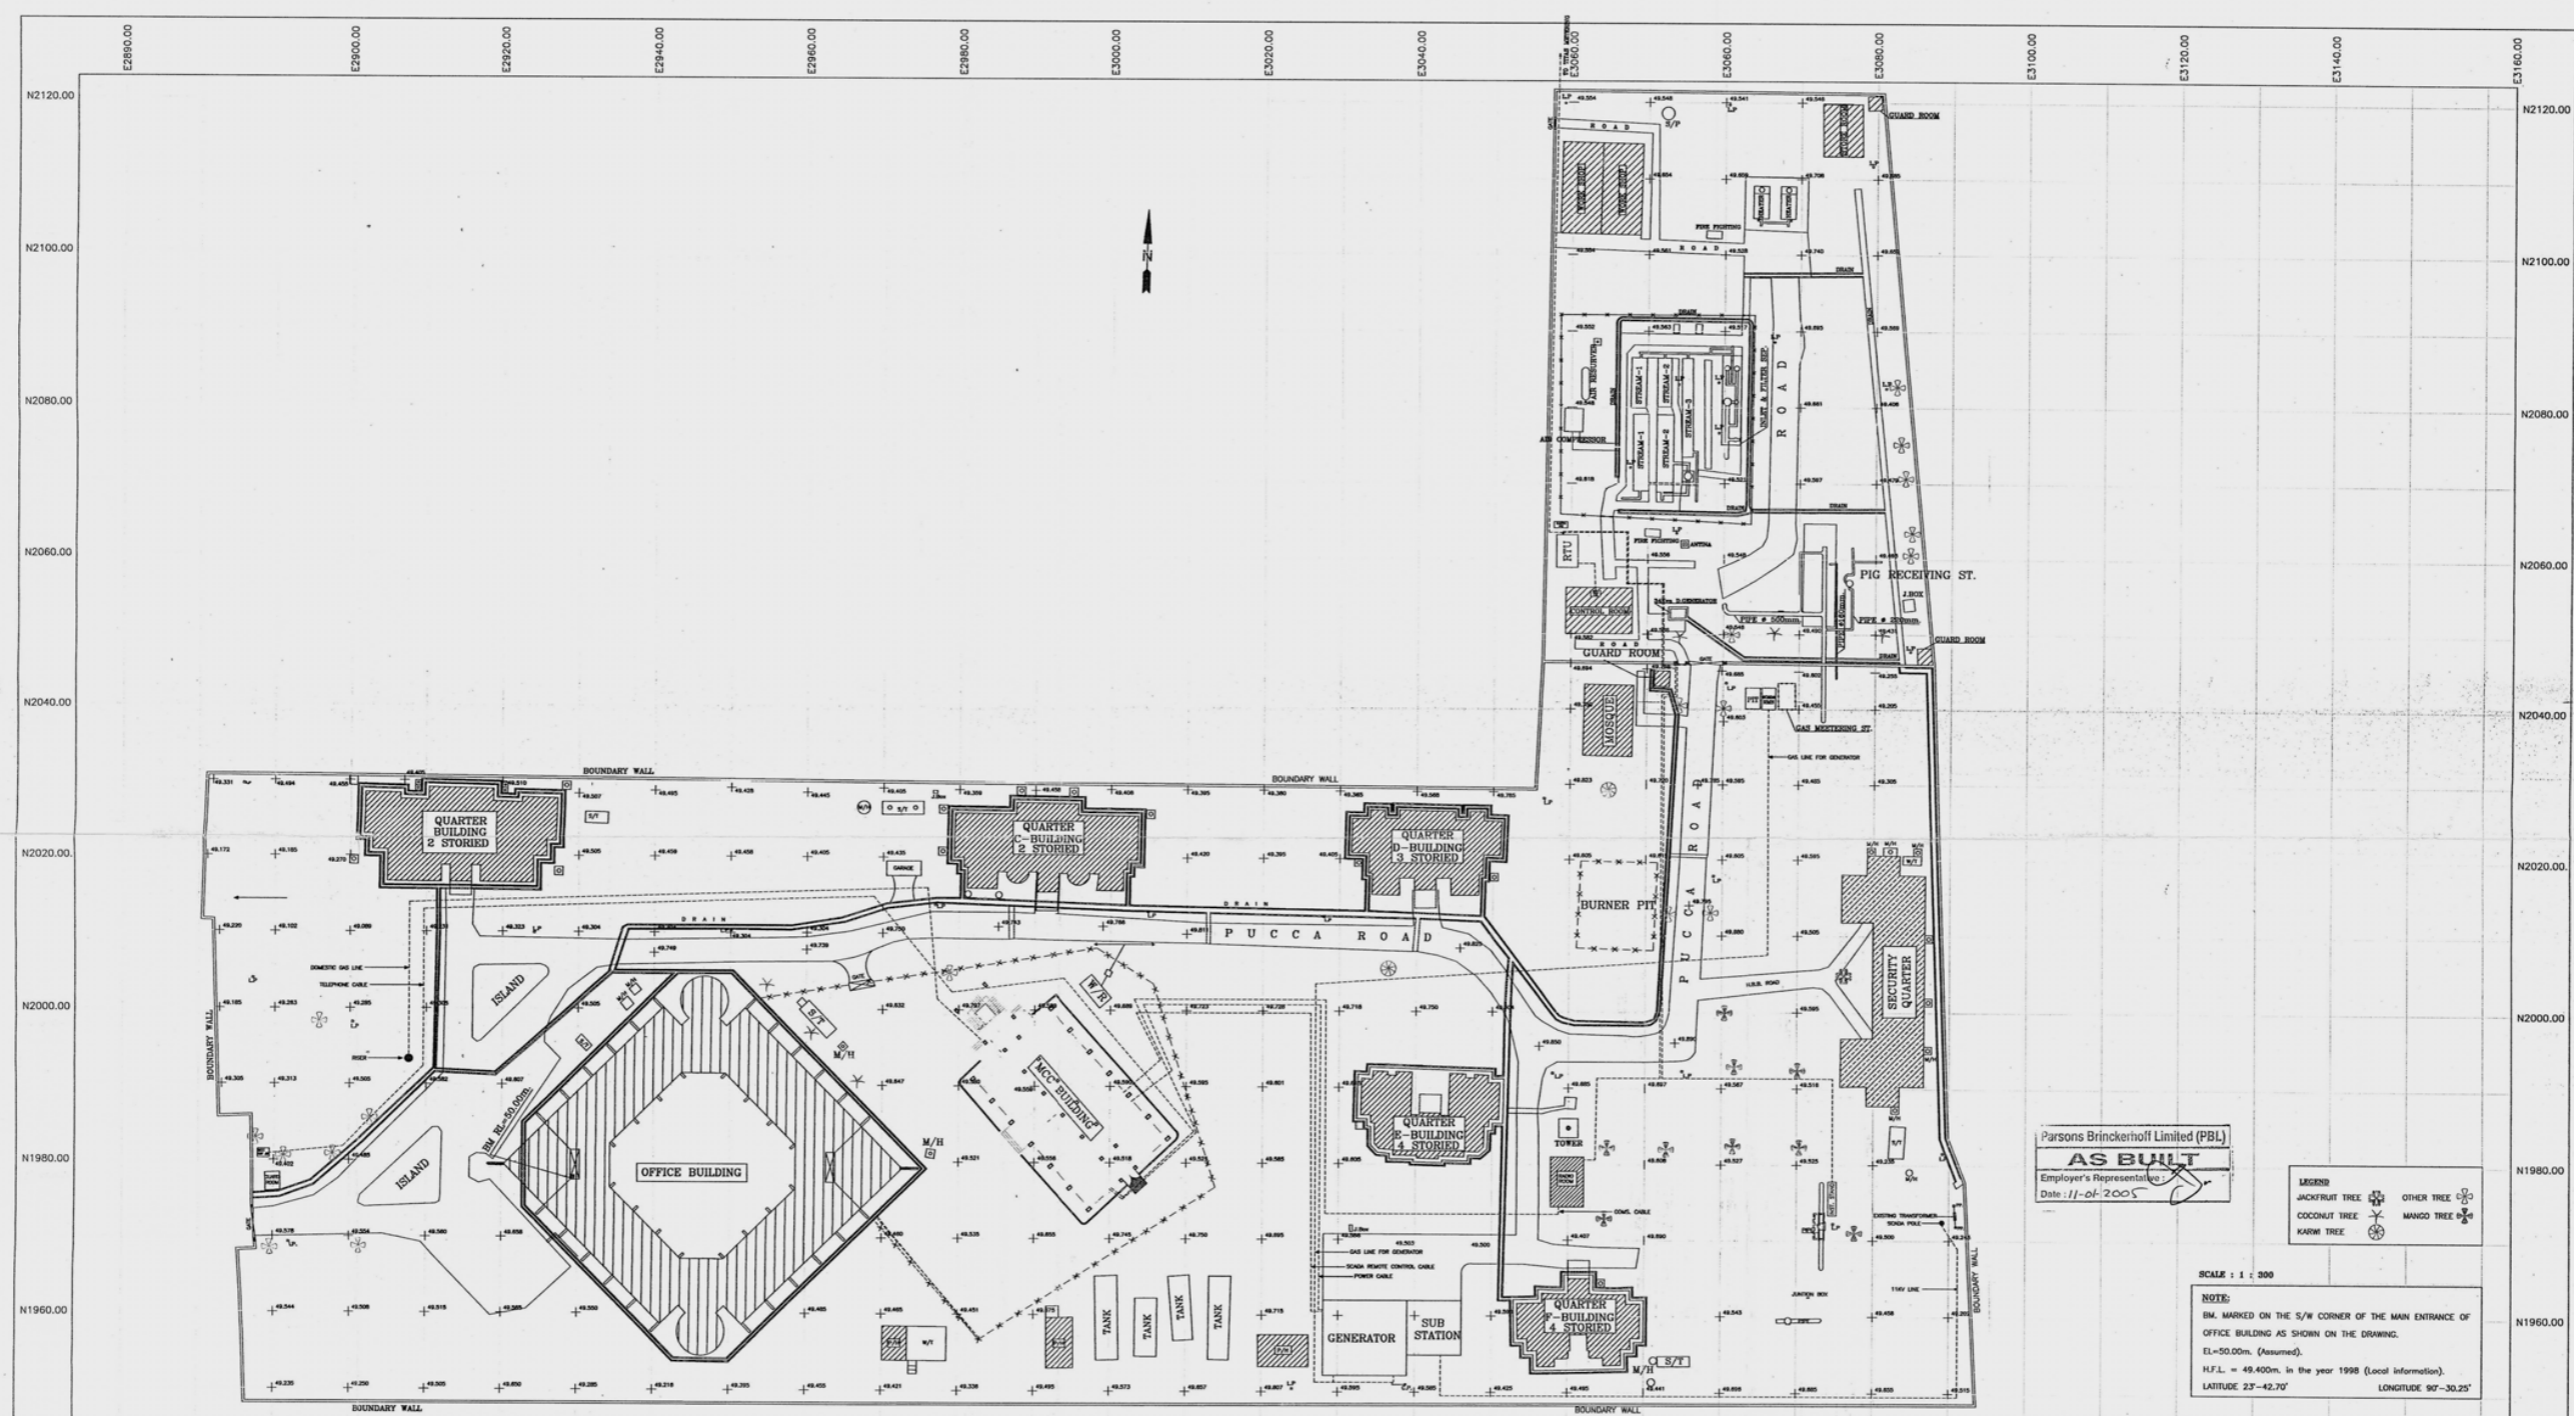

Parsons Brinckerhoff Limited (PBL)
AS BUILT
 Employer's Representative
 Date: 11-01-2005

LEGEND
 JACKFRUIT TREE OTHER TREE
 COCONUT TREE MANGO TREE
 KARIM TREE

SCALE : 1 : 300
NOTE
 BM. MARKED ON THE S/W CORNER OF THE MAIN ENTRANCE OF OFFICE BUILDING AS SHOWN ON THE DRAWING.
 EL = 50.00m. (Assumed).
 H.F.L. = 49.400m. in the year 1998 (Local Information).
 LATITUDE 23°-42'70" LONGITUDE 90°-30'25"

| ISSUE | Revision | Date | D/L Ref |
|-------|-----------------------------|----------|---------|
| A | ISSUED FOR DESIGN APPROVAL | 19.08.98 | - |
| B | REVISED FOR DESIGN APPROVAL | 26.07.04 | - |
| C | REVISED FOR DESIGN APPROVAL | 25.09.04 | - |

Contractor **CONTROLS LTD**

CONTRACT DRAWING APPROVAL
 Drawing Status: **DESIGN APPROVAL**

REDLINED CHANGES APPROVED NO CHANGES

PRINT NAME: _____
 SIGNED: _____ DATE: _____

Sub Contractor **SURVEY CORPORATION**

Drawing Title: **SITE CODE : 401, 109 & 138
 SITE NAME : DEMRA BAKHRABAD (MCC)**

Drawing No. **401-60-73**

| | | | | |
|------|----------|---------------|--------|-----------|
| BY | Drawn | Checked | Sheet | Dwg. Size |
| | MB | M. A. HADAYET | 4 of 2 | A1 |
| Date | 26.07.04 | 26.07.04 | | 27.07.04 |

S.D. No. _____ Employer **GAS TRANSMISSION COMPANY Ltd (GTCL)**

THE BANGLADESH GAS INFRASTRUCTURE DEVELOPMENT PROJECT. SUPERVISORY CONTROL, DATA ACQUISITION AND TELECOMMUNICATIONS SYSTEMS.

Consultant **PB Technologies Ltd.** Employer Contract No **GTCLR-1109/C2**

Site Information & Scope of Work

Site Information

Site Name : Sonargaon
Site Code : 30-DMR-101

Site Address : To be provided later.

Coordinates : N 23° 38' 23.2 " : E 90° 36' 08.1 "
* Coordinates are surveyed by handy type GPS and might be inaccurate.

Site Type

| | |
|---|--|
| <input type="checkbox"/> Control Center | <input type="checkbox"/> Master Telemetry Station |
| <input type="checkbox"/> Gas Field | <input type="checkbox"/> Operating Company Terminal (OCT) |
| <input type="checkbox"/> CGS (City Gas Station) | <input type="checkbox"/> Power station/Fertilizer Factory |
| <input type="checkbox"/> Compressor Station | <input checked="" type="checkbox"/> TBS (Town Bordering Station) |
| <input type="checkbox"/> Pig Station | <input type="checkbox"/> DRS (District Regulating Station) |
| <input type="checkbox"/> MS (Metering Station) | <input type="checkbox"/> GMS (Gas Manifold Station) |
| <input type="checkbox"/> VS (Valve Station) | |

Site Status

- Originally covered by The Existing System and shall be covered by The New System.
- Currently not covered by The Existing System but shall be covered by The New System.
- Upcoming site which will be covered by The New System after the completion of the Project.

Operating Company : BGSL

Remarks : _____

Scope of Work

Works checked off hereinafter shall be carried out for the Project

1. SCADA System

- : RTU
 - RTU without display monitor
Design, supply and install a self-standing IP65 enclosure equipped with following items:
 - RTU
 - Instrumentation and communication equipment
 - Backup battery system with charger for 24 hours
 - Lighting
 - Anti-condensation heater
 - Earthing and lightning protection
 - All internal wiring
 - Other equipment to satisfy the functional requirements
 - RTU with display monitor
Design, supply and install a self-standing IP65 enclosure equipped with following items:
 - RTU
 - Display monitor
 - Instrumentation and communication equipment
 - Backup battery system with charger for 24 hours
 - Lighting
 - Anti-condensation heater
 - Earthing and lightning protection
 - All internal wiring
 - Other equipment to satisfy the functional requirements
 - RTU (design & supply only)
Design and supply self-standing IP65 enclosure equipped with following items:
 - RTU
 - Instrumentation and communication equipment
 - Backup battery system with charger for 24 hours
 - Lighting
 - Anti-condensation heater
 - Earthing and lightning protection
 - All internal wiring
 - Other equipment to satisfy the functional requirements
 - Interface with flow computer
Make provision for:
 - Installation of the flow computer which shall be prepared by GTCL in the enclosure
 - Interface between RTU and the said flow computer
 - Interface with receiver for turbine meter
Install the existing receiver for turbine meter(s) in the RTU enclosure and interface it (them) via communication (MODBUS) cable.

- Interface with other system
Provide the interface between RTU and other system such as PLC or PC operated by the operating company including all communication cables between RTU and other system.

- Cable between RTU and Master Telemetry Station
Design, supply and install the cable between RTU and Master Telemetry Station in case RTU and Master Telemetry Station are located in the same site.

■ : Instruments

- Existing instruments
Re-use the existing instruments and cables.

Note:

Existing instruments and cables shall be serviced by the Employer.

- New Instruments
Design, supply and install the following instruments.
Output signals from instruments are to be cabled via field junction box to the RTU.

■ : Pressure transmitters Q'ty

- Design, supply and intall:
 - Pressure transmitter on the existing spare tapping point
 - Tubing between tapping point and transmitter
- Prepare the tapping point for the pressure transmitter, and design, supply and install:
 - Pressure transmitter on the prepared tapping point
 - Tubing between tapping point and transmitter

■ : Differential pressure transmitters Q'ty

- Design, supply and install:
 - Differential pressure transmitter on the existing spare tapping point
 - Tubing between tapping point and transmitter
- Prepare the tapping point for the differential pressure transmitter, and design, supply and install:
 - Differential pressure transmitter on the tapping point
 - Tubing between tapping point and transmitter

■ : Temprature transmitters Q'ty

- Design, supply and install:
 - Thermowell in the spare boss on the pipe
 - Resistance temperature detector complete with a head mounted transmitter into the thermowell

■ : Limit switch Q'ty

- Design, supply and install the limit switch on the existing shutdown valve for valve position monitoring.

- Pick up Signal from the Existing Turbine Meter Q'ty
Supply and install a dual pulse output pickup head in place of the single pulse output pickup in the existing turbine flowmeter sensor head. The output signal from the existing turbine flowmeter to be cabled via junction box to RTU.

- Local Field Instrument Junction Box Q'ty
Design, supply and install an Intrinsic safety junction box. The junction box to be suitable for glanding appropriate cables.

- Instrument Cables
Design, supply, install the instrument cables from the field instruments to RTU via junction box including each cable termination with gland.

2. Communication System

■ : Slave Telemetry System

- Removal of existing slave telemetry equipment
Remove and dispose the existing slave telemetry system including antenna and cable.
- Slave Telemetry Equipment
Design, supply and install new slave telemetry equipment in the RTU enclosure, including cables and antenna.
- Slave Telemetry Equipment (design & supply only)
Design and supply new slave telemetry equipment in the RTU enclosure, including cables and antenna.
- Existing monopole
Re-use existing monopole to mount new antenna.
- New monopole
Design, supply and install new monopole with foundation to mount new antenna.
- New monopole (design & supply only)
Design and supply new monopole to mount new antenna.

3. Electrical Works

■ : Power Supply to RTU

- Electrical power shall be supplied to RTU from existing PDB, and existing power cable shall be re-used.
- Design, supply and install MCB box for the power supply to RTU including all cables from existing PDB to MCB box and from MCB box to RTU.
- Design, supply and install power controller and power cable to RTU at remote site where electrical power is supplied from existing solar panel.
- Design, supply and install new solar panel, power controller and power cable to RTU.

4. Civil Works

■ : Foundation & Sunshade for RTU

- Re-use existing foundation & sunshade for RTU
Examine the condition of existing foundation and sunshade for RTU and repair the defects, if any.
- Provide new foundation & sunshade for RTU
Design and construct the foundation and sunshade for new RTU at suitable location. The foundation and sunshade should be designed to suitably accommodate new RTU.

■ : Instrument Stand with Foundation & Sunshade

- Re-use existing Instrument stand(s) with foundation & sunshade
Examine the condition of existing Instrument stand(s) with foundation & sunshade and repair the defects, if any.
- Provide new Instrument stand(s) with foundation & sunshade
Design and construct the Instrument stand(s) with foundation & sunshade at suitable location. It should be designed to suitably accommodate the required number of instruments and explosion proof instrument field junction box.

5. Site Photo




Site view



Existing RTU

6. Site Layout

See attached Layout Plan.

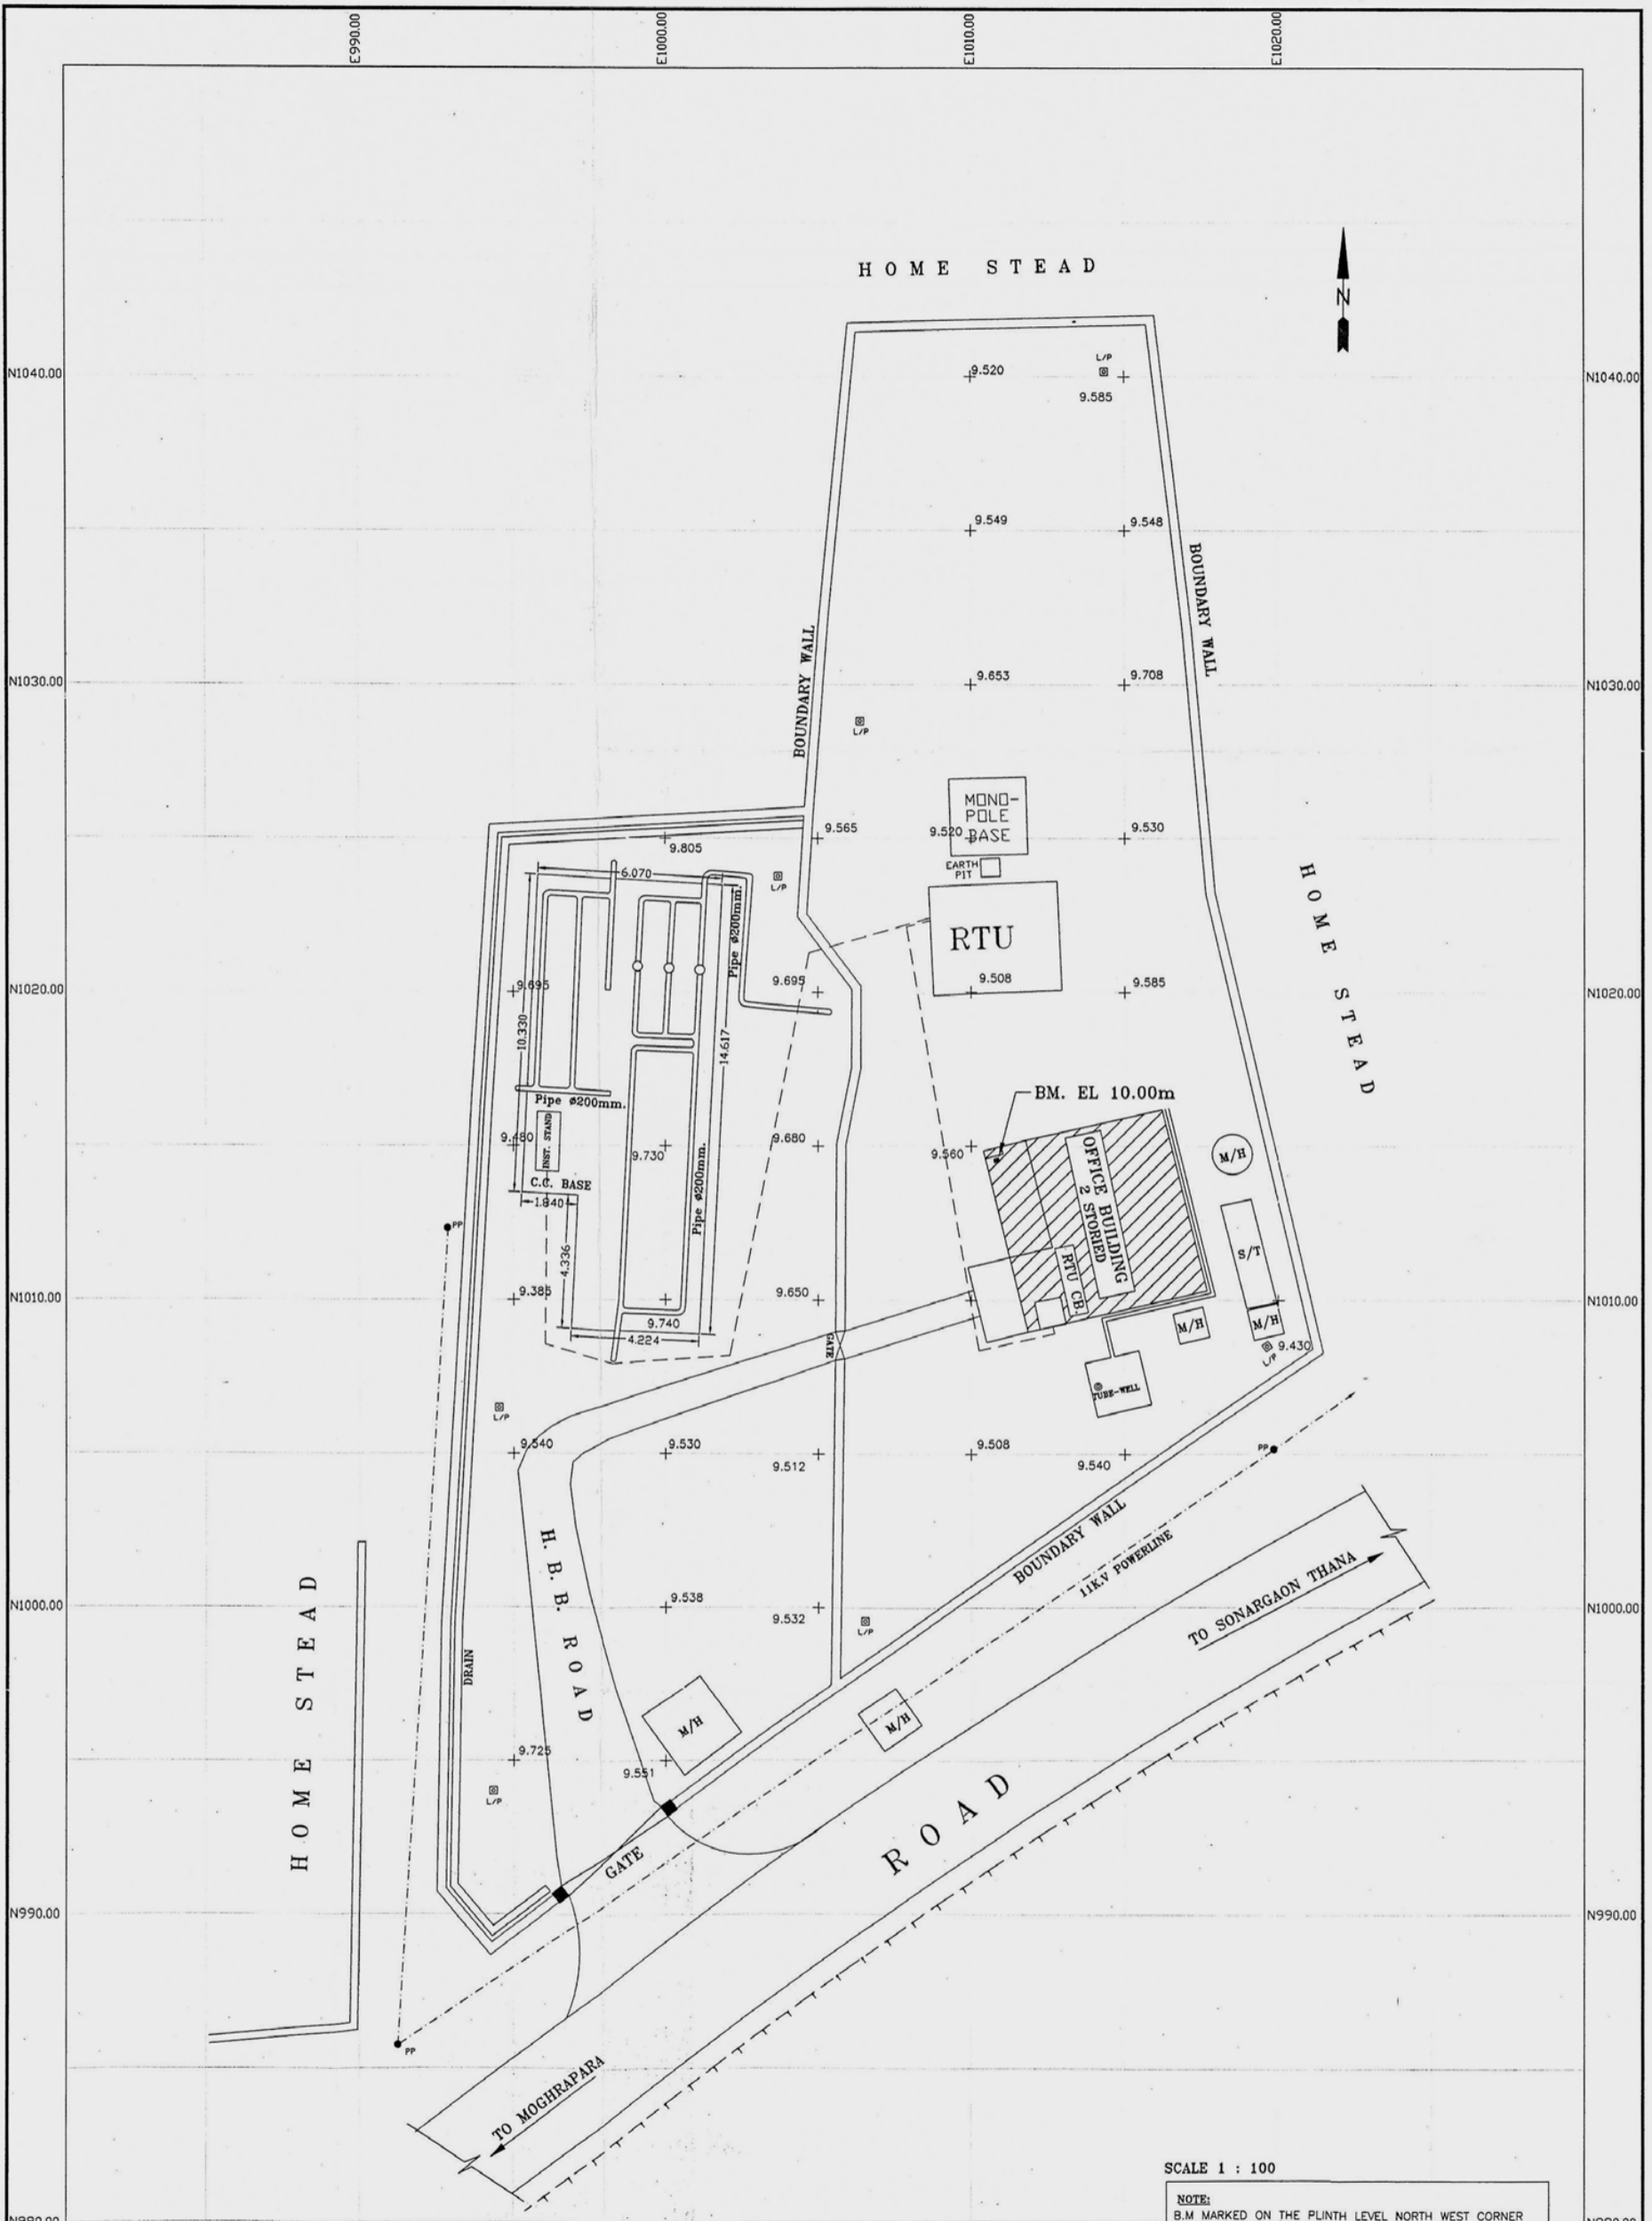

Parsons Brinckerhoff Limited (PBL)
AS BUILT
 Employer's Representative: *[Signature]*
 Date: 25-12-2004

SCALE 1 : 100
 NOTE:
 B.M MARKED ON THE PLINTH LEVEL NORTH WEST CORNER OF OFFICE BUILDINGS VERANDAH, AS SHOWN ON THE DRAWING EL 10.00m (Assumed).
 H.F.L.-9.878m IN THE YEAR 1998 (Local information)
 LATITUDE 23°-38.39 LONGITUDE 90°-36.14

| ISSUE | Revision | Date | D.O. Ref | Contractor | Sub Contractor | S.O. No. | Employer |
|-------|----------------------------|----------|----------|--------------|--------------------|----------|-------------------------------------|
| A | ISSUED FOR DESIGN APPROVAL | | | CONTROLS Ltd | SURVEY CORPORATION | | GAS TRANSMISSION COMPANY Ltd (GTCL) |
| B | ISSUED FOR DESIGN APPROVAL | 25-09-04 | | | | | |

| | | | | | |
|--|-----------------------------|---|--------------------------------------|--|---|
| CONTRACT DRAWING APPROVAL Drawing Status DESIGN APPROVAL | | Drawing Title SITE CODE : 107 SITE NAME : SONARGAON | | THE BANGLADESH GAS INFRASTRUCTURE DEVELOPMENT PROJECT. SUPERVISORY CONTROL, DATA ACQUISITION AND TELECOMMUNICATIONS SYSTEMS. | |
| Drawing No. 107-80-72 Rev Sheet Orig. Size A1 | Drawn HASHEM 26-04-99 | Checked M.A. HAYAT 26-04-99 | Approved M.A. HADAYET 26-04-99 | Consultant PB Technologies Ltd. | Employer Contract No GTCL/RL-1109/C2 |

Site Information & Scope of Work

Site Information

Site Name : Dewanbagh
Site Code : 30-DMR-102

Site Address : To be provided later.

Coordinates : N 23° 41' 33.9 " : E 90° 32' 31.2 "
* Coordinates are surveyed by handy type GPS and might be inaccurate.

Site Type

| | |
|---|--|
| <input type="checkbox"/> Control Center | <input type="checkbox"/> Master Telemetry Station |
| <input type="checkbox"/> Gas Field | <input type="checkbox"/> Operating Company Terminal (OCT) |
| <input type="checkbox"/> CGS (City Gas Station) | <input type="checkbox"/> Power station/Fertilizer Factory |
| <input type="checkbox"/> Compressor Station | <input checked="" type="checkbox"/> TBS (Town Bordering Station) |
| <input type="checkbox"/> Pig Station | <input type="checkbox"/> DRS (District Regulating Station) |
| <input type="checkbox"/> MS (Metering Station) | <input type="checkbox"/> GMS (Gas Manifold Station) |
| <input type="checkbox"/> VS (Valve Station) | |

Site Status

- Originally covered by The Existing System and shall be covered by The New System.
- Currently not covered by The Existing System but shall be covered by The New System.
- Upcoming site which will be covered by The New System after the completion of the Project.

Operating Company : BGSL

Remarks : _____

Scope of Work

Works checked off hereinafter shall be carried out for the Project

1. SCADA System

- : RTU
 - RTU without display monitor
Design, supply and install a self-standing IP65 enclosure equipped with following items:
 - RTU
 - Instrumentation and communication equipment
 - Backup battery system with charger for 24 hours
 - Lighting
 - Anti-condensation heater
 - Earthing and lightning protection
 - All internal wiring
 - Other equipment to satisfy the functional requirements
 - RTU with display monitor
Design, supply and install a self-standing IP65 enclosure equipped with following items:
 - RTU
 - Display monitor
 - Instrumentation and communication equipment
 - Backup battery system with charger for 24 hours
 - Lighting
 - Anti-condensation heater
 - Earthing and lightning protection
 - All internal wiring
 - Other equipment to satisfy the functional requirements
 - RTU (design & supply only)
Design and supply self-standing IP65 enclosure equipped with following items:
 - RTU
 - Instrumentation and communication equipment
 - Backup battery system with charger for 24 hours
 - Lighting
 - Anti-condensation heater
 - Earthing and lightning protection
 - All internal wiring
 - Other equipment to satisfy the functional requirements
 - Interface with flow computer
Make provision for:
 - Installation of the flow computer which shall be prepared by GTCL in the enclosure
 - Interface between RTU and the said flow computer
 - Interface with receiver for turbine meter
Install the existing receiver for turbine meter(s) in the RTU enclosure and interface it (them) via communication (MODBUS) cable.

- Interface with other system
Provide the interface between RTU and other system such as PLC or PC operated by the operating company including all communication cables between RTU and other system.

- Cable between RTU and Master Telemetry Station
Design, supply and install the cable between RTU and Master Telemetry Station in case RTU and Master Telemetry Station are located in the same site.

■ : Instruments

- Existing instruments
Re-use the existing instruments and cables.

Note:

Existing instruments and cables shall be serviced by the Employer.

- New Instruments
Design, supply and install the following instruments.
Output signals from instruments are to be cabled via field junction box to the RTU.

■ : Pressure transmitters Q'ty

- Design, supply and intall:
 - Pressure transmitter on the existing spare tapping point
 - Tubing between tapping point and transmitter

- Prepare the tapping point for the pressure transmitter, and design, supply and install:
 - Pressure transmitter on the prepared tapping point
 - Tubing between tapping point and transmitter

■ : Differential pressure transmitters Q'ty

- Design, supply and install:
 - Differential pressure transmitter on the existing spare tapping point
 - Tubing between tapping point and transmitter

- Prepare the tapping point for the differential pressure transmitter, and design, supply and install:
 - Differential pressure transmitter on the tapping point
 - Tubing between tapping point and transmitter

■ : Temprature transmitters Q'ty

- Design, supply and install:
 - Thermowell in the spare boss on the pipe
 - Resistance temperature detector complete with a head mounted transmitter into the thermowell

■ : Limit switch Q'ty

- Design, supply and install the limit switch on the existing shutdown valve for valve position monitoring.

- Pick up Signal from the Existing Turbine Meter Q'ty
Supply and install a dual pulse output pickup head in place of the single pulse output pickup in the existing turbine flowmeter sensor head. The output signal from the existing turbine flowmeter to be cabled via junction box to RTU.

- Local Field Instrument Junction Box Q'ty
Design, supply and install an Intrinsic safety junction box. The junction box to be suitable for glanding appropriate cables.

- Instrument Cables
Design, supply, install the instrument cables from the field instruments to RTU via junction box including each cable termination with gland.

2. Communication System

■ : Slave Telemetry System

- Removal of existing slave telemetry equipment
Remove and dispose the existing slave telemetry system including antenna and cable.
- Slave Telemetry Equipment
Design, supply and install new slave telemetry equipment in the RTU enclosure, including cables and antenna.
- Slave Telemetry Equipment (design & supply only)
Design and supply new slave telemetry equipment in the RTU enclosure, including cables and antenna.
- Existing monopole
Re-use existing monopole to mount new antenna.
- New monopole
Design, supply and install new monopole with foundation to mount new antenna.
- New monopole (design & supply only)
Design and supply new monopole to mount new antenna.

3. Electrical Works

■ : Power Supply to RTU

- Electrical power shall be supplied to RTU from existing PDB, and existing power cable shall be re-used.
- Design, supply and install MCB box for the power supply to RTU including all cables from existing PDB to MCB box and from MCB box to RTU.
- Design, supply and install power controller and power cable to RTU at remote site where electrical power is supplied from existing solar panel.
- Design, supply and install new solar panel, power controller and power cable to RTU.

4. Civil Works

■ : Foundation & Sunshade for RTU

- Re-use existing foundation & sunshade for RTU
Examine the condition of existing foundation and sunshade for RTU and repair the defects, if any.
- Provide new foundation & sunshade for RTU
Design and construct the foundation and sunshade for new RTU at suitable location. The foundation and sunshade should be designed to suitably accommodate new RTU.

■ : Instrument Stand with Foundation & Sunshade

- Re-use existing Instrument stand(s) with foundation & sunshade
Examine the condition of existing Instrument stand(s) with foundation & sunshade and repair the defects, if any.
- Provide new Instrument stand(s) with foundation & sunshade
Design and construct the Instrument stand(s) with foundation & sunshade at suitable location. It should be designed to suitably accommodate the required number of instruments and explosion proof instrument field junction box.

5. Site Photo




Existing RTU



Existing Instrument Stand

6. Site Layout

See attached Layout Plan.

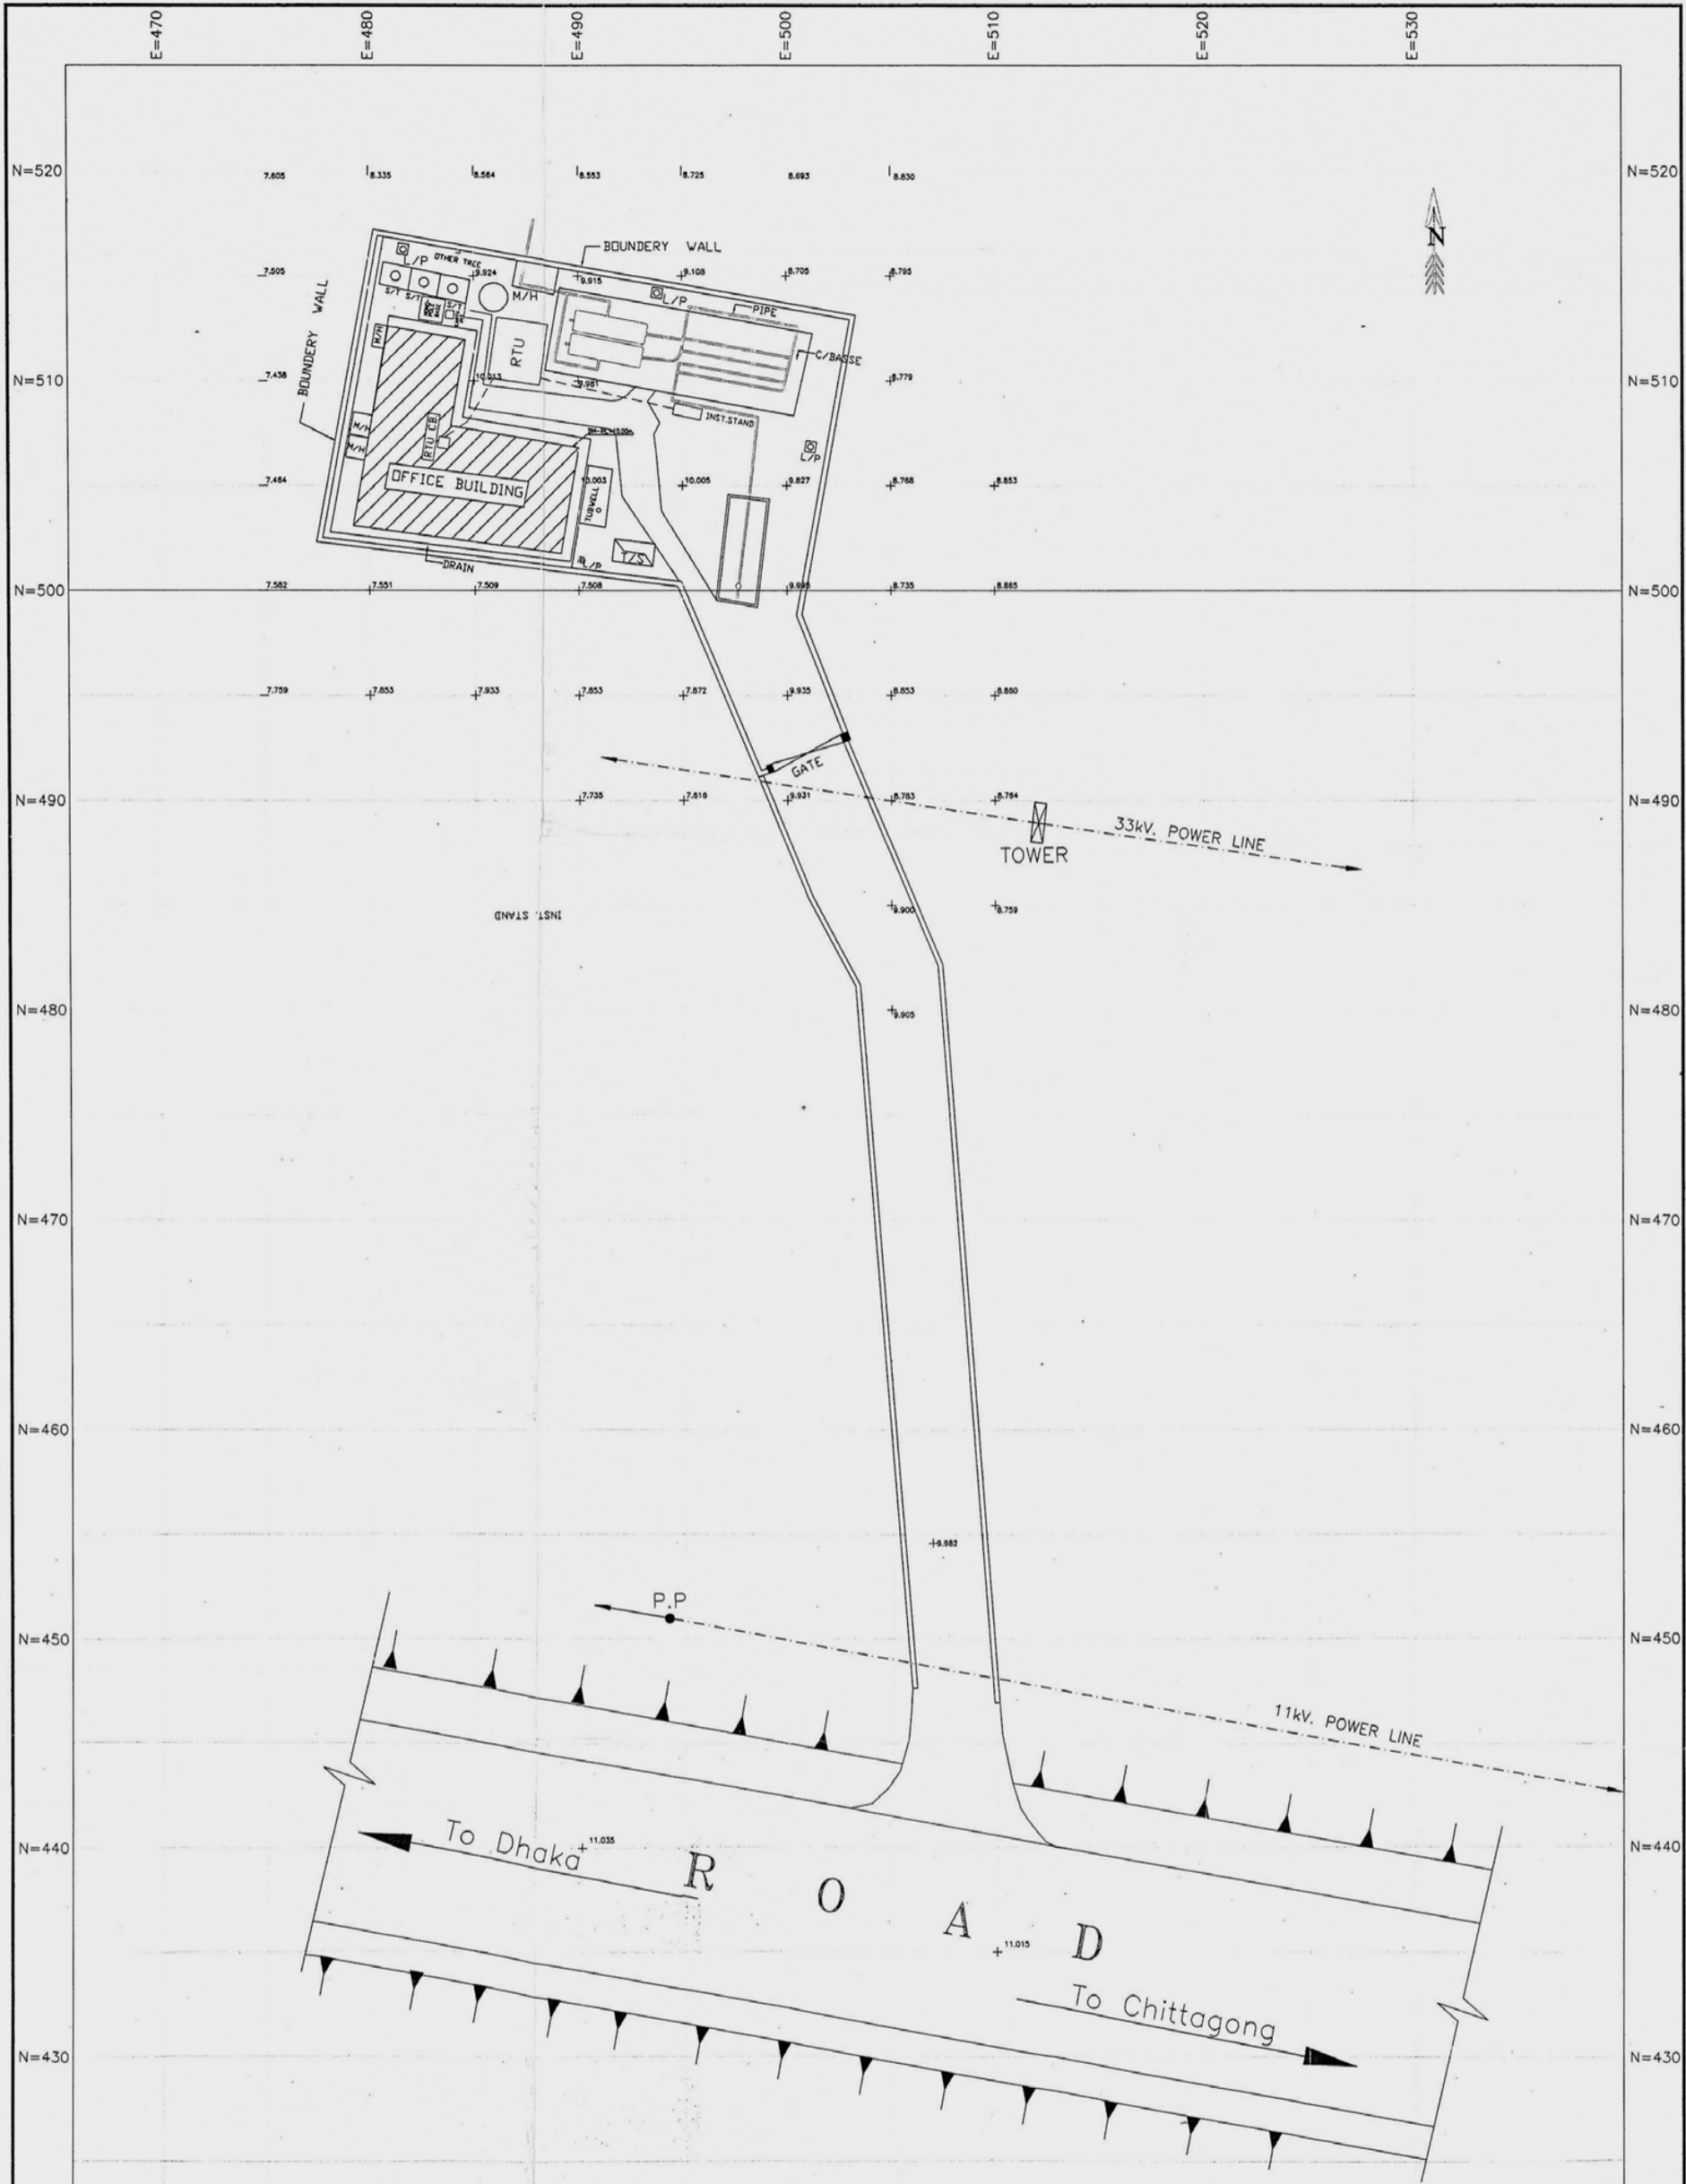

Parsons Brinckerhoff Limited (PBL)
AS BUILT
 Employer's Representative:
 Date: 06-12-2009

SCALE 1 : 150

NOTE:
 B.M MARKED ON THE PLINTH LEVEL NORTH EAST CORNER SIDE OF OFFICE BUILDING'S. AS SHOWN ON THE DRAWING.
 EL=10.00m (Assumed)
 H.F.L. =10.21m. in the year 1998 (Local information)
 Loti. 23°-14.55' Long. 90°-32.55'

| ISSUE | Revision | Date | D.D. Ref | Contractor | Sub Contractor | S.D. No. | Employer |
|-------|----------------------------|----------|----------|--------------|--------------------|----------|-------------------------------------|
| A | ISSUED FOR DESIGN APPROVAL | | | CONTROLS Ltd | SURVEY CORPORATION | | GAS TRANSMISSION COMPANY Ltd (GTCL) |
| A | ISSUED FOR DESIGN APPROVAL | 25-09-04 | | | | | |

| | | | | | |
|---|---|--|--|--|--|
| CONTRACT DRAWING APPROVAL Drawing Status: DESIGN APPROVAL <input type="checkbox"/> REQUINED CHANGES <input type="checkbox"/> APPROVED NO CHANGES | | Drawing Title: SITE CODE : 108 SITE NAME : DEWANBAG | | THE BANGLADESH GAS INFRASTRUCTURE DEVELOPMENT PROJECT. SUPERVISORY CONTROL, DATA ACQUISITION AND TELECOMMUNICATIONS SYSTEMS. | |
| Drawing No. 108-60-72 Rev: _____ Sheet: _____ Orig. Size: A1 | Drawn: _____ Checked: _____ Approved: _____ | Consultant: PB Technologies Ltd. | | Employer Contract No: GTCL/RL-1109/C2 | |

Site Information & Scope of Work

Site Information

Site Name : VS7 BKB-Demra
Site Code : 30-DMR-103

Site Address : To be provided later.

Coordinates : N 23° 42' 38.6 " : E 90° 31' 27.2 "
* Coordinates are surveyed by handy type GPS and might be inaccurate.

Site Type

| | |
|--|--|
| <input type="checkbox"/> Control Center | <input type="checkbox"/> Master Telemetry Station |
| <input type="checkbox"/> Gas Field | <input type="checkbox"/> Operating Company Terminal (OCT) |
| <input type="checkbox"/> CGS (City Gas Station) | <input type="checkbox"/> Power station/Fertilizer Factory |
| <input type="checkbox"/> Compressor Station | <input type="checkbox"/> TBS (Town Bordering Station) |
| <input type="checkbox"/> Pig Station | <input type="checkbox"/> DRS (District Regulating Station) |
| <input type="checkbox"/> MS (Metering Station) | <input type="checkbox"/> GMS (Gas Manifold Station) |
| <input checked="" type="checkbox"/> VS (Valve Station) | |

Site Status

- Originally covered by The Existing System and shall be covered by The New System.
- Currently not covered by The Existing System but shall be covered by The New System.
- Upcoming site which will be covered by The New System after the completion of the Project.

Operating Company : BGSL

Remarks : _____

Scope of Work

Works checked off hereinafter shall be carried out for the Project

1. SCADA System

- : RTU
 - RTU without display monitor
Design, supply and install a self-standing IP65 enclosure equipped with following items:
 - RTU
 - Instrumentation and communication equipment
 - Backup battery system with charger for 24 hours
 - Lighting
 - Anti-condensation heater
 - Earthing and lightning protection
 - All internal wiring
 - Other equipment to satisfy the functional requirements
 - RTU with display monitor
Design, supply and install a self-standing IP65 enclosure equipped with following items:
 - RTU
 - Display monitor
 - Instrumentation and communication equipment
 - Backup battery system with charger for 24 hours
 - Lighting
 - Anti-condensation heater
 - Earthing and lightning protection
 - All internal wiring
 - Other equipment to satisfy the functional requirements
 - RTU (design & supply only)
Design and supply self-standing IP65 enclosure equipped with following items:
 - RTU
 - Instrumentation and communication equipment
 - Backup battery system with charger for 24 hours
 - Lighting
 - Anti-condensation heater
 - Earthing and lightning protection
 - All internal wiring
 - Other equipment to satisfy the functional requirements
 - Interface with flow computer
Make provision for:
 - Installation of the flow computer which shall be prepared by GTCL in the enclosure
 - Interface between RTU and the said flow computer
 - Interface with receiver for turbine meter
Install the existing receiver for turbine meter(s) in the RTU enclosure and interface it (them) via communication (MODBUS) cable.

- Interface with other system
Provide the interface between RTU and other system such as PLC or PC operated by the operating company including all communication cables between RTU and other system.

- Cable between RTU and Master Telemetry Station
Design, supply and install the cable between RTU and Master Telemetry Station in case RTU and Master Telemetry Station are located in the same site.

■ : Instruments

- Existing instruments
Re-use the existing instruments and cables.

Note:

Existing instruments and cables shall be serviced by the Employer.

- New Instruments
Design, supply and install the following instruments.
Output signals from instruments are to be cabled via field junction box to the RTU.

■ : Pressure transmitters Q'ty

- Design, supply and intall:
 - Pressure transmitter on the existing spare tapping point
 - Tubing between tapping point and transmitter
- Prepare the tapping point for the pressure transmitter, and design, supply and install:
 - Pressure transmitter on the prepared tapping point
 - Tubing between tapping point and transmitter

■ : Differential pressure transmitters Q'ty

- Design, supply and install:
 - Differential pressure transmitter on the existing spare tapping point
 - Tubing between tapping point and transmitter
- Prepare the tapping point for the differential pressure transmitter, and design, supply and install:
 - Differential pressure transmitter on the tapping point
 - Tubing between tapping point and transmitter

■ : Temprature transmitters Q'ty

- Design, supply and install:
 - Thermowell in the spare boss on the pipe
 - Resistance temperature detector complete with a head mounted transmitter into the thermowell

■ : Limit switch Q'ty

- Design, supply and install the limit switch on the existing shutdown valve for valve position monitoring.

- Pick up Signal from the Existing Turbine Meter Q'ty
Supply and install a dual pulse output pickup head in place of the single pulse output pickup in the existing turbine flowmeter sensor head. The output signal from the existing turbine flowmeter to be cabled via junction box to RTU.

- Local Field Instrument Junction Box Q'ty
Design, supply and install an Intrinsic safety junction box. The junction box to be suitable for glanding appropriate cables.

- Instrument Cables
Design, supply, install the instrument cables from the field instruments to RTU via junction box including each cable termination with gland.

2. Communication System

■ : Slave Telemetry System

- Removal of existing slave telemetry equipment
Remove and dispose the existing slave telemetry system including antenna and cable.
- Slave Telemetry Equipment
Design, supply and install new slave telemetry equipment in the RTU enclosure, including cables and antenna.
- Slave Telemetry Equipment (design & supply only)
Design and supply new slave telemetry equipment in the RTU enclosure, including cables and antenna.
- Existing monopole
Re-use existing monopole to mount new antenna.
- New monopole
Design, supply and install new monopole with foundation to mount new antenna.
- New monopole (design & supply only)
Design and supply new monopole to mount new antenna.

3. Electrical Works

■ : Power Supply to RTU

- Electrical power shall be supplied to RTU from existing PDB, and existing power cable shall be re-used.
- Design, supply and install MCB box for the power supply to RTU including all cables from existing PDB to MCB box and from MCB box to RTU.
- Design, supply and install power controller and power cable to RTU at remote site where electrical power is supplied from existing solar panel.
- Design, supply and install new solar panel, power controller and power cable to RTU.

4. Civil Works

■ : Foundation & Sunshade for RTU

- Re-use existing foundation & sunshade for RTU
Examine the condition of existing foundation and sunshade for RTU and repair the defects, if any.
- Provide new foundation & sunshade for RTU
Design and construct the foundation and sunshade for new RTU at suitable location. The foundation and sunshade should be designed to suitably accommodate new RTU.

■ : Instrument Stand with Foundation & Sunshade

- Re-use existing Instrument stand(s) with foundation & sunshade
Examine the condition of existing Instrument stand(s) with foundation & sunshade and repair the defects, if any.
- Provide new Instrument stand(s) with foundation & sunshade
Design and construct the Instrument stand(s) with foundation & sunshade at suitable location. It should be designed to suitably accommodate the required number of instruments and explosion proof instrument field junction box.

5. Site Photo




Site view



Existing Instrument Stand

6. Site Layout

See attached Layout Plan.

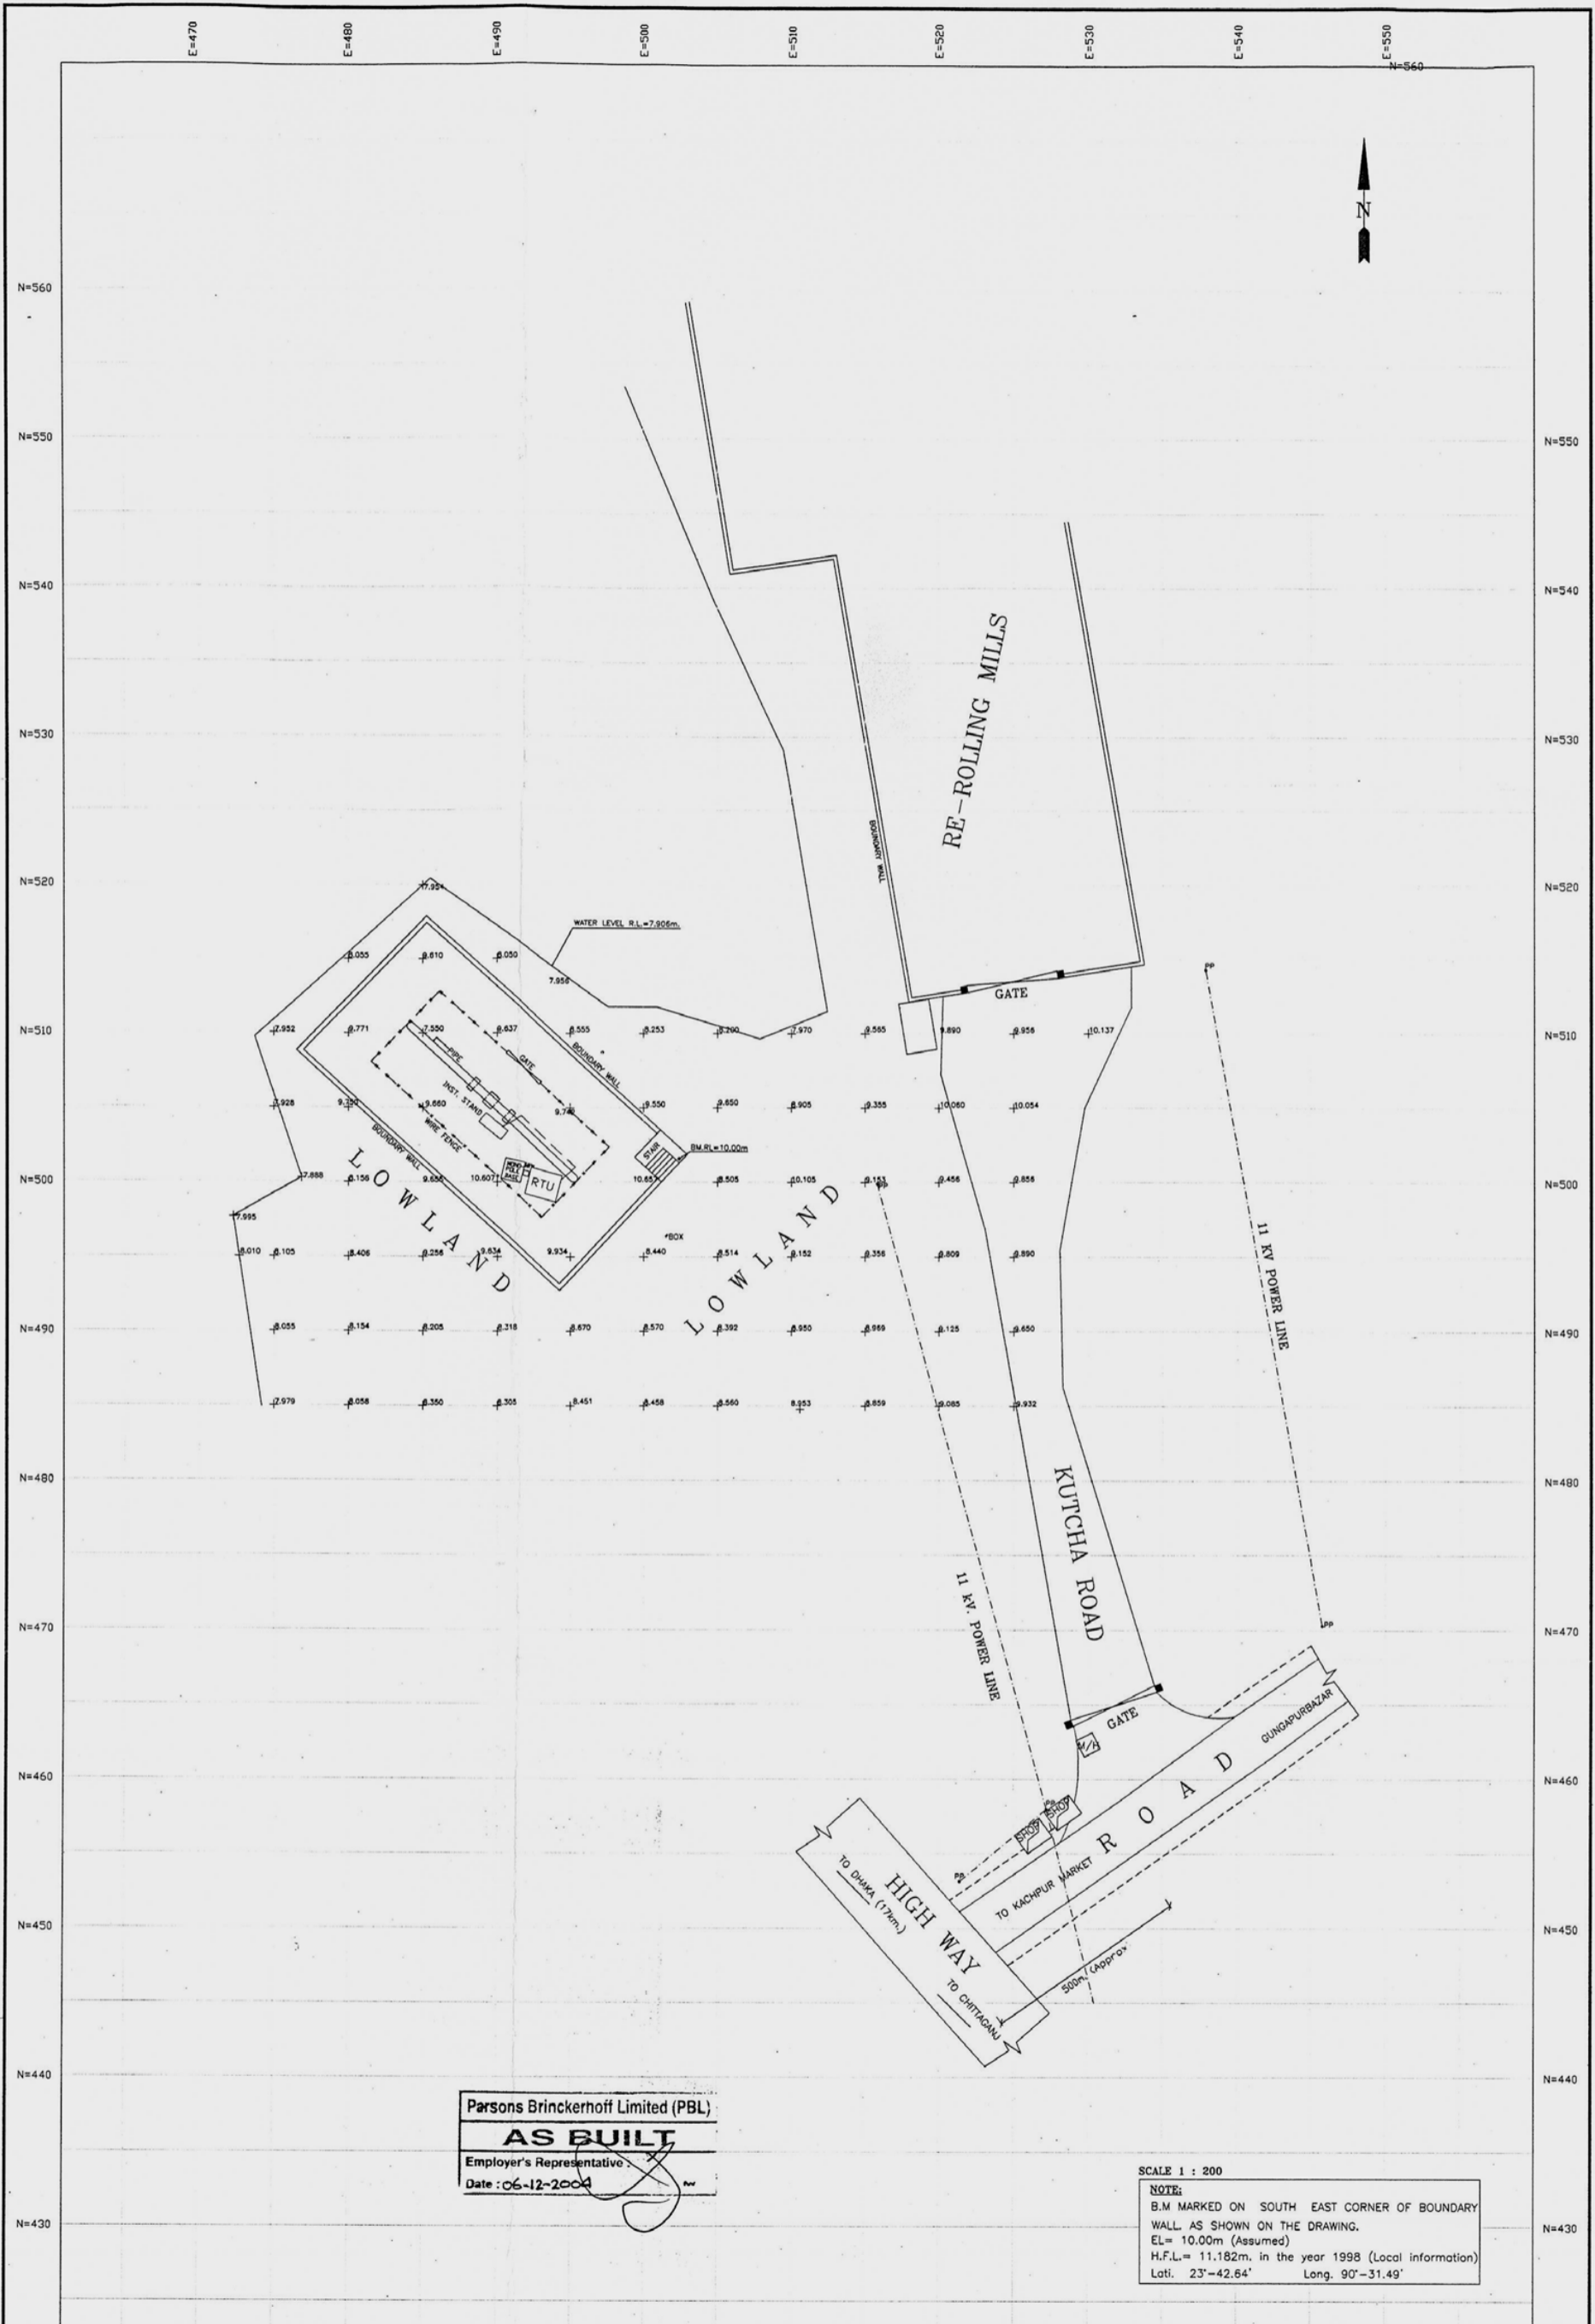

Parsons Brinckerhoff Limited (PBL)
AS BUILT
 Employer's Representative
 Date : 06-12-2004

SCALE 1 : 200
 NOTE:
 B.M MARKED ON SOUTH EAST CORNER OF BOUNDARY WALL AS SHOWN ON THE DRAWING.
 EL= 10.00m (Assumed)
 H.F.L= 11.182m, in the year 1998 (Local information)
 Lat. 23°-42.64' Long. 90°-31.49'

| ISSUE | Revision | Date | D.D. Ref | Contractor | Sub Contractor | S.D. No. | Employer |
|---|----------------------------|----------|----------|---|--------------------|--|-------------------------------------|
| A | ISSUED FOR DESIGN APPROVAL | | | CONTROLS Ltd | SURVEY CORPORATION | | GAS TRANSMISSION COMPANY Ltd (GTCL) |
| B | ISSUED FOR DESIGN APPROVAL | 25-09-04 | | | | | |
| CONTRACT DRAWING APPROVAL Drawing Status: DESIGN APPROVAL <input type="checkbox"/> REDUCED CHANGES <input type="checkbox"/> APPROVED NO CHANGES | | | | Drawing Title: SITE CODE : 126 SITE NAME : VS 7 BKB-DEMRA | | THE BANGLADESH GAS INFRASTRUCTURE DEVELOPMENT PROJECT. SUPERVISORY CONTROL, DATA ACQUISITION AND TELECOMMUNICATIONS SYSTEMS. | |
| PRINT NAME: _____ SIGNED: _____ DATE: _____ | | | | Drawing No. 126-60-72 Rev: _____ Sheet: _____ Orig. Size: A1 | | Consultant: PB Technologies Ltd. Employer Contract No: GTCL/RL-1109/C2 | |